IREDELL COUNTY HEALTH DEPARTMENT

STATESVILLE 704-878-5305 130.00 Paid MOORESVILLE 704-664-5281

IMPROVEMENT PERMIT / AUTHORIZATION TO CONSTRUCT / OPERATION PERMIT / EXISTING SYSTEM INSPECTION

PERMIT# 112633 PIN# ~~4748-20-9265-S~~ 4748-30-8405 DATE June 3, 03

OWNER OR CONTRACTOR Dixie Land Inc PHONE: Business _____ Home _____

ADDRESS 823 Jennings Rd, Statesville N.C. 28625

LOCATION From Statesville, 21 N. to Jennings Rd. ~ 2½ miles on left

SUBDIVISION DEER CROSSING BLOCK / SECTION 1 LOT 5 LOT AREA .05 Ac SITE CLASS. PS DESIGN FLOW 360 gpd L.T.A.R. .25-.3

Septic Tank: 1000 Gallons; STB 825 Date 3-3-03
Pump Tank: _____ Gallons; PT _____ Date _____
Pump Make: _____ Model _____ Serial No. _____
Nitrification Field: No Fields 1 Square Feet 960 Linear Feet 320
No Lines 4-5 Trench Width 36" Max Trench Bottom Depth 36" Gravel Depth NA

☑ New System ☐ Repair System Type: I, II, III, IV, V, VI
System Description: Gravity 25% Reduction
Repair System Description: LPP/PU PPBPS (50% Red)
Maintenance Agreement Required: ☐ Yes ☑ No

☑ House/Mod. Home No. Bedrooms 3
☐ Mobile Home No. Bathrooms 2
☐ Business No. Employees _____
☐ Other _____
☐ Slab ☑ Crawl Space ☐ Basement w/plumbing ☐ Basement wo/plumbing


Water Supply: ☐ Individual ☑ Public ☐ Community

Comments:/Conditions:

Comments:/Conditions: SEPTIC TANK WITH MARKER INSTALLED USING "ZABEL" FILTER

1"=50'

INITIAL SITE SKETCH

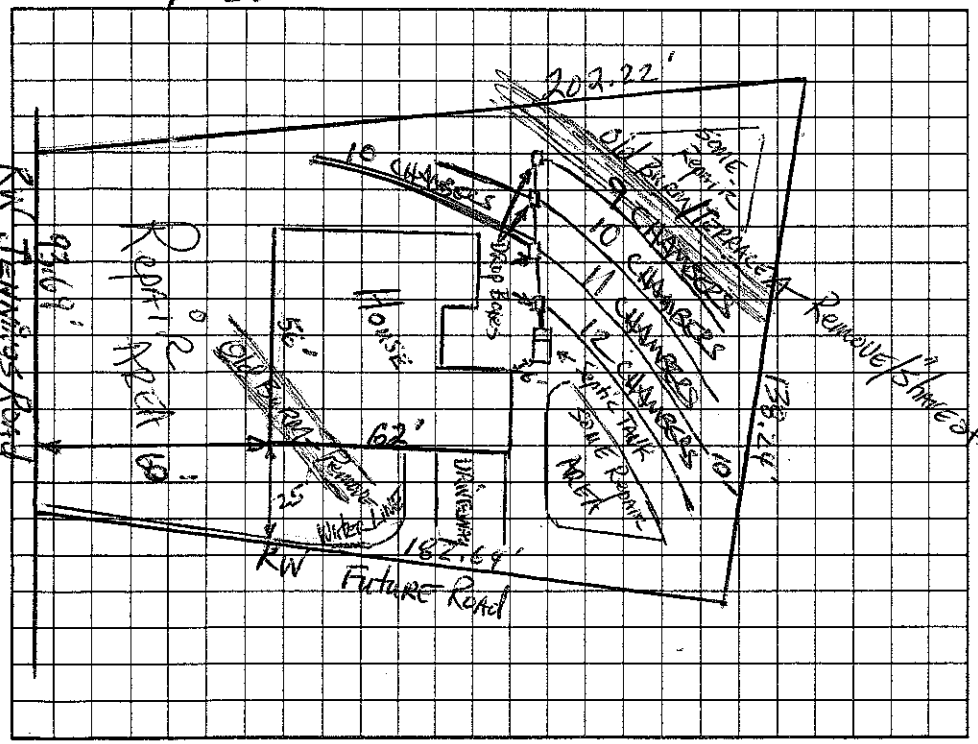

AS BUILT SKETCH

SYSTEM INSTALLED ACCORDING TO INITAL SITES SKETCH

Permit can be suspended or revoked if any false information is supplied toward securing the permit/any unauthorized changes are made to the site/any unauthorized changes are made in the installation of the system. Improvement Permit with plat valid without expiration. Improvement Permit with site plan valid for sixty months. Authorization to Construct is valid for a period equal to that of Improvement Permit – not to exceed sixty months.

Signed: Faye Garrison Agent for RK Cecil date 6-10-03
Improvement Permit by: _____ date 6-3-03
Authorization to Construct by: _____ date 6-3-03

Installed by: ROWAN SEPTIC
Operation Permit by: STEVE HEDRICK date 9-4-03
Existing System Inspection by: _____ date _____

HEALTH DEPT. COPY: WHITE OWNER COPY (FINAL): YELLOW OWNER COPY (INITIAL): PINK