IREDELL COUNTY HEALTH DEPARTMENT

Jane H. Gooden

48690

STATESVILLE 704-878-5305 MOORESVILLE 704-664-5281

IMPROVEMENT PERMIT / CERTIFICATE OF COMPLETION / OPERATION PERMIT / EXISTING SYSTEM INSPECTION

PROPERTY DESCRIPTION NO. 16967 DATE 9/9/93 TAX MAP NO. 10L-A-11

OWNER OR CONTRACTOR CARL HEDRICK PHONE: Business Home 876-0095

ADDRESS Rt. 5 Box 98-A, STVL, NC 28677

LOCATION US 21 N, TL JENNINGS RD, MH on (L) ~2000' BEFORE S. YADKIN RIVER

SUBDIVISION BLOCK / SECTION LOT LOT AREA .66 ACRES SITE CLASS. PS L.T.A.R. 0.35 GPD/FT²

Water Supply: ☑ Individual ☐ Community ☐ Public WELL

Septic Tank: 1000 Gallons: STB 358 Date 8-20-93

Pump Tank: Gallons: PT Date

Nitrification Field: No Fields 1 Square Feet 1035 Linear Feet 345

No Lines 4 Trench Width 36" Trench Depth 18-36" Gravel Depth 12"

☑ New System ☐ Repair System Type: I (II) III IV V VI

System Description: CONV. GRAVITY

Repair System Description: CONV. GRAVITY & PUMP TO EXISTING

Maintenance Agreement Required: ☐ Yes ☑ No

☐ House/Mod. Home ☑ Mobile Home ☐ Business ☐ Other

No. Bedrooms 3 No. Bathrooms 2 No. Employees

Garbage Disposal: ☐ Yes ☑ No

Auto. Dishwasher: ☑ Yes ☐ No


Auto. Washing Machine: ☑ Yes ☐ No

Other


☐ Slab ☑ Crawl Space ☐ Basement w/plumbing ☐ Basement wo/plumbing

Comments (1) KEEP SYSTEM MINIMUM 5' FROM MH, 10' FROM PROPERTY LINE, 100' FROM FUTURE WELL SITE (2) INSTALL LINES ON CONTOUR, NO DEEPER THAN 36", 9' ON CENTER

INITIAL SITE SKETCH

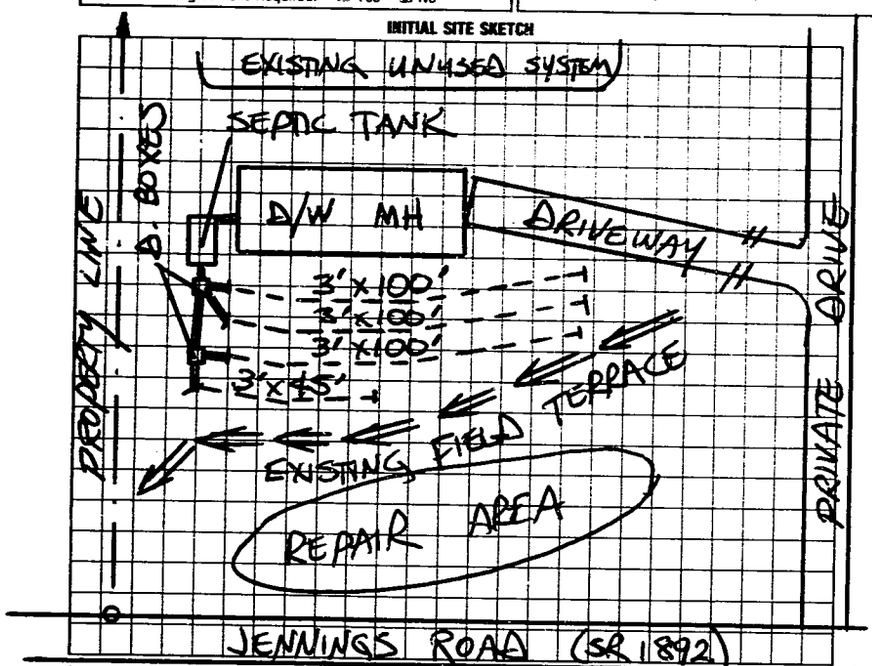

AS BUILT SKETCH

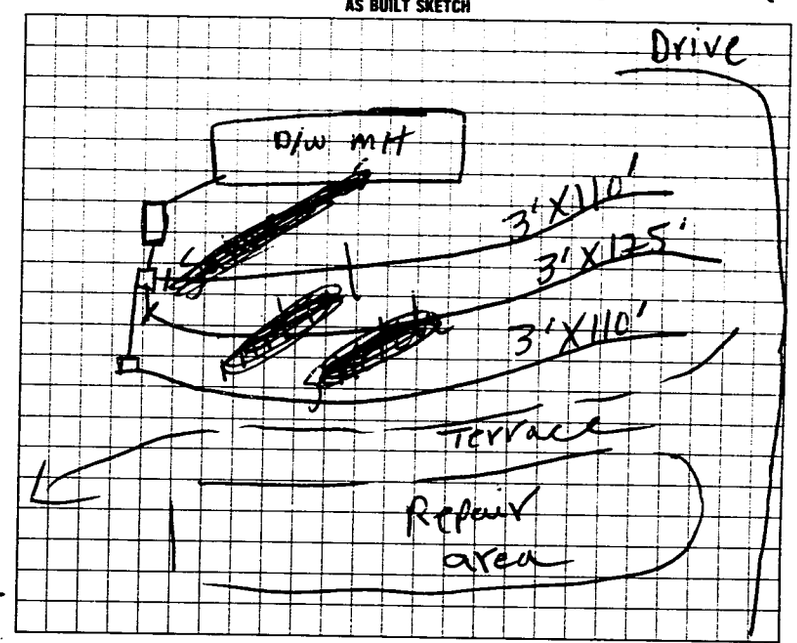

I understand that this permit can be suspended or revoked if any false information is supplied toward securing the permit/any unauthorized changes are made to the site/any unauthorized changes are made in the installation of the system. Improvement Permit is valid for 60 months from date of issuance.

Signed: Margaret M. Hedrick

Improvement Permit by: STEVE HEDRICK date 9/9/93

Existing System Inspection by: date

Installed by: A-1 Backhoe

Certificate of Completion by: P. C. Moore date 9-28-93

Operation Permit by: date

HEALTH DEPT. COPY: WHITE INSPECTION COPY (FINAL): GREEN OWNER COPY (FINAL): YELLOW INSPECTION COPY (INITIAL) PINK OWNER COPY (INITIAL) GOLD