ICHD - ENVIRONMENTAL HEALTH DIVISION

Statesville Office (704) 878-5305 Mooresville Office (704) 660-3625

BLDR-2023-13645 PERMIT # AP 2022-2532

SEPTIC: IMPROVEMENT PERMIT / AUTHORIZATION TO CONSTRUCT / OPERATION PERMIT / EXISTING SYSTEM

PIN # 4748 -- 31 -- 4859

APPLICANT/OWNER: Freedom Homes LLC

APPLICANT ADDRESS: 1124 Charlotte Hwy Troutman 28166

SITE ADDRESS: 802 Jennings Rd, Statesville NC 28625

PHONE: 336-467-0208

ALT. PHONE

SITE DIRECTIONS: I-77 - C on Jennings - lot on (R)

SAP CONTROLLED: ☑ YES ☐ NO

SUBDIVISION: Ashley Gaither & Derek Prevette

SECTION: — LOT # — LOT AREA: 1 acre


DESIGN FLOW: 360 gpd L.T.A.R.: .3 (R=.25)

Septic Tank	1000	(gal)	STB 760	Date 3/8/23	☑ New System	☐ Repair	☐ Expansion	System Type: I II (III) IV V VI	☑ Residence	No. Bedrooms 3	Water Supply
Pump Tank	1000	(gal)	PT 363	Date 3/4/23	System Description: 25% - P.M				☐ Business	No. Persons 6	☑ Private
Pump Make	Goulds	Model	PE 51M	Serial # K224874	Repair System Description: 50% - P.M				☐ Other	No. Employees	☐ Public
# Nitrification Fields	1	# Lines	3	Linear Ft 306'	Maintenance Agreement Required:	☐ YES	☑ NO		☐ Slab	☑ Crawl Space	☐ Community
Trench Width	36"	Trench Bottom Depth(Low side)		30"	Gravel Depth —	☐ GRAVITY	☑ PRESSURE		☐ Basement w/plumbing		☐ Basement w/o plumbing

Comments / Conditions: Do not pave, grade, park, drive, or bury utilites in drainfield.

2" supply line, 2' pressure head.

INITIAL SITE SKETCH

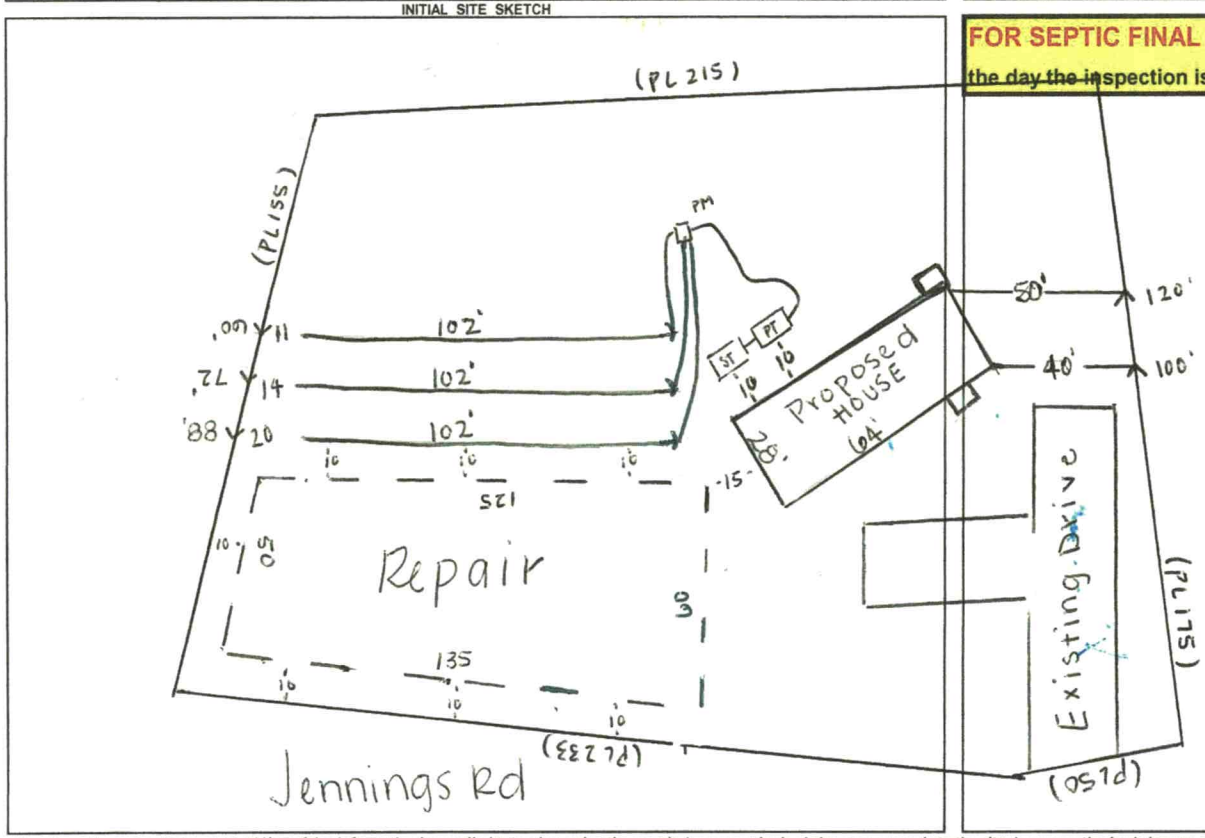


AS BUILT SKETCH

FOR SEPTIC FINAL INSPECTION CALL: 704-664-3703 between 8am-9am the day the inspection is needed. Be sure to speak with an inspector to confirm your time.

1"=50' 3 taps @ 1/2 sch 40 @ 7.11

Dose: 139.23
Flow: 21.33
Drawdown: 6.63
Run Time: 6.53

Lines installed as shown
Tanks Installed

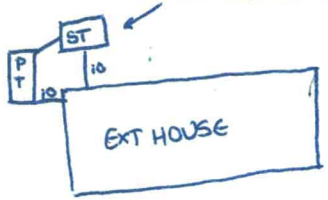

Lines 4/13/23 SB
Tanks
Manifold
Floats 5/24 BCW
Alarm/ Electrical 5/31/23 DW

Permit can be suspended or revoked if any false information is supplied toward securing the permit / any unauthorized changes are made to the site / any unauthorized changes are made in the installation of the system. **CONTACT A LOCATOR SERVICE PRIOR TO ANY EXCAVATION**

☐ **IMPROVEMENT PERMIT** *with plat valid without expiration.* ☑ **IMPROVEMENT PERMIT** *with site plan valid for 60 mos.* ☑ **AUTHORIZATION TO CONSTRUCT** *valid for period equal to IMPROVEMENT PERMIT--not to exceed 60 mo.*

Owner / Applicant Signature: Online Date: — Installed by: Frye

IMPROVEMENT PERMIT by: Sydney Holland Date: 12-22-22 OPERATION PERMIT by: D. Mebey Date: 5/31/23

AUTHORIZATION TO CONSTRUCT by: Sydney Holland Date: 12-22-22 Existing System Inspected by: Date:

FOR SEPTIC FINAL INSPECTION: CALL 704-664-3703 between 8am-9am the day the inspection is needed.

MW BLDR-2023-13645 OSWP

ICHD - ENVIRONMENTAL HEALTH DIVISION

Statesville Office (704) 878-5305 Mooresville Office (704) 660-3625 PERMIT # AP 2022-2532

SEPTIC: IMPROVEMENT PERMIT / AUTHORIZATION TO CONSTRUCT / OPERATION PERMIT / EXISTING SYSTEM

PIN # 4748 -- 31 -- 4859

APPLICANT/OWNER: Freedom Homes LLC APPLICANT ADDRESS: 1124 Charlotte Hwy Troutman 28166

SITE ADDRESS: 802 Jennings Rd, Statesville NC 28625 PHONE: 336-467-0208 ALT. PHONE

SITE DIRECTIONS: I-77 - (L) on Jennings - lot on (R) SAP CONTROLLED: ☑ YES ☐ NO


SUBDIVISION: Ashley Gaither & Derek Prevette SECTION: — LOT # — LOT AREA: 1 acrea DESIGN FLOW: 360gpd L.T.A.R.: .3 (R=.25)

Septic Tank	1000	(gal)	STB 760	Date 3/8/23	☑ New System	☐ Repair	☐ Expansion	System Type: I II (III) IV V VI	☑ Residence	No. Bedrooms 3	Water Supply
Pump Tank	1000	(gal)	PT 363	Date 3/4/23	System Description: 25% - P.M				☐ Business	No. Persons 6	☑ Private
Pump Make	Goulds	Model	PE 51M	Serial # K224874	Repair System Description: 50% - P.M				☐ Other	No. Employees	☐ Public
# Nitrification Fields	1	# Lines	3	Linear Ft 306'	Maintenance Agreement Required:	☐ YES	☑ NO		☐ Slab	☑ Crawl Space	☐ Community
Trench Width	36"	Trench Bottom Depth(Low side)		30"	Gravel Depth —	☐ GRAVITY	☑ PRESSURE		☐ Basement w/plumbing	☐ Basement w/o plumbing	

Comments / Conditions: Do not pave, grade, park, drive, or bury utilites in drain field.

2" supply line, 2' pressure head.

INITIAL SITE SKETCH

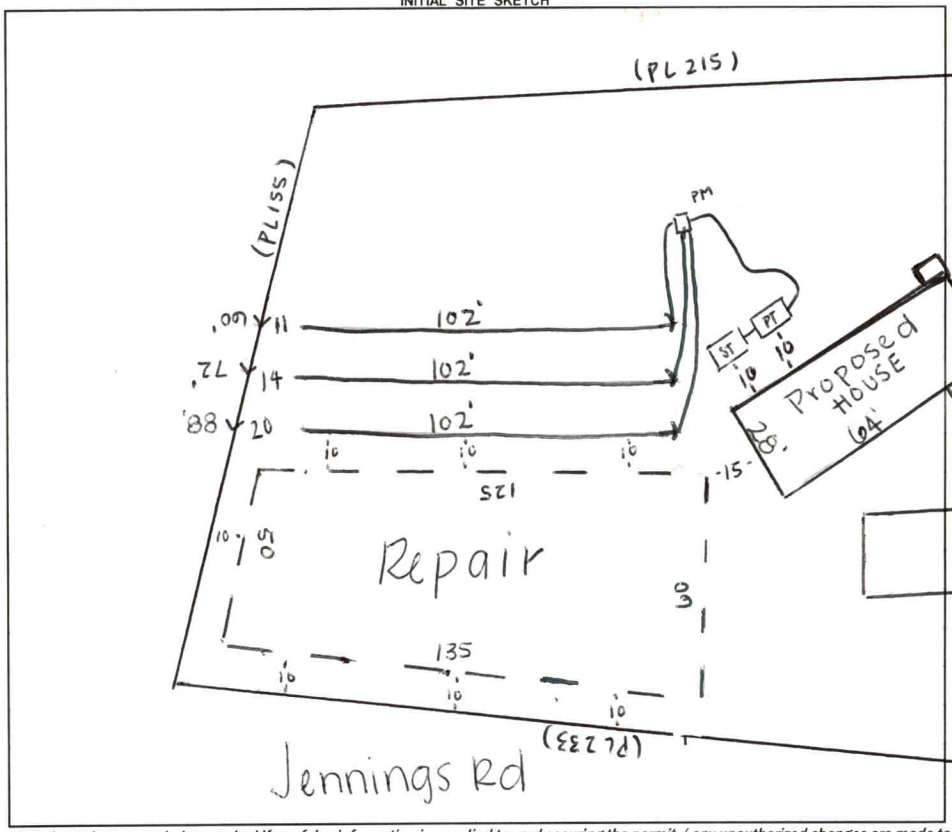


AS BUILT SKETCH

FOR SEPTIC FINAL INSPECTION CALL: 704-664-3703 between 8am-9am the day the inspection is needed. Be sure to speak with an inspector to confirm your time.

1"=50' 3 taps @ 1/2 sch 40 @ 7.11

Dose: 139.23
Flow: 21.33
Drawdown: 6.63
Run Time: 6.53

Lines installed as shown
Tanks Installed

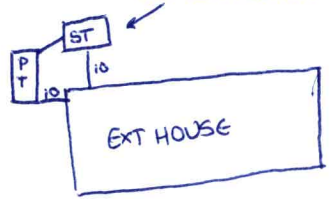

Lines
Tanks 4/13/23 SB
Manifold

Permit can be suspended or revoked if any false information is supplied toward securing the permit / any unauthorized changes are made to the site / any unauthorized changes are made in the installation of the system. **CONTACT A LOCATOR SERVICE PRIOR TO ANY EXCAVATION**

☐ **IMPROVEMENT PERMIT** *with plat valid without expiration.* ☑ **IMPROVEMENT PERMIT** *with site plan valid for 60 mos.* ☑ **AUTHORIZATION TO CONSTRUCT** *valid for period equal to IMPROVEMENT PERMIT--not to exceed 60 mo.*

Owner / Applicant Signature: Online Date: — Installed by: Frye

IMPROVEMENT PERMIT by: Sydney Holland Date: 12-22-22 OPERATION PERMIT by: Date:

AUTHORIZATION TO CONSTRUCT by: Sydney Holland Date: 12-22-22 Existing System Inspected by: Date:


FOR SEPTIC FINAL INSPECTION: CALL 704-664-3703 between 8am-9am the day the inspection is needed.

Item	Date	Initials
Drain Lines Checked	4/13/23	SB
Tanks Checked	4/13/23	SB
Pressure Manifold or Valve Box Checked	4-13-23	SB
Pressure Head Set	5-23-2023	BCW
Electrical Checked		
Floats Set	5-23-2023	BCW
Alarm Checked		
Maintenance Contract Needed? Y / (N)	5-23-2023	BCW
Comments:		

Repairs Only	
	State Code
Failing System Code	
Type of Distribution	G or P
Type of Failure/Malfunction	
Primary Cause of Failure/Malfunction	
Age of System? _____	
Initial or Repair? _____	

GAITHER - PLOT PLAN
N.T.S.

ADDENDUM TO THE SALES AGREEMENT

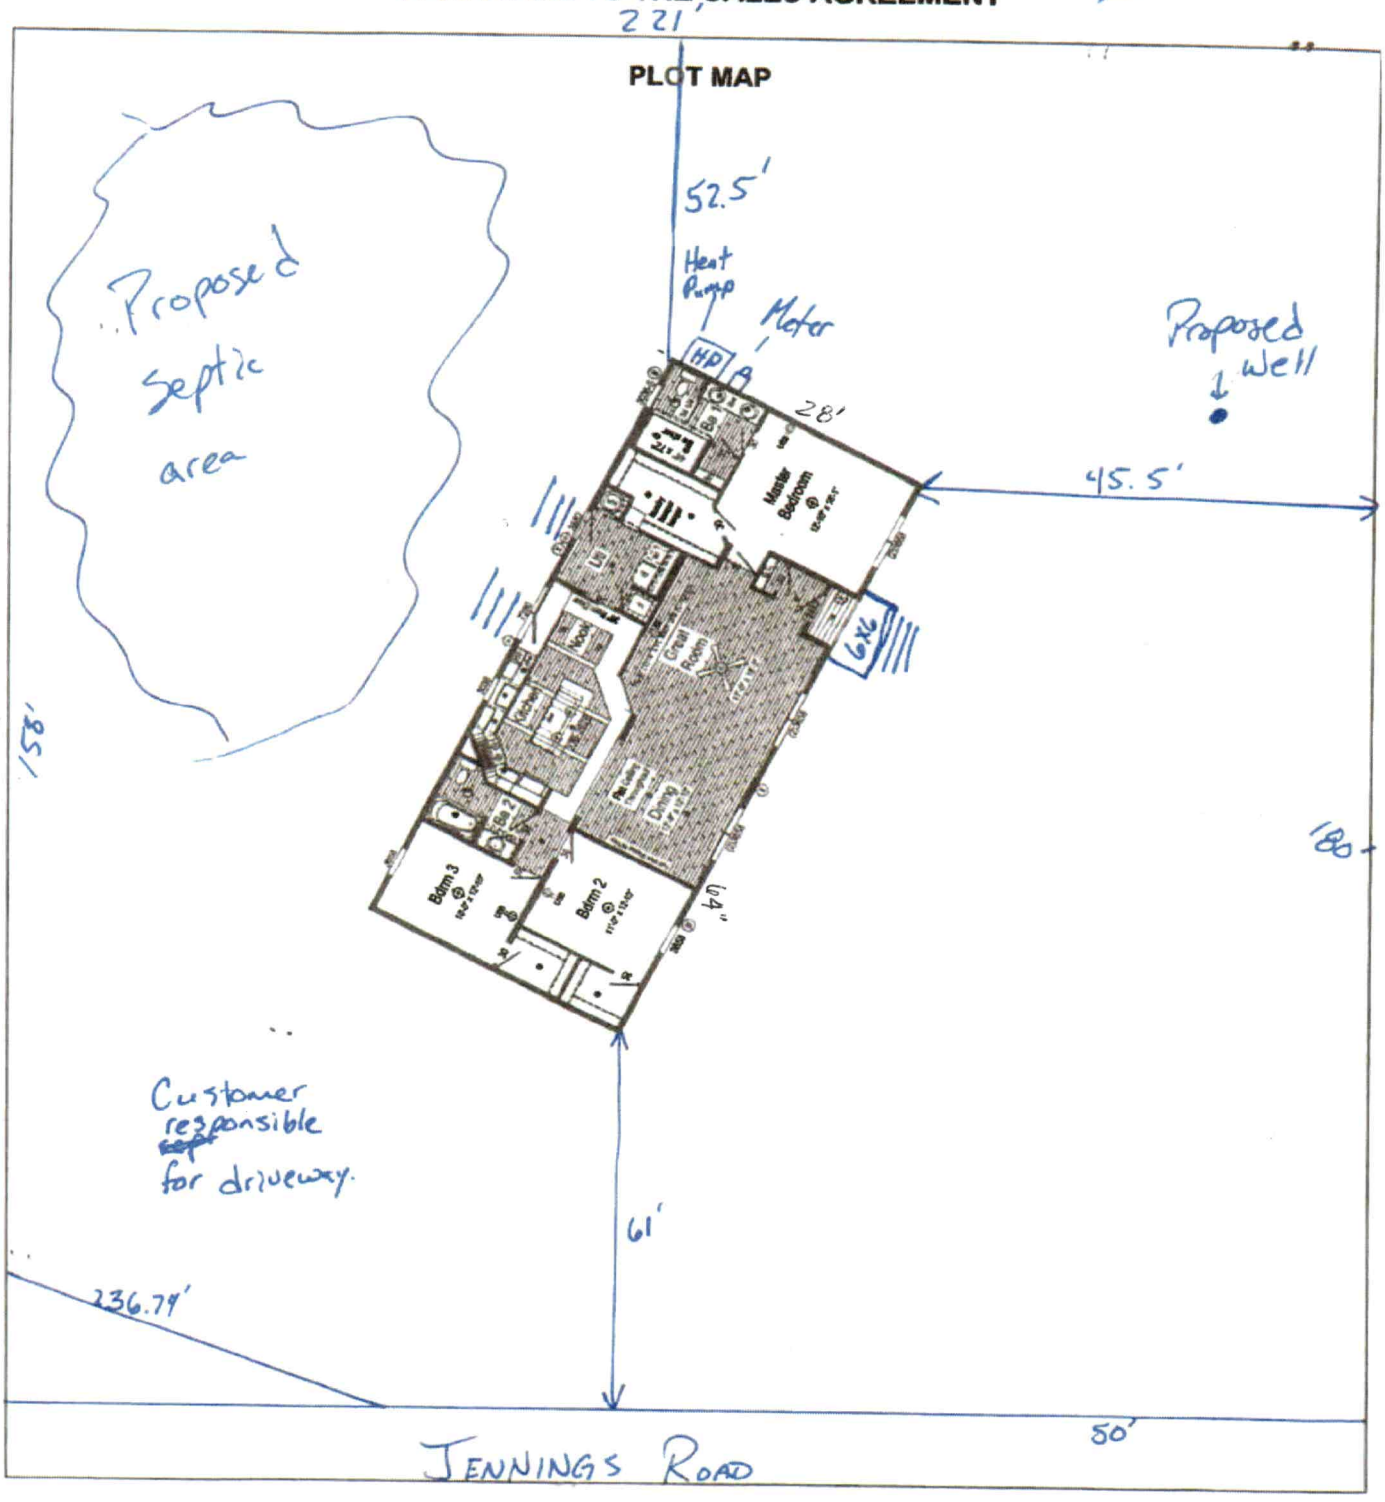

Initials _____ Initials _____

DEPARTMENT OF HEALTH AND HUMAN SERVICES
DIVISION OF PUBLIC HEALTH, ENVIRONMENTAL HEALTH SECTION
ON-SITE WATER PROTECTION BRANCH

Sheet 1 of 1
PROPERTY ID #: 4748314859
COUNTY: Iredell

SOIL/SITE EVALUATION
***for* ON-SITE WASTEWATER SYSTEM**
(Complete all fields in full)

OWNER: Fredom Homes LLC
APPLICATION DATE 8/25/22
ADDRESS: 1124 Charlotte Hwy, Troutman NC 28166
DATE EVALUATED: 12-21-22
PROPOSED FACILITY: 3BR
PROPOSED DESIGN FLOW (.1949): 360 gpd
PROPERTY SIZE: 1 acre
LOCATION OF SITE: 802 Jennings Rd. Statesville 28625
PROPERTY RECORDED: Yes
WATER SUPPLY: ☐ Private ☐ Public ☑ Well ☐ Spring ☐ Other
EVALUATION METHOD: ☐ Auger Boring ☑ Pit ☐ Cut
TYPE OF WASTEWATER: ☑ Sewage ☐ Industrial Process ☐ Mixed

PROFILE #	.1940 LANDSCAPE POSITION/ SLOPE %	HORIZON DEPTH (IN.)	SOIL MORPHOLOGY (.1941) .1941 STRUCTURE/ TEXTURE	SOIL MORPHOLOGY (.1941) .1941 CONSISTENCE/ MINERALOGY	OTHER PROFILE FACTORS .1942 SOIL WETNESS/ COLOR	.1943 SOIL DEPTH	.1956 SAPRO CLASS	.1944 RESTR HORIZ	PROFILE CLASS & LTAR
1	6%	0-24	C1SBK	SS-SP-Fr-SEXP	— Heavy Sap inc. thru-out Some Fl near sap	48"	—	—	P.S .25
		24-48	CL/SBK	SS-SP-FR-SEXP					
2	10%	0-35	C/SBK	SS-SP-FR-SEXP	— Few Sap inc in C layer	35" (55 total)	L	—	P.S .3
		35-55	LSAP/Ma	NS-NP-FR					
3	11% (4" s.c)	0-30	C1SBK	SS-SP-FR-SEXP	— Heavy mica inc thru-out Heavy sap inc at bottom of CL Mg inc → non cont.	51"	-	-	P.S .3 (30" TB)
		30-51	CL/SBK	SS-SP-FR-SEXP					
4	9%	0-29	C/SBK	SS-SP-FR-SEXP	Some rock inc in CL (↳ Pockets) Heavy mica inc. thru-out	39"	L	—	P.S .3
		29-39	CL/SBK	SS-SP-FR-SEXP					
		39-54	SAP/MA	FI-SEXP					

DESCRIPTION	INITIAL SYSTEM	REPAIR SYSTEM
Available Space (.1945)	300'	240'
System Type(s)	25%	50%
Site LTAR	.3	.25

OTHER FACTORS (.1946):
SITE CLASSIFICATION (.1948): P.S
EVALUATED BY: S Holland
OTHER(S) PRESENT:

COMMENTS:

Updated February 2014

LEGEND

use the following standard abbreviations

LANDSCAPE POSITION	GROUP	SOIL TEXTURE	CONVENTIONAL .1955 LTAR*	LPP .1957 LTAR*	MINERALOGY/ CONSISTENCE	STRUCTURE
CC (Concave Slope)	I	S (Sand)	1.2 - 0.8	0.6 - 0.4	SEXP (Slightly Expansive)	G (Single Grain)
CV (Convex Slope)		LS (Loamy Sand)			EXP (Expansive)	M (Massive)
D (Drainage Way)						CR (Crumb)
DS (Debris Slump)	II	SL (Sandy Loam)	0.8 - 0.6	0.4 - 0.3		GR (Granular)
FP (Flood Plain)		L (Loam)				SBK (Subangular Blocky)
FS (Foot Slope)						ABK (Angular Blocky)
H (Head Slope)	III	Si (Silt)	0.6 - 0.3	0.3 - 0.15		PL (Platy)
L (Linear Slope)		SiCL (Silty Clay Loam)				PR (Prismatic)
N (Nose Slope)		CL (Clay Loam)				
R (Ridge)		SCL (Sandy Clay Loam)			**MOIST**	**WET**
S (Shoulder Slope)		SiL (Silt Loam)				
T (Terrace)					VFR (Very Friable)	NS (Non-sticky)
	IV	SC (Sandy Clay)	0.4 - 0.1	0.2 - 0.05	FR (Friable)	SS (Slightly Sticky)
		SiC (Silty Clay)			FI (Firm)	S (Sticky)
		C (Clay)			VFI (Very Firm v. Very Sticky)	VS (Very Sticky)
		O (Organic)	None	None	EFI (Extremely Firm)	NP (Non-plastic)
						SP (Slightly Plastic)
						P (Plastic)
						VP (Very Plastic)

*Adjust LTAR due to depth, consistence, structure, soil wetness, landscape, position, wastewater flow and quality.


NOTES

HORIZON DEPTH	In inches below natural soil surface
DEPTH OF FILL	In inches from land surface
RESTRICTIVE HORIZON	Thickness and depth from land surface
SAPROLITE	S(suitable) or U(unsuitable)
SOIL WETNESS	Inches from land surface to free water or inches from land surface to soil colors with chroma 2 or less - record Munsell color chip designation
CLASSIFICATION	S (Suitable), PS (Provisionally Suitable), or U (Unsuitable)

Evaluation of saprolite shall be by pits.

Long-term Acceptance Rate (LTAR): gal/day/ft^2

Show profile locations and other site features (dimensions, reference or benchmark, and North).

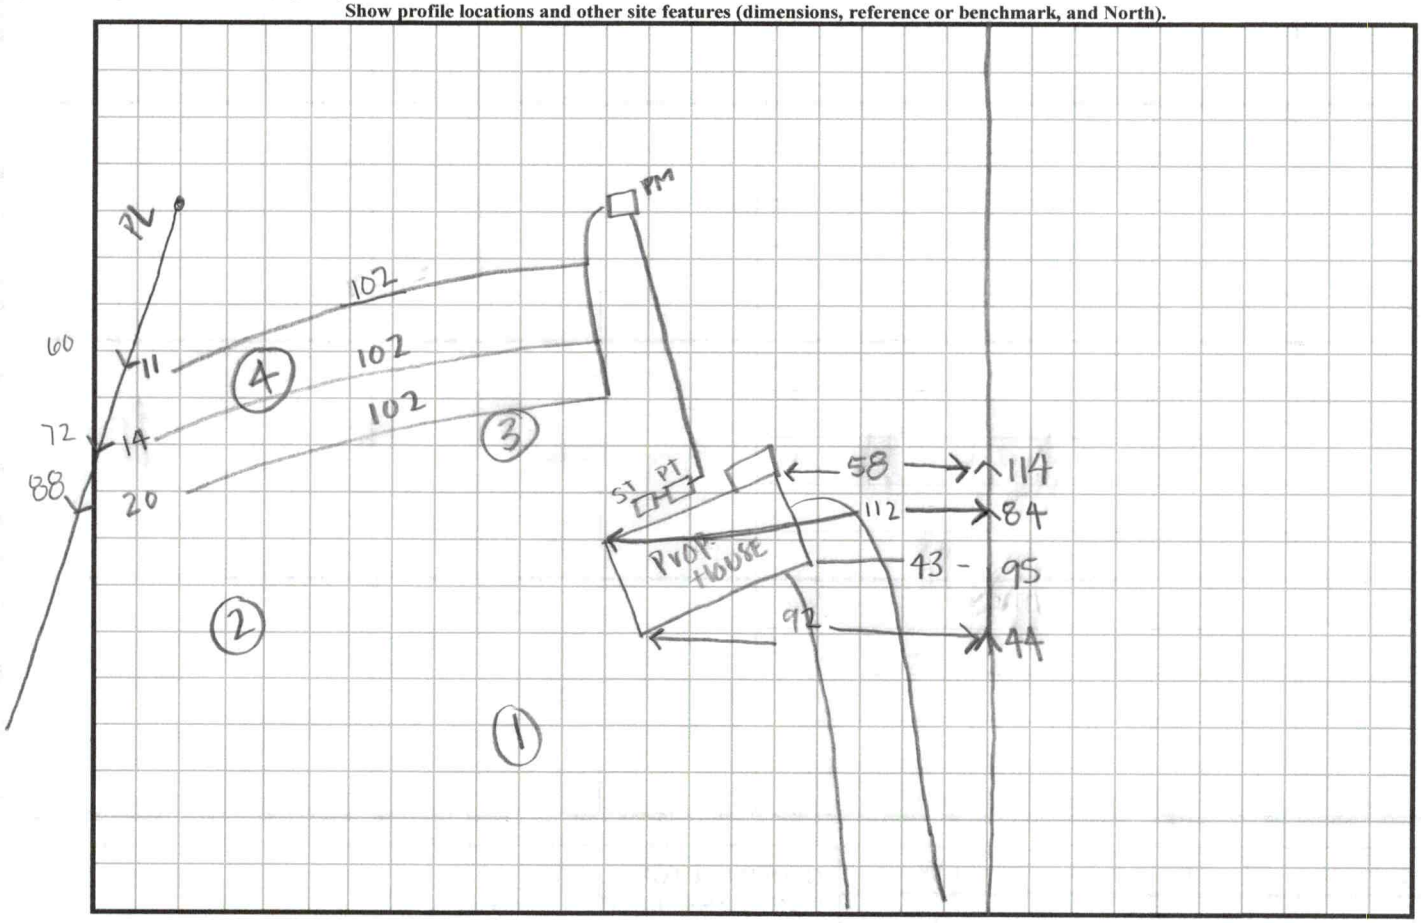

Jennings Rd

PERMIT SNAPSHOT REPORT OSWP-2022-2532 FOR IREDELL COUNTY

Permit Type: Environmental Health OSWP
Work Class: EH Septic Improvement Permit
Status: In Progress
Valuation: $0.00
Project:
District: Iredell County
Square Feet: 0.00
Assigned To: Holland, Sydney
App Date: 08/25/2022
Exp Date: NOT AVAILABLE
Completed: NOT COMPLETED
Approval Expire Date:

Description: we are installing a 28x64 modular home with 6x6 front and 6x6 back deck, we will need a new well and septic permit. also, will need an auth to construct permit

Parcel: 4748314859.000 Main
Address: 802 Jennings Rd Statesville, NC 28625 Main
Zone: RA(Residential Agricultural District)

Applicant/Authorized Agent
FREEDOM HOMES-TROUTMAN #667-USE THIS ONE FREEDOM
1124 CHARLOTTE HWY
TROUTMAN, NC 28166
Business: (704) 881-2326

Property Owner
CHARLES GAITHER
Home: (336) 467-0208

Permit Custom Fields

How is your site plan being submitted	Custom Site Plan	Does the site contain any jurisdictional wetlands	No	Non-domestic Sewage Generated	No
Other Public Agency	No	All proposed structure dimensions	28x64 modular home with 6x6 front and 6x6 back deck	What are the proposed structures	New Single Family Residence
If other Addition/Structure, please explain		Maximum Number of Bedrooms	3	Number of Occupants	2
Foundation Type	Crawl Space Foundation	Water Supply	New Well	Desired Septic System Type	Conventional (most common)
If other septic system type, please explain		Has this project been approved by TRC	No	Lot Acreage	1
Front Setback	35	Back Setback	35	Left Setback	15
Right Setback	15	Is the structure or development in the floodplain	No	Is the property in a local historic district?	No
Is the property located downtown?	No	Additional Unique Setbacks Apply	No	Watershed	NOT IN A WATERSHED

Attachment File Name	Added On	Added By	Attachment Group	Notes
GAITHER WELL AND SEPTIC PERMIT APPLICATION_v1.pdf	08/25/2022 15:25	Hart, Ronda	Available Online	Additional Supporting Information
GAITHER SITE PLAN_v1.pdf	08/25/2022 15:26	Hart, Ronda	Available Online	Site Plan
GAITHER AUTH TO ACT_v1.pdf	08/25/2022 15:26	Hart, Ronda	Available Online	Authorize to Act as Agent
GAITHER FLOOR PLAN_v1.pdf	09/22/2022 16:10	Bailey, Julia	Available Online	Floor Plan(s)
ZONING PERMIT APPLICATION_v1.pdf	09/22/2022 16:10	Bailey, Julia	Available Online	Additional Supporting Information

Inspection Number	Status	Inspection Type	Request Date	Scheduled Start Date	Scheduled End Date	Actual Start Date	Actual End Date
2022-34812	Re-inspection required (with fee)	OSWP Septic/Well Preliminary Site Visit	11/09/2022			11/09/2022 9:00	11/09/2022 9:00

Inspectors: Kobuck, Teanna (Primary)

Checklist Item	Description	Passed	Comments
General Comments	Checklist item used to track general comments, not specific to any other checklist item	No	

Inspection Number	Status	Inspection Type	Request Date	Scheduled Start Date	Scheduled End Date	Actual Start Date	Actual End Date
2022-41153	Passed - Permit	OSWP Septic/Well Preliminary Site Visit	12/01/2022			12/01/2022 8:09	12/01/2022 8:09

Inspectors: Kobuck, Teanna (Primary)

Checklist Item	Description	Passed	Comments
General Comments	Checklist item used to track general	No	

PERMIT SNAPSHOT REPORT (OSWP-2022-2532)

	comments, not specific to any other checklist item	

Note	Created By	Date and Time Created
1. Pits scheduled for 10/21/22- 10am	Sydney Holland	12/09/2022 8:12

Invoice No.	Fee		Fee Amount	Amount Paid
INV-00001061	New Gravity System		$500.00	$500.00
		Total for Invoice INV-00001061	$500.00	$500.00
INV-00002612	Iredell Zoning Permit Fee		$75.00	$75.00
	Iredell Zoning Tech Fee		$2.25	$2.25
		Total for Invoice INV-00002612	$77.25	$77.25
INV-00005003	Site Revisit		$100.00	$100.00
		Total for Invoice INV-00005003	$100.00	$100.00
		Grand Total for Permit	**$677.25**	**$677.25**

Workflow Step / Action Name	Action Type	Start Date	End Date
Application Completeness Check v.1		08/25/2022 0:00	08/25/2022 15:27
Confirm application complete v.1	Generic Action		08/25/2022 15:27
Fees v.1		08/25/2022 0:00	08/29/2022 17:38
Issue Invoice v.1	Generic Action		08/25/2022 15:27
Fees Paid v.1	Generic Action		08/29/2022 17:38
Zoning Review v.1		08/25/2022 0:00	11/04/2022 15:49
Iredell County Zoning Approval v.1	Task	08/25/2022 0:00	11/04/2022 15:49
Issue Invoice v.1	Generic Action		09/22/2022 16:11
Fees Paid v.1	Generic Action		11/04/2022 15:49
Fees v.1		11/10/2022 0:00	12/02/2022 8:08
Issue Invoice v.1	Generic Action		11/10/2022 9:01
Fees Paid v.1	Generic Action		12/02/2022 8:08
Lot Readiness Verification v.1		11/10/2022 0:00	
OSWP Septic Preliminary Site Visit v.1	Inspection	11/10/2022 0:00	11/10/2022 9:00
OSWP Septic Preliminary Site Visit v.2	Inspection	12/02/2022 0:00	12/02/2022 8:09
OSWP Site Evaluation v.1	Inspection		
Issue Improvement Permit v.1			
Issue Invoice v.1	Generic Action		
Fees Paid v.1	Generic Action		
Issue Permit v.1	Generic Action		
Permit Completion Process v.1			
Authorization to Construct Permit v.1	Create Sub Permit		
Issue Authorization to Construct v.1	Generic Action		

Notice

* Property subject to any easements and right of way on record, and all NCDOT easements and rights of way

* This survey is subject to any facts that may be disclosed by a full and accurate title search.

* This survey plat does not show any unrecorded, within or unwritten easements, dedications or other encumbrances. Such burdens could exist on this property and not appear on this plat. Accordingly, users of this plat are warned to furnish alert for the existence of such unrecorded burdens not shown hereon.

* Area determined by coordinate computations.

* As of the date of this recording the lots have not been inspected by the Iredell County Health Department. Until inspected there is no assurance that building permits will be issued.

* No NGS or NCGS Horiz. Control Monument found within 2,000 feet of site.

* This lot is to be served by individual Water and Sanitary Sewer Systems.

* Total number of Lots = 1

* This plat represents an actual field survey that meets or exceeds the minimum requirements of a Class A Survey in accordance with the Standards of Practice for Land Surveying in North Carolina according to North Carolina Administrative Code Title 21, Chapter 56, Section 1607.

* The Global Navigation Satellite System (GNSS) was used in portions to geospatial positioning accuracy standards, part 2 standards for geodetic networks at the 95% confidence accuracy classifiction (95% confidence) using real time kinematic. The following information was used:

Class of Survey: CLASS A
Positional Accuracy: 0.07'
Type of GPS Field Procedure: RTK
Dates of Survey: 10/20/2021- 12/06/2021
Datum/Epoch: NAD83 (2011)
Published/Fixed-Control Use: NAS
GEOID Model: 2018
Combined Grid Factor: 0.99989529
Units: US Survey Feet

That this plat was prepared in accordance with G.S. 47-30 as amended that this plats meets the requirement of G.S. 47-30. I further certify that this survey creates a subdivision of land within the area of a county or municipality that has ordinance that regulates parcels of land.

Witness my original signature, registration number and seal this 15th day of February 2022 A.D.

Ted M. Benbow PLS L-3175
Firm License # C-1589


NORTH CAROLINA PROFESSIONAL SEAL L-3175 LAND SURVEYOR TED M. BENBOW

Unless otherwise indicated, all distances shown are horizontal ground distances. To convert to grid distance, multiply the ground distance by the combined factor.

Water Supply Watershed Certificate:

To the best of my knowledge this plat does not lie within a water supply watershed designated by the North Carolina Division of Environmental Management as appears on the Watershed Protection Map of Iredell County, North Carolina.

Subdivision Administrator — Date

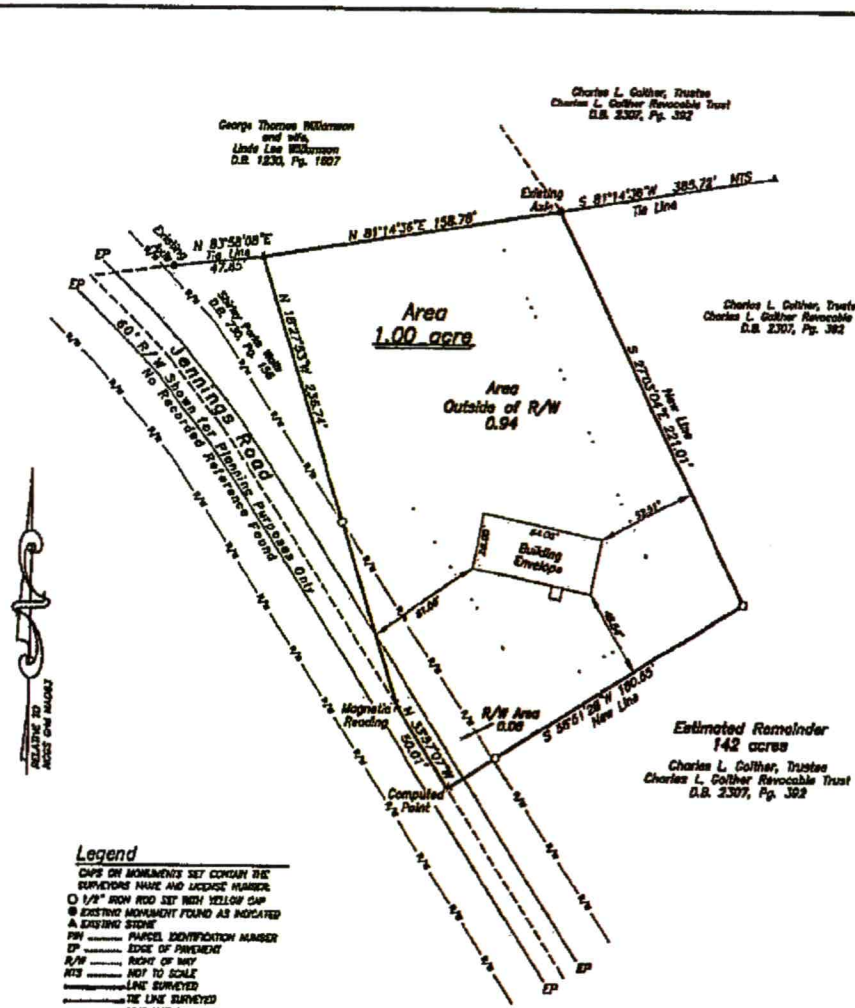

Legend

CAPS ON MONUMENTS SET CONTAIN THE SURVEYORS NAME AND LICENSE NUMBER.

- ○ 1/2" IRON ROD SET WITH YELLOW CAP
- ● EXISTING MONUMENT FOUND AS INDICATED
- ▲ EXISTING STONE
- PIN ..... PARCEL IDENTIFICATION NUMBER
- EP ..... EDGE OF PAVEMENT
- R/W ..... RIGHT OF WAY
- NTS ..... NOT TO SCALE
- ——— LINE SURVEYED
- ——— TIE LINE SURVEYED
- — — — LINE NOT SURVEYED
- R/W ..... RIGHT-OF-WAY LINE
- . . . . . SETBACK LINE


Zoning

ZONED: RA (Iredell County)
Building Setbacks
Front = 35'
Side = 15'
Rear = 35'

Flood Hazard Area Certificate

According to mapping provided by the Federal Emergency Management Agency and shown on the Digital Flood Insurance Rate Map (DFIRM) Panel 4748, Iredell County, North Carolina effective date: 03/18/2008, the property shown hereon is not located within a special flood hazard area. The property is entirely within an area designated "Zone X – other areas". Areas determined to be outside the 0.2% annual chance floodplain; areas outside future conditions 1% annual chance floodplain.

GRAPHIC SCALE — 1" = 40'

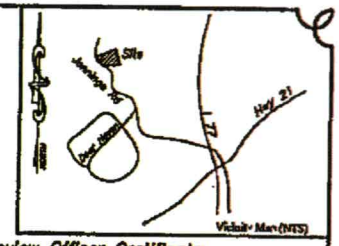

Review Officer Certificate

State of North Carolina
County of Iredell

I, _____, Review Officer for Iredell County certify that the map or plat to which this certification is affixed meets all statutory requirements for recording.

Review Officer — Date

Certificate of Ownership & Dedication

I hereby certify that I am the owner of the property shown and described hereon, which is located in the subdivision jurisdiction of the County of Iredell and that I hereby adopt this plan of subdivision with my free consent, establish minimum building setback lines as noted.

a. there are no deed restrictions which will be violated by the requested subdivision;

b. there are no governmental regulations of any kind, other than those for which a variance has been applied for under the Iredell County Subdivision Ordinance regulations, which will be violated by the requested subdivision; and

c. I understand that enforcement of deed restrictions and any other contractual agreements is not the responsibility of Iredell County will not be undertaken by Iredell County; and is the sole responsibility of the parties affected by violations of such deed restrictions and contractual agreements.

Owner — Date

Owner — Date

Notary

North Carolina, Iredell County

I, _____, a Notary Public for said county and state do hereby certify that _____ owner(s) personally appeared before me this day and acknowledged the due execution of the foregoing instrument.

Witness my hand and official seal,

this the _____ day of _____, 2021.

Notary Public

My commission expires _____

Certificate of Approval for Recording:

I hereby certify that the subdivision plat shown hereon has been found to comply with the Subdivision Regulations of the County of Iredell, North Carolina and that this plat has been approved by the Subdivision Administrator for recording in the Office of the Register of Deeds of Iredell County.

Subdivision Administrator — Date


Family Subdivision

Ashley Gaither
Derek Prevette

Bethany Township, Iredell County, NC
Owners of Record: Charles L. Gaither, Trustee
Charles L. Gaither Revocable Trust
Deed Reference: D.B. 2307, Pg. 392
Plat Reference: N/A
PIN: 4748-41-8451
Job Number: 2110302.DWG (2110302.CRD)
Field work: 10/20/2021
Plat date: 12/06/2021
Revised Plat date: 2/25/2022

TED BENBOW Land Surveying
Proudly Surveying Iredell County Since 1998
630 SIGNAL HILL DRIVE EXT., STATESVILLE, NC 28625
PHONE (704) 876-9681
www.boundarydevelopment.com

Gaither

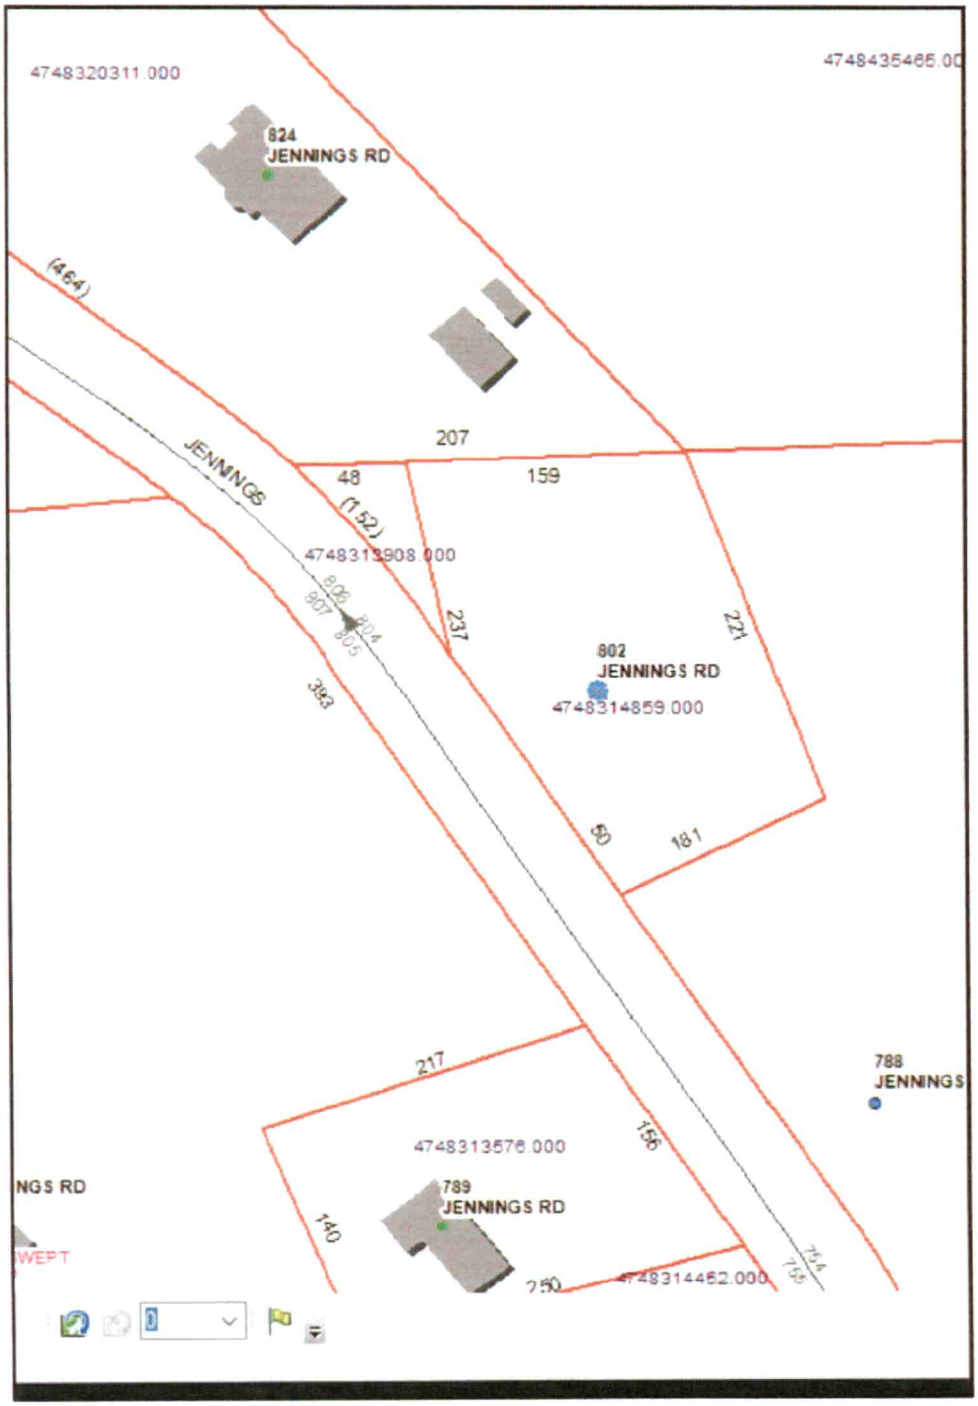

[Quoted text hidden]

CAUTION: This email originated from outside of the organization. Do not click links or open attachments unless
you recognize the sender and know the content is safe. Report suspicious emails by clicking the "Report Phish" button.