IREDELL COUNTY HEALTH DEPARTMENT

STATESVILLE 704-878-5305 MOORESVILLE 704-664-5281

IMPROVEMENT PERMIT / CERTIFICATE OF COMPLETION / OPERATION PERMIT / EXISTING SYSTEM INSPECTION

PROPERTY DESCRIPTION NO. 067033 DATE 6-27-97 TAX MAP NO. 4748 34 6237 Watershed: ☐ Yes ☑ No

OWNER OR CONTRACTOR LARRY PITMAN PHONE: Business Home 873-6751

ADDRESS 122 ROCK HAVEN DRIVE, STATESVILLE NC 28677

LOCATION US 21 N, TL JENNINGS RD, TR EAGLEWOOD DRIVE, LOT AT END ON RIGHT

SUBDIVISION IVY & OAKS BLOCK / SECTION LOT 10 LOT AREA 0.38 ACRE SITE CLASS. PS1 DESIGN FLOW 240 L.T.A.R. 0.40 GPD/FT²

Septic Tank: 1000 Gallons; STB 1012 Date 5-8-97

Pump Tank: Gallons; PT Date

Pump Make: Model Serial No.

Nitrification Field: No Fields 1 Square Feet 600 Linear Feet 200

No Lines TWO Trench Width 24" Max Trench Bottom Depth 30" Gravel Depth 12"

☑ New System ☐ Repair System Type: I, II, III, IV, V, VI

System Description: CONVENTIONAL GRAVITY

Repair System Description: LPP

Maintenance Agreement Required: ☐ Yes ☑ No

☐ House/Mod. Home ☑ Mobile Home ☐ Business ☐ Other

No. Bedrooms 2 No. Bathrooms 2 No. Employees


☐ Slab ☑ Crawl Space ☐ Basement w/plumbing ☐ Basement wo/plumbing

Water Supply: ☐ Individual ☐ Community ☑ Public


Comments:

Comments:

INITIAL SITE SKETCH

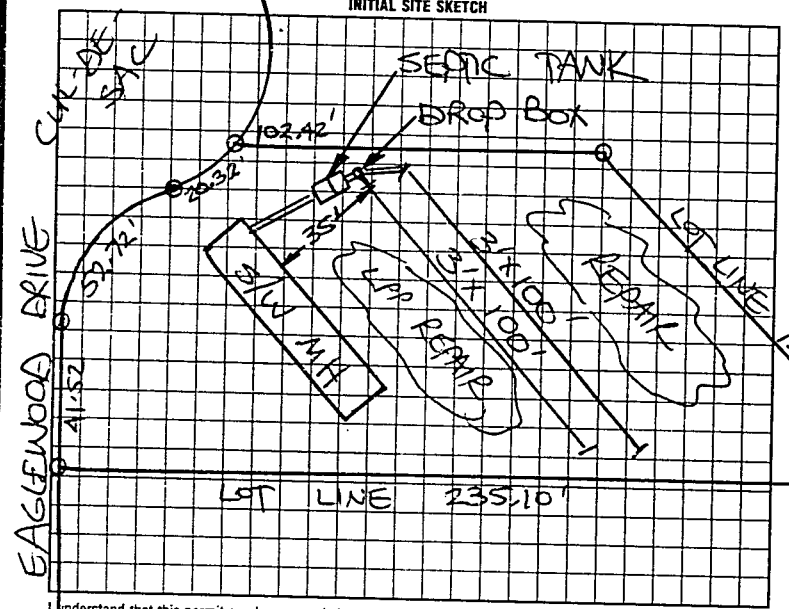

AS BUILT SKETCH

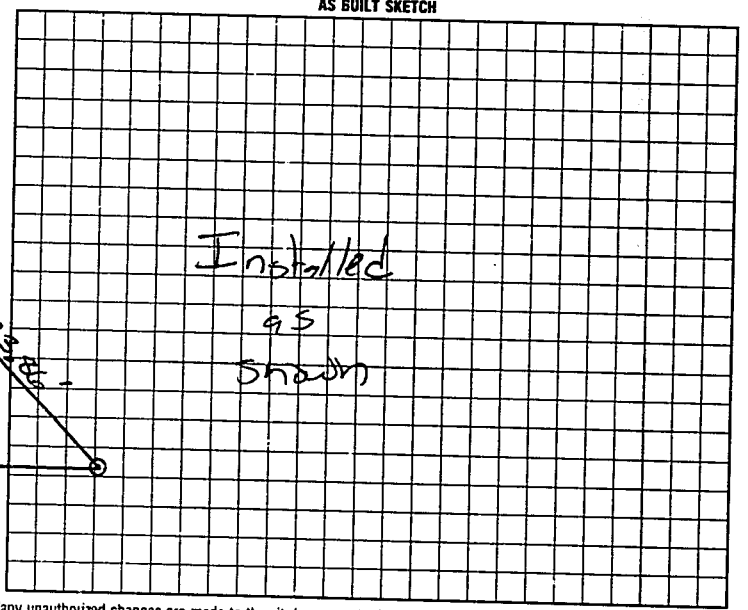

I understand that this permit can be suspended or revoked if any false information is supplied toward securing the permit/any unauthorized changes are made to the site/any unauthorized changes are made in the installation of the system. Improvement Permit is valid for 60 months from date of issuance. AUTHORIZATION TO CONSTRUCT IS VALID FOR 60 MONTHS FROM DATE OF ISSUANCE.

Signed: X Dennis Dallier

Improvement Permit by: STEVE HEDRICK date 6-27-97

Existing System Inspection by: STEVE HEDRICK date 6-27-97

Installed by: A-1 Backhoe

~~Certificate of Completion by:~~ date

Operation Permit by: Mark C Ody LS date 6-30-97

HEALTH DEPT. COPY: WHITE INSPECTION COPY (FINAL): GREEN OWNER COPY (FINAL): YELLOW INSPECTION COPY (INITIAL): PINK OWNER COPY (INITIAL): GOLD

6 9 2 2 0 0