IREDELL COUNTY HEALTH DEPARTMENT

STATESVILLE 704-878-5305 MOORESVILLE 704-664-5281

IMPROVEMENT PERMIT / AUTHORIZATION TO CONSTRUCT / OPERATION PERMIT / EXISTING SYSTEM INSPECTION

PERMIT# 071986 PIN# 4748 34 6237 DATE 3-2-98

OWNER OR CONTRACTOR LARRY & RUTH PITMAN PHONE: Business Home 873-6751

ADDRESS 122 ROCK HAVEN DR STATESVILLE, NC 28677

LOCATION US 21 N, TL JENNINGS, TR EAGLEWOOD, TR RIVERVIEW, 2ND LOT ON LEFT

SUBDIVISION IVEY & OAKS BLOCK / SECTION II LOT 14 LOT AREA 0.55 ACRE SITE CLASS. PS DESIGN FLOW 240 L.T.A.R. 0.30 GPD/FT2

Septic Tank: 1000 Gallons; STB 1012 Date 1-14-98

Pump Tank: Gallons; PT Date

Pump Make: Model Serial No.

Nitrification Field: No Fields 1 Square Feet 810 Linear Feet 270

No Lines THREE Trench Width 36" Max Trench Bottom Depth 30" Gravel Depth 12"

☑ New System ☐ Repair System Type: I, II, III, IV, V, VI

System Description: CONVENTIONAL GRAVITY

Repair System Description: CONV. GRAVITY

Maintenance Agreement Required: ☐ Yes ☑ No

☐ House/Mod. Home ☑ Mobile Home ☐ Business ☐ Other

No. Bedrooms 2 No. Bathrooms No. Employees

Water Supply: ☐ Individual ☑ Public ☐ Community


☐ Slab ☑ Crawl Space ☐ Basement w/plumbing ☐ Basement wo/plumbing

Comments:/Conditions: INSTALL SUBSURFACE INTERCEPT DRAINAGE DITCH AT LOCATION SHOWN BEGINNING 42" DEEP & OUT TO DAYLIGHT

Comments:/Conditions: 4/2/98 - Inspected drain lines tank part of subsurface

SCALE: 1"=30'

INITIAL SITE SKETCH

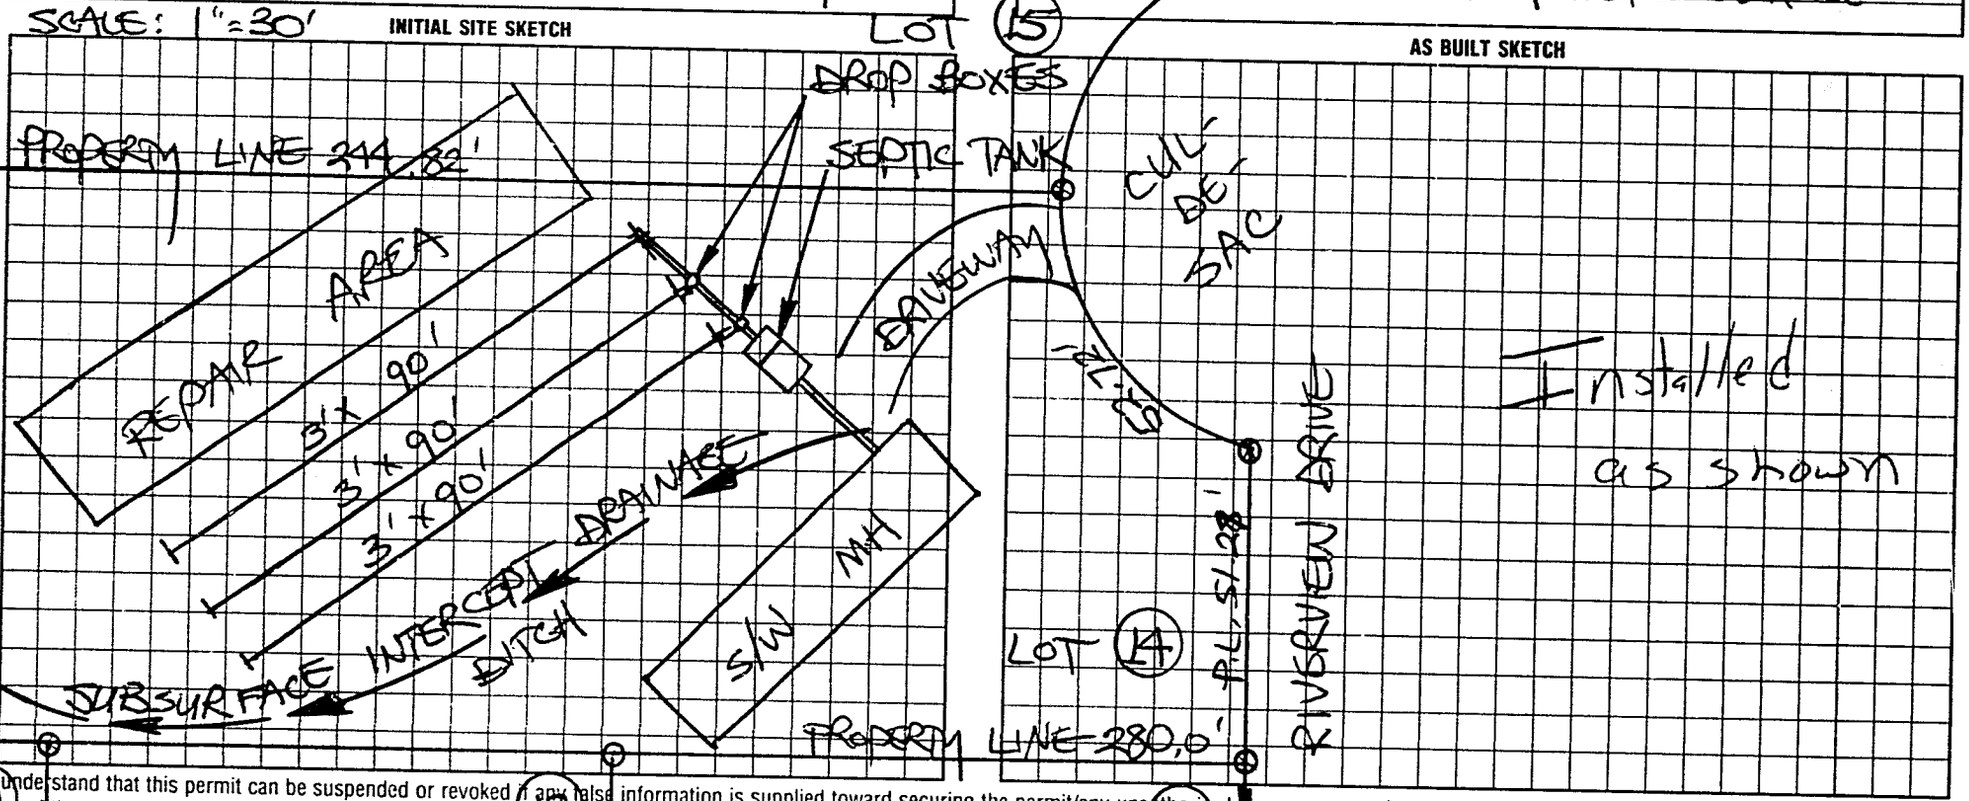

AS BUILT SKETCH

Installed as shown

I understand that this permit can be suspended or revoked if any false information is supplied toward securing the permit/any unauthorized changes are made to the site/any unauthorized changes are made in the installation of the system. Improvement Permit with plat valid without expiration. Improvement Permit with site plan valid for sixty months. Authorization to Construct is valid for a period equal to that of Improvement Permit – not to exceed sixty months.

Signed: Larry Pitman date 3-2-98 Installed by: Union Gravel

Improvement Permit by: STEVE HODRICK date 3-2-98 Operation Permit by: Mark Cloer RS date 4-3-98

Authorization to Construct by: STEVE HODRICK date 3-2-98 Existing System Inspection by: date

HEALTH DEPT COPY WHITE INSPECTION COPY (FINAL) GREEN OWNER COPY (FINAL) YELLOW INSPECTION COPY (INITIAL) PINK OWNER COPY (INITIAL) GOLD