IREDELL COUNTY HEALTH DEPARTMENT

STATESVILLE 704-878-5305 MOORESVILLE 704-664-5281

IMPROVEMENT PERMIT / AUTHORIZATION TO CONSTRUCT / OPERATION PERMIT / EXISTING SYSTEM INSPECTION

PERMIT# 071987 PIN# 4748 34 6237 DATE 3-2-98

OWNER OR CONTRACTOR LARRY & RUTH PITMAN PHONE: Business Home 873-6751

ADDRESS 122 ROCK HAVEN DRIVE, STATESVILLE, NC 28677

LOCATION US 21 N TL JENNINGS, TR EAGLE WOOD, TR RIVERVIEW, LAST LOT ON LEFT

SUBDIVISION IVEY'S OAKS BLOCK / SECTION II LOT 15 LOT AREA 0.48 ACRE SITE CLASS. PS DESIGN FLOW 240 L.T.A.R. 0.30 GPD/FT

Septic Tank: 1000 Gallons; STB 1017 Date 1-23-98

Pump Tank: ____ Gallons; PT ____ Date ____

Pump Make: ____ Model ____ Serial No. ____

Nitrification Field: No Fields 1 Square Feet 810 Linear Feet 270

No Lines THREE Trench Width 36" Max Trench Bottom Depth 30" Gravel Depth 12"

☑ New System ☐ Repair System Type: I II III IV V VI

System Description: CONVENTIONAL GRAVITY

Repair System Description: CONV. GRAVITY

Maintenance Agreement Required: ☐ Yes ☑ No

☐ House/Mod. Home ☑ Mobile Home ☐ Business ☐ Other

No. Bedrooms 2 No. Bathrooms 2 No. Employees ____


☐ Slab ☑ Crawl Space ☐ Basement w/plumbing ☐ Basement wo/plumbing

Water Supply: ☐ Individual ☑ Public ☐ Community


Comments:/Conditions: INSTALL SUBSURFACE INTERCEPT DRAINAGE DITCH ABOVE LOT #14 SEPTIC SYSTEM AS PREREQUISITE TO OPERATION PERMIT FOR LOT #15 (SEE PERMIT #071986)

Comments:/Conditions:

INITIAL SITE SKETCH

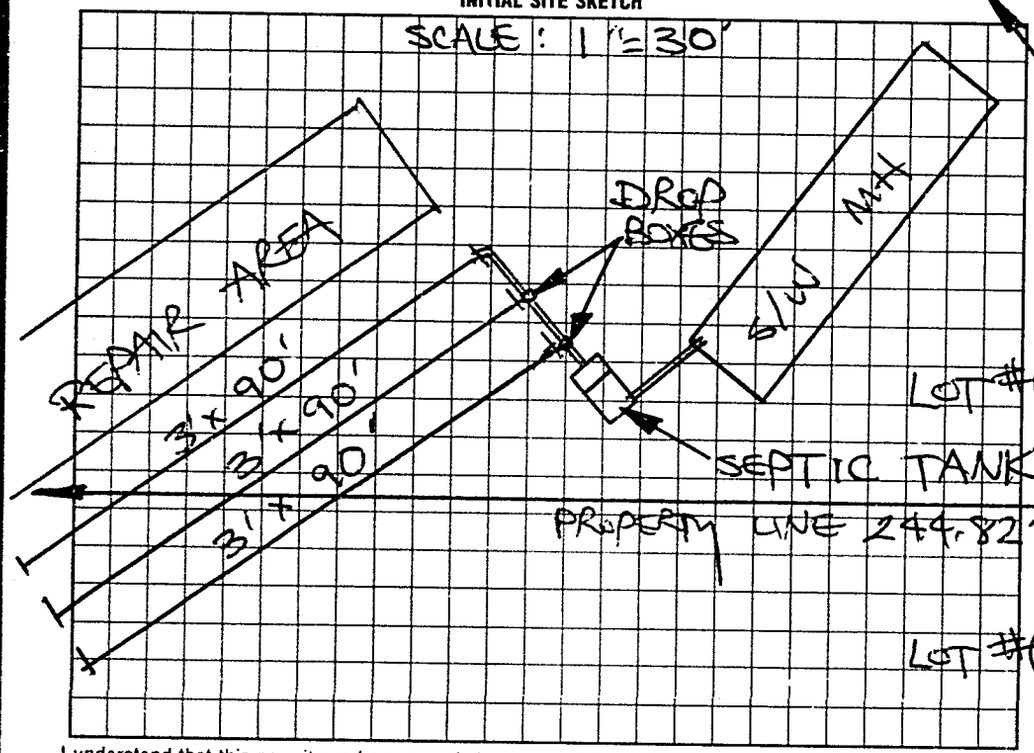

AS BUILT SKETCH

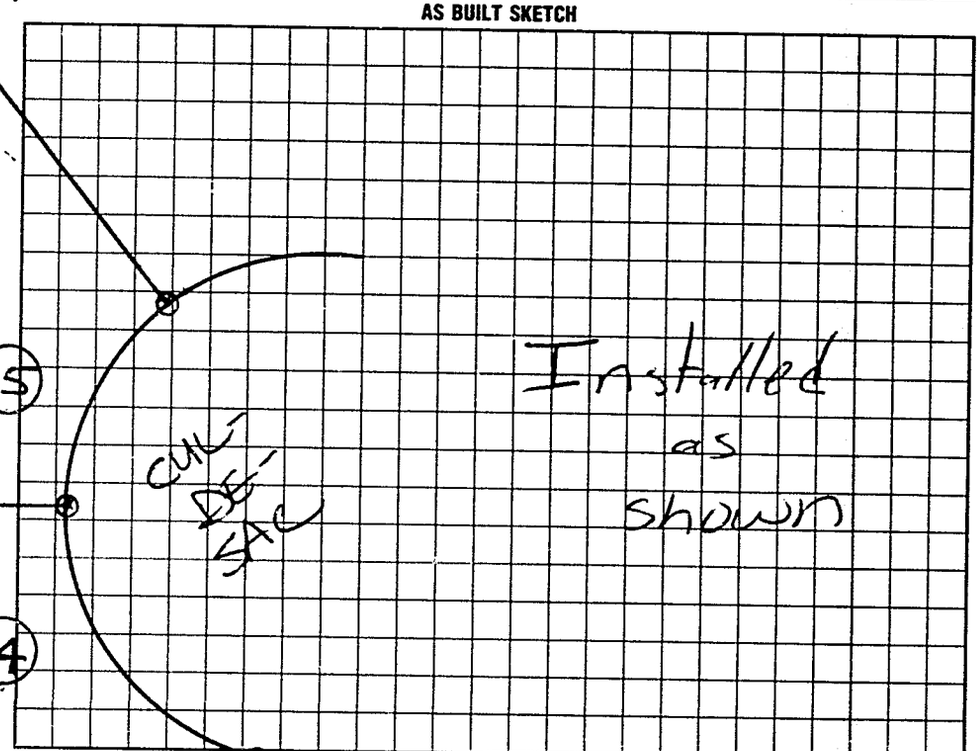

I understand that this permit can be suspended or revoked if any false information is supplied toward securing the permit/any unauthorized changes are made to the site/any unauthorized changes are made in the installation of the system. Improvement Permit with plat valid without expiration. Improvement Permit with site plan valid for sixty months. Authorization to Construct is valid for a period equal to that of Improvement Permit – not to exceed sixty months.

Signed: Larry Pitman date 3-2-98 Installed by: Union Grove

Improvement Permit by: STEVE HEDRICK date 3-2-98 Operation Permit by: Mary Coates date 4-3-98

Authorization to Construct by: STEVE HEDRICK date 3-2-98 Existing System Inspection by: ____ date ____

HEALTH DEPT. COPY. WHITE INSPECTION COPY (FINAL) GREEN OWNER COPY (FINAL) YELLOW INSPECTION COPY (INITIAL) PINK OWNER COPY (INITIAL) GOLD

160800