IREDELL COUNTY HEALTH DEPARTMENT

STATESVILLE 704-878-5305 MOORESVILLE 704-664-5281

IMPROVEMENT PERMIT / AUTHORIZATION TO CONSTRUCT / OPERATION PERMIT / EXISTING SYSTEM INSPECTION

PERMIT# 071057 PIN# 4748346237 DATE 1-5-98

OWNER OR CONTRACTOR LARRY & RUTH PITMAN PHONE: Business Home 873-6751

ADDRESS 122 ROCK HAVEN DRIVE, STATESVILLE NC 28677

LOCATION US 21 N TL JENNINGS RD, TR EAGLEWOOD TR RIVERVIEW, ON RIGHT AT CUL-DE-SAC

SUBDIVISION IVEY'S OAKS BLOCK / SECTION LOT 17 LOT AREA 0.47 27 ACRE SITE CLASS. PS DESIGN FLOW 240 L.T.A.R. 0.30 $90/FT^2$

Septic Tank: 1000 Gallons; STB 1012 Date 1-5-98
Pump Tank: Gallons; PT Date
Pump Make: Model Serial No.
Nitrification Field: No Fields 1 Square Feet 810 Linear Feet 270
No Lines FOUR Trench Width 36" Max Trench Bottom Depth 28" Gravel Depth 12"

☑ New System ☐ Repair System Type: I, II, III, IV, V, VI
System Description: CONVENTIONAL GRAVITY
Repair System Description: PPBDS GRAVITY
Maintenance Agreement Required: ☐ Yes ☑ No


☐ House/Mod. Home No. Bedrooms 2
☑ Mobile Home No. Bathrooms 2
☐ Business No. Employees
☐ Other
☐ Slab ☑ Crawl Space ☐ Basement w/plumbing ☐ Basement wo/plumbing

Water Supply: ☐ Individual ☑ Public ☐ Community

Comments:/Conditions:

Comments:/Conditions:

INITIAL SITE SKETCH SCALE: 1" = 40'

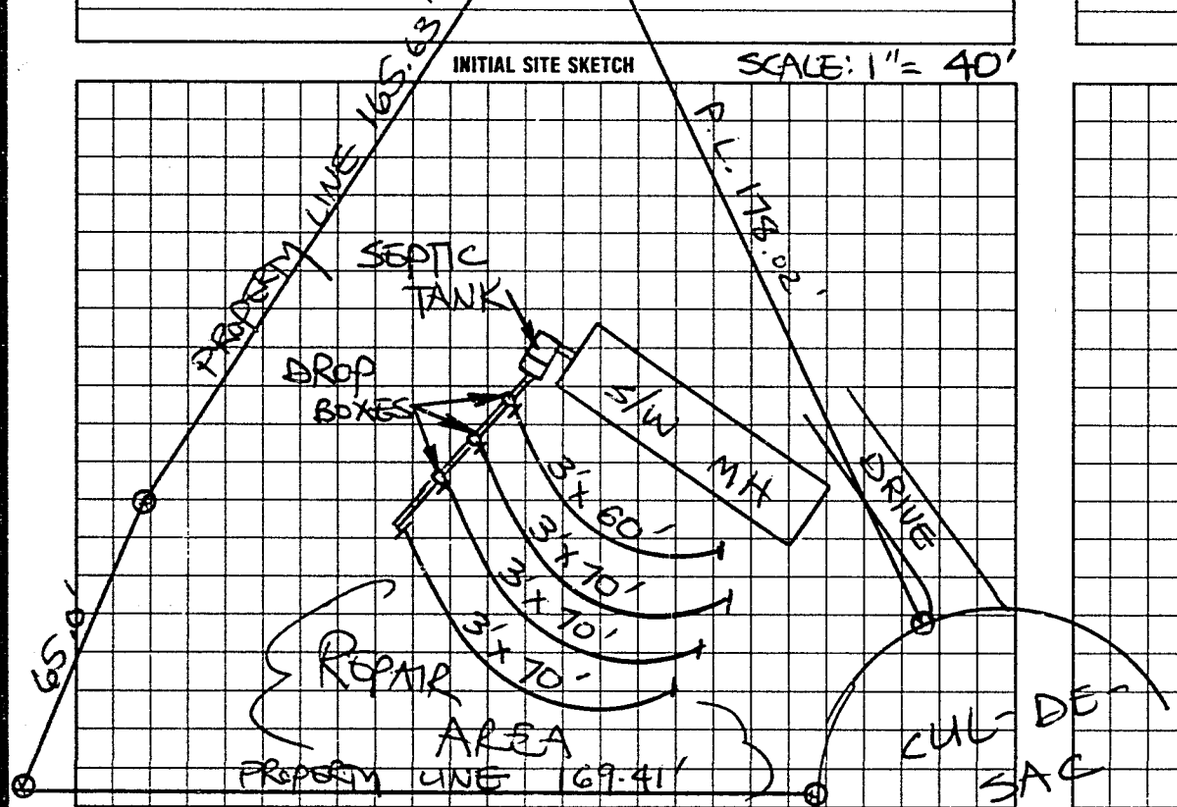

AS BUILT SKETCH

Installed as shown

I understand that this permit can be suspended or revoked if any false information is supplied toward securing the permit/any unauthorized changes are made to the site/any unauthorized changes are made in the installation of the system. Improvement Permit with plat valid without expiration. Improvement Permit with site plan valid for sixty months. Authorization to Construct is valid for a period equal to that of Improvement Permit – not to exceed sixty months.

Signed: Larry Pitman date 1-5-98 Installed by: Union Grove Septic

Improvement Permit by: STEVE HEDRICK date 1-5-98 Operation Permit by: Mark C Dutt RS date 3-30-98

Authorization to Construct by: STEVE HEDRICK date 1-5-98 Existing System Inspection by: date

HEALTH DEPT COPY WHITE INSPECTION COPY (FINAL) GREEN OWNER COPY (FINAL) YELLOW INSPECTION COPY (INITIAL) PINK OWNER COPY (INITIAL) GOLD