IREDELL COUNTY HEALTH DEPARTMENT

STATESVILLE 704-878-5305 MOORESVILLE 704-664-5281

IMPROVEMENT PERMIT / CERTIFICATE OF COMPLETION / OPERATION PERMIT / EXISTING SYSTEM INSPECTION

PROPERTY DESCRIPTION NO. 068036 DATE 7-19-97 TAX MAP NO. 4748346237 Watershed: ☐ Yes ☒ No

OWNER OR CONTRACTOR RUTH PITMAN PHONE: Business Home 873-6751

ADDRESS 122 ROCK HAVEN DRIVE STATESVILLE NC 28677

LOCATION US 21 N, TL JENNINGS RD, TR EAGLEWOOD, TR RIVERVIEW, 2ND LOT ON RIGHT

SUBDIVISION IVEY & OAKS BLOCK / SECTION LOT 18' LOT AREA 0.4681 ACRE SITE CLASS P3 DESIGN FLOW 240 L.T.A.R. 0.30 GPD/FT²

Septic Tank: 1000 Gallons; STB 1012 Date 5-25-97

Pump Tank: Gallons; PT Date

Pump Make: Model Serial No.

Nitrification Field: No Fields 1 Square Feet 810 Linear Feet 270

No Lines THREE Trench Width 36" Max Trench Bottom Depth 30" Gravel Depth 12"

☒ New System ☐ Repair System Type: I, II, III, IV, V, VI

System Description: CONVENTIONAL GRAVITY

Repair System Description: CONV. GRAVITY

Maintenance Agreement Required: ☐ Yes ☒ No

☐ House/Mod. Home No. Bedrooms 3

☒ Mobile Home No. Bathrooms 2

☐ Business No. Employees

☐ Other


☐ Slab ☒ Crawl Space ☐ Basement w/plumbing ☐ Basement wo/plumbing

Water Supply: ☐ Individual ☐ Community ☒ Public


Comments:

Comments:

INITIAL SITE SKETCH SCALE: 1"=40'

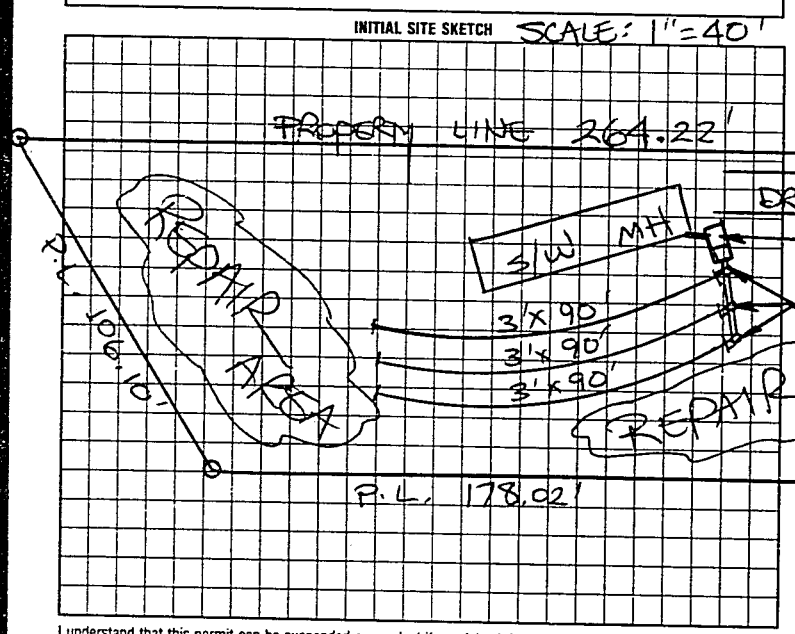

AS BUILT SKETCH

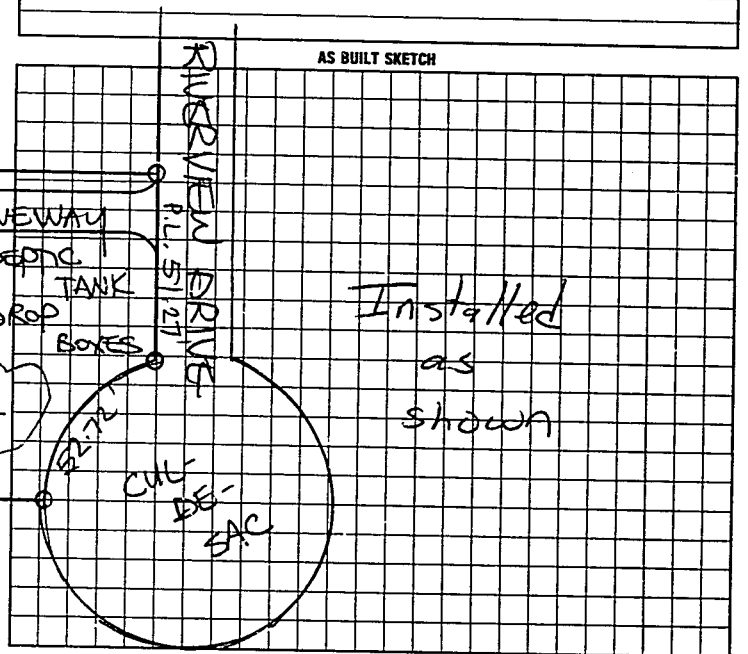

I understand that this permit can be suspended or revoked if any false information is supplied toward securing the permit/any unauthorized changes are made to the site/any unauthorized changes are made in the installation of the system. Improvement Permit is valid for 60 months from date of issuance. AUTHORIZATION TO CONSTRUCT IS VALID FOR 60 MONTHS FROM DATE OF ISSUANCE.

Signed: Ruth Pitman

Improvement Permit by: STEVE HEDRICK date 7-19-97

AUTH. TO CONST. ~~Existing System Inspection~~ by: STEVE HEDRICK date 7-19-97

Installed by: Jeff Hedrick

~~Certificate of Completion by:~~ date

Operation Permit by: [signature] date 8-1-97

HEALTH DEPT COPY WHITE | INSPECTION COPY (FINAL) GREEN | OWNER COPY (FINAL) YELLOW | INSPECTION COPY (INITIAL) PINK | OWNER COPY (INITIAL) GOLD

282200