53395 Direct Products 60445 [struck-out number]

IREDELL COUNTY HEALTH DEPARTMENT

STATESVILLE 704-878-5305 MOORESVILLE 704-664-5281

IMPROVEMENT PERMIT / CERTIFICATE OF COMPLETION / OPERATION PERMIT / EXISTING SYSTEM INSPECTION

PROPERTY DESCRIPTION NO. 23579 DATE 4-27-96 TAX MAP NO. 13D-1-A-1 Watershed: ☐ Yes ☒ No

OWNER OR CONTRACTOR RUTH PITMAN PHONE: Business 838-6486 Home 873-6751

ADDRESS 122 ROCKHAVEN DRIVE, STATESVILLE, NC 28677

LOCATION US 21 N, TL JENNINGS RD, TR EAGLEWOOD, LOT ON RIGHT AT RIVERVIEW ROAD.

SUBDIVISION IVEY & OAKS MHP BLOCK / SECTION LOT 19 LOT AREA 0.3424 AC SITE CLASS PS DESIGN FLOW 240 LTAR 0.33 GPD/FT²

Septic Tank: 1000 Gallons; STB 794 Date 1-30-96

Pump Tank: Gallons; PT Date

Pump Make: Model Serial No.

Nitrification Field: No Fields 1 Square Feet 720 Linear Feet 240

No Lines 4 Trench Width 36" Max Trench Bottom Depth 18-36" Gravel Depth 12"

☒ New System ☐ Repair System Type: I, II, III, IV, V, VI

System Description: CONVENTIONAL GRAVITY

Repair System Description: CONV. GRAVITY

Maintenance Agreement Required: ☐ Yes ☒ No

☐ Slab ☒ Crawl Space ☐ Basement w/plumbing ☐ Basement wo/plumbing

☐ House/Mod. Home ☒ Mobile Home ☐ Business ☐ Other


No. Bedrooms 2 No. Bathrooms 2 No. Employees

Water Supply: ☐ Individual ☐ Community ☐ Public

Comments: ① KEEP SYSTEM MINIMUM 10' FROM WATER LINE ② INSTALL LINES ON CONTOUR, NO DEEPER THAN 36", 9' O.C.

Comments:

INITIAL SITE SKETCH

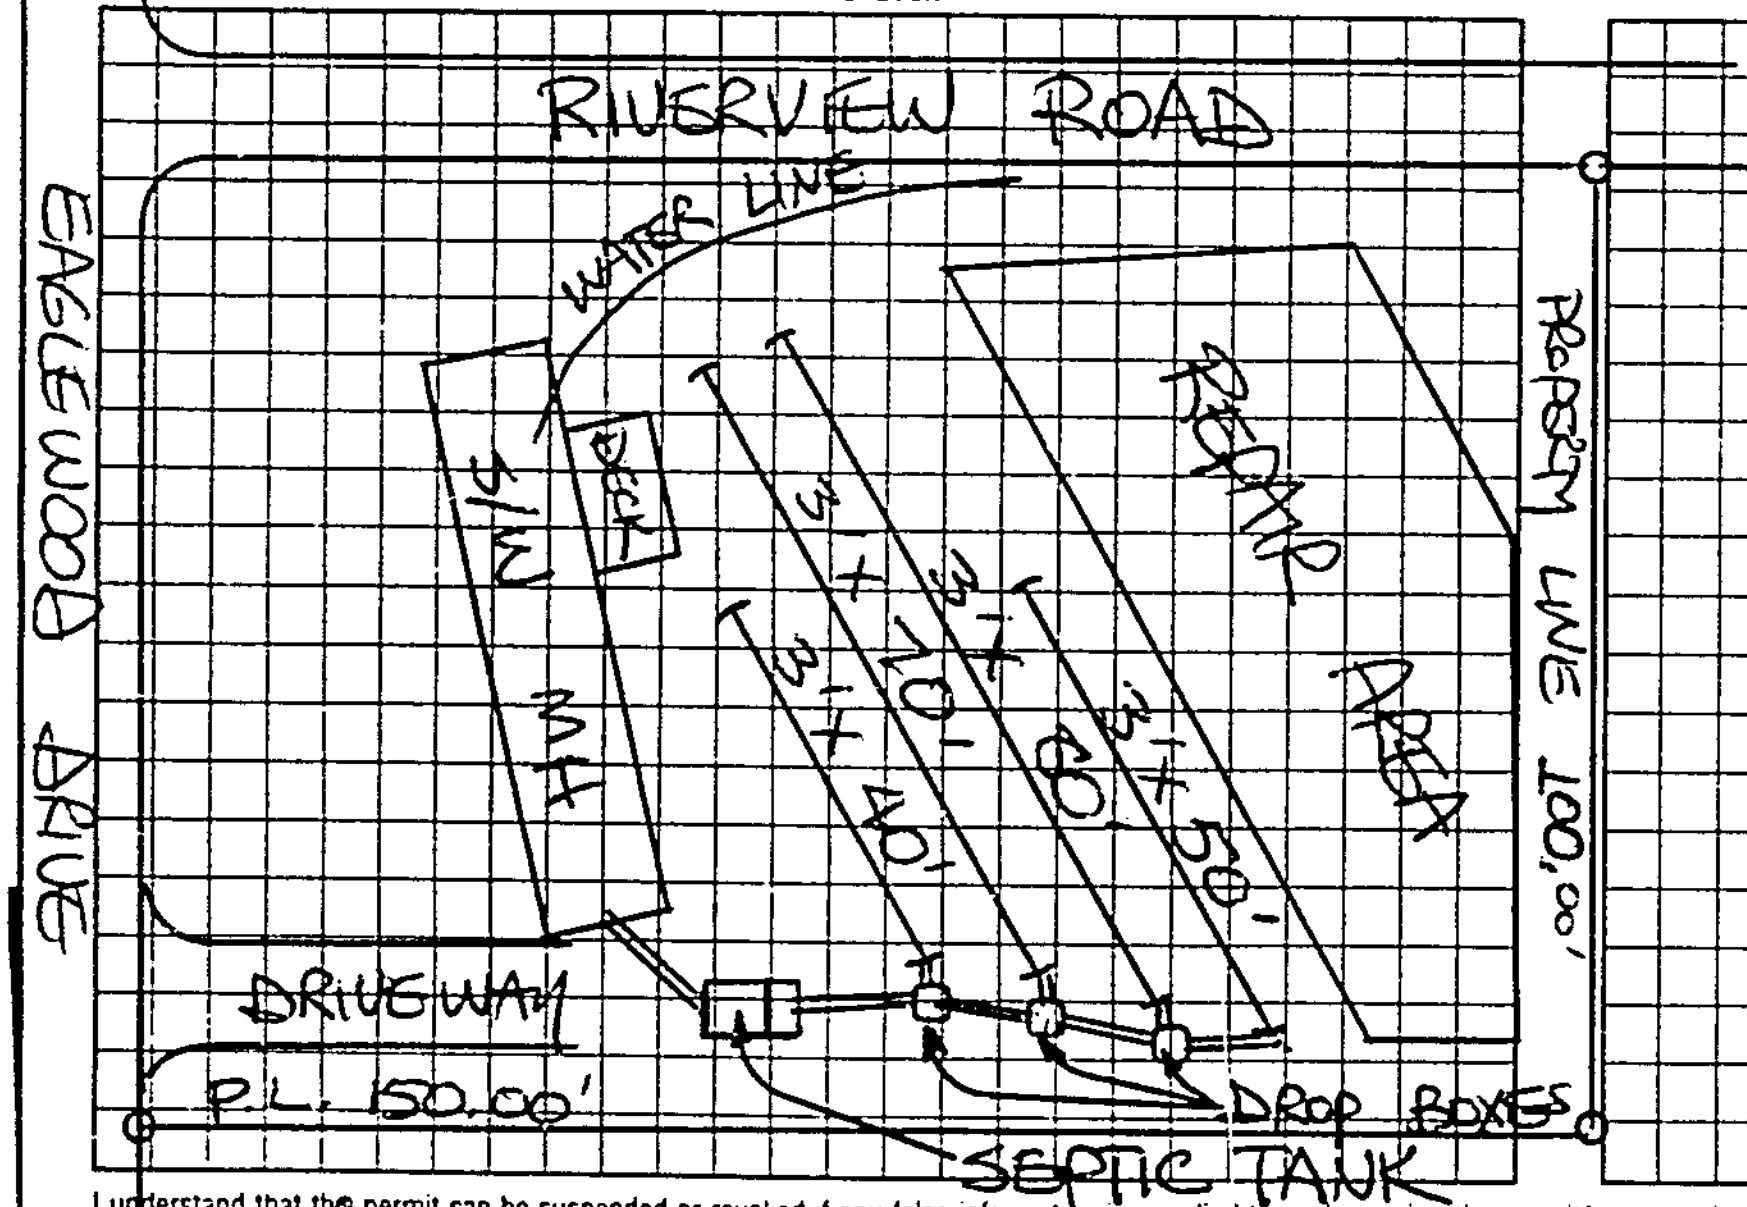

AS BUILT SKETCH

SYSTEM INSTALLED ACCORDING TO INITIAL SITE SKETCH

I understand that this permit can be suspended or revoked if any false information is supplied toward securing the permit/any unauthorized changes are made to the site/any unauthorized changes are made in the installation of the system.

Authorization to ~~Construct is~~ valid five (5) years from date of issuance. Improvement Permit has no expiration date.

Signed: [signature] Installed by: A-1 BACKHOE

Improvement Permit by: STEVE HEDRICK date 4-27-96 Certificate of Completion by: date

Existing System Inspection by: AUTHORIZATION TO CONSTRUCT: STEVE HEDRICK date 4-27-96 Operation Permit by: STEVE HEDRICK date 5-2-96

HEALTH DEPT COPY WHITE INSPECTION COPY (FINAL) GREEN OWNER COPY (FINAL) YELLOW INSPECTION COPY (INITIAL) PINK OWNER COPY (INITIAL) GOLD

00187 8