IREDELL COUNTY HEALTH DEPARTMENT

STATESVILLE 704-878-5305 MOORESVILLE 704-664-5281

IMPROVEMENT PERMIT / CERTIFICATE OF COMPLETION / OPERATION PERMIT / EXISTING SYSTEM INSPECTION

PROPERTY DESCRIPTION NO. 17826 DATE 3/3/94 TAX MAP NO. 13D-A-1

OWNER OR CONTRACTOR LARRY & RUTH PITMAN PHONE: Business Home 873-6751 Watershed: ☐ Yes ☑ No

ADDRESS RT. 6 Box 494 STVL, NC 28677

LOCATION US 21 N, TL JENNINGS ROAD, CROSS S. YADKIN RIVER 1ST MAP ON (R)

SUBDIVISION IVEY & OAKS MHP BLOCK / SECTION LOT 2 LOT AREA 90X150 SITE CLASS. PS' DESIGN FLOW 240 L.T.A.R. 0.33 GPD/FT²

Septic Tank: 1000 Gallons; STB 794 Date 12/6/93

Pump Tank: Gallons; PT Date

Pump Make: Model Serial No.

Nitrification Field: No Fields 1 Square Feet 720 Linear Feet 240

No Lines 4 Trench Width 36" Max Trench Bottom Depth 36" Gravel Depth 12"

☑ New System ☐ Repair System Type: I, II, III, IV, V, VI

System Description: CONV. GRAVITY

Repair System Description:

Maintenance Agreement Required: ☐ Yes ☐ No

☐ House/Mod. Home No. Bedrooms 2

☑ Mobile Home No. Bathrooms 1

☐ Business No. Employees

☐ Other


☐ Slab ☑ Crawl Space ☐ Basement w/plumbing ☐ Basement wo/plumbing

Water Supply: ☐ Individual ☐ Community ☑ Public


Comments: ① KEEP SYSTEM MINIMUM 5' FROM MH 10' FROM WATER LINE, 20' FROM OTHER SYSTEMS ② INSTALL LINES ON CONTOUR NO DEEPER THAN 36", 9' APART ON CENTER

Comments: ① KEEP VEHICULAR TRAFFIC OFF SYSTEM ② KEEP WATER LINE 10' FROM SYSTEM

INITIAL SITE SKETCH

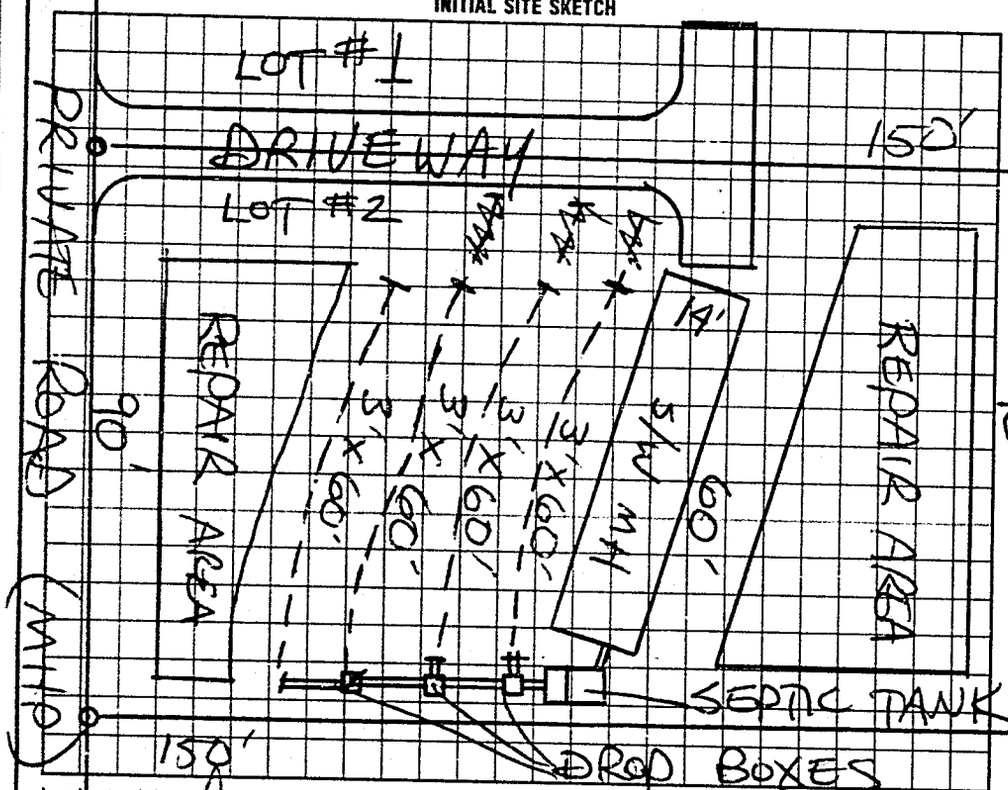

AS BUILT SKETCH

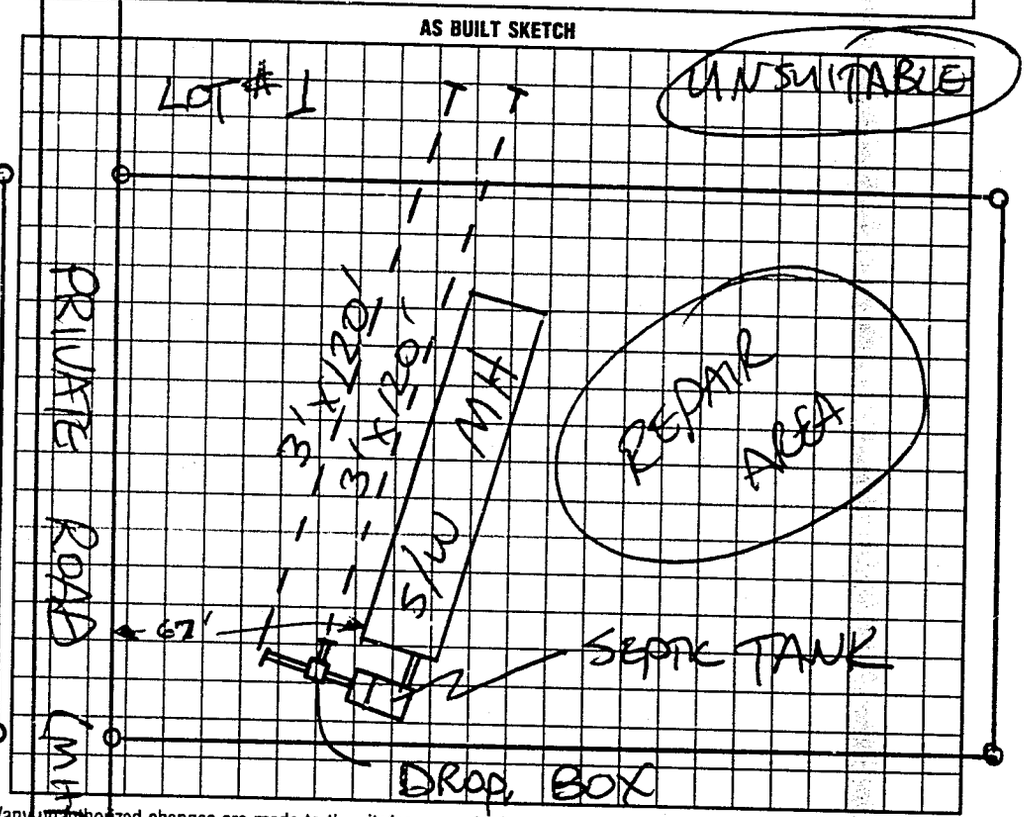

I understand that this permit can be suspended or revoked if any false information is supplied toward securing the permit/any unauthorized changes are made to the site/any unauthorized changes are made in the installation of the system. Improvement Permit is valid for 60 months from date of issuance.

Signed: Larry Pitman

Improvement Permit by: STEVE HEDRICK date 3/3/94

Existing System Inspection by: date

Installed by: A-1 BACK HOE

Certificate of Completion by: STEVE HEDRICK date 4/29/94

Operation Permit by: date

HEALTH DEPT. COPY: WHITE INSPECTION COPY (FINAL): GREEN OWNER COPY (FINAL): YELLOW INSPECTION COPY (INITIAL): PINK OWNER COPY (INITIAL): GOLD