IREDELL COUNTY HEALTH DEPARTMENT

STATESVILLE 704-878-5305 MOORESVILLE 704-664-5281

IMPROVEMENT PERMIT / CERTIFICATE OF COMPLETION / OPERATION PERMIT / EXISTING SYSTEM INSPECTION

PROPERTY DESCRIPTION NO. 068037 DATE 7-19-97 TAX MAP NO. 4748346237 Watershed: ☐ Yes ☒ No

OWNER OR CONTRACTOR RUTH PITMAN PHONE: Business Home 873-6751

ADDRESS 122 ROCK HAVEN DRIVE, STATESVILLE, NC 28677

LOCATION US 21 N. TO JENNINGS ROAD TO EAGLEWOOD DRIVE, 2ND LOT ON RIGHT

SUBDIVISION IVEY'S OAKS BLOCK / SECTION LOT 20 LOT AREA 0.3099 ACRES SITE CLASS. PS DESIGN FLOW 240 L.T.A.R. D30-GPD/FT²

Septic Tank: 1000 Gallons; STB 1012 Date 5-27-97

Pump Tank: Gallons; PT Date

Pump Make: Model Serial No.

Nitrification Field: No Fields 1 Square Feet 840 Linear Feet 280

No Lines FOUR Trench Width 36" Max Trench Bottom Depth 30"

☒ New System ☐ Repair System Type: I, II, III, IV, V, VI

System Description: CONVENTIONAL GRAVITY

Repair System Description: CHAMBER GRAVITY

Maintenance Agreement Required: ☐ Yes ☒ No

Gravel Depth 12"

☐ House/Mod. Home No. Bedrooms 3

☒ Mobile Home No. Bathrooms 2

☐ Business No. Employees

☐ Other


☐ Slab ☒ Crawl Space ☐ Basement w/plumbing ☐ Basement wo/plumbing

Water Supply: ☐ Individual ☐ Community ☒ Public


Comments:

Comments:

INITIAL SITE SKETCH SCALE: 1" = 30'

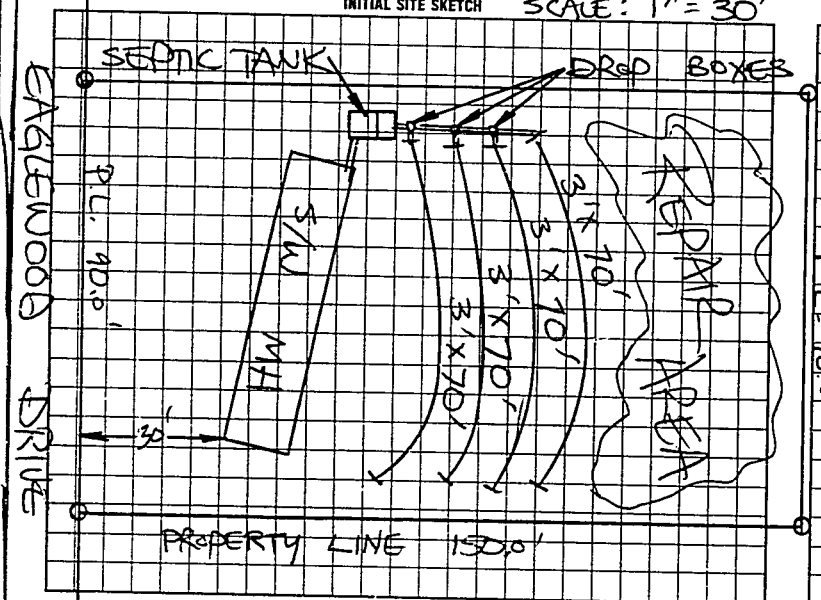

AS BUILT SKETCH

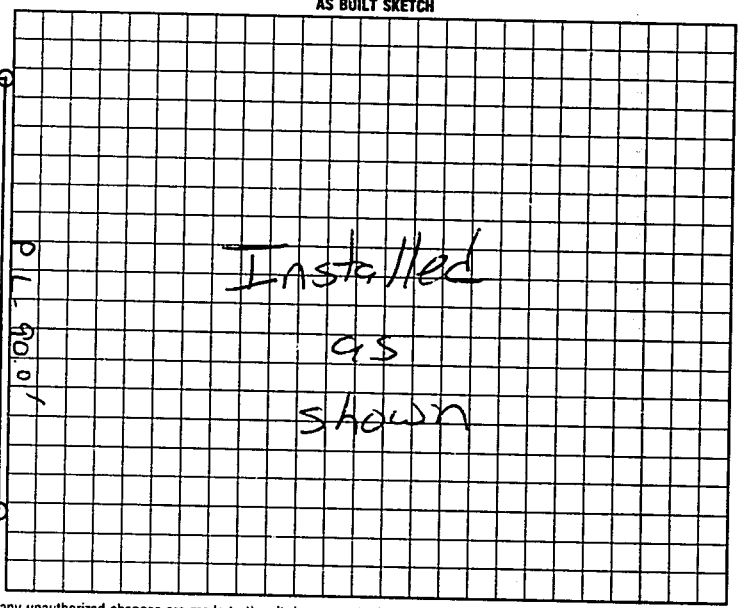

I understand that this permit can be suspended or revoked if any false information is supplied toward securing the permit/any unauthorized changes are made to the site/any unauthorized changes are made in the installation of the system. Improvement Permit is valid for 60 months from date of issuance. AUTHORIZATION TO CONSTRUCT IS VALID FOR 60 MONTHS FROM DATE OF ISSUANCE.

Signed: Ruth Pitman

Improvement Permit by: STEVE HEDRICK date 7-19-97

AUTH TO CONST

~~Existing System Inspection~~ by: STEVE HEDRICK date 7-19-97

Installed by: Jeff Hurlart

~~Certificate of Completion by:~~ date

Operation Permit by: Mark C Ott TS date 8-4-97

HEALTH DEPT COPY WHITE INSPECTION COPY (FINAL) GREEN OWNER COPY (FINAL) YELLOW INSPECTION COPY (INITIAL) PINK OWNER COPY (INITIAL) GOLD