IREDELL COUNTY HEALTH DEPARTMENT

STATESVILLE 704-878-5305 MOORESVILLE 704-664-5281

IMPROVEMENT PERMIT / CERTIFICATE OF COMPLETION / OPERATION PERMIT / EXISTING SYSTEM INSPECTION

PROPERTY DESCRIPTION NO. 23167 DATE 3-6-96 TAX MAP NO 13D-A-1 (PART) Watershed: Yes ✓No

OWNER OR CONTRACTOR RUTH & LARRY PITMAN PHONE Business Home 873-6751

ADDRESS RT. 6, BOX 494 STATESVILLE, NC 28677

LOCATION US 21 N, TL JENNINGS RD TR, IVEY & OAKS MHP, 1ST LOT ON RIGHT (~200')

SUBDIVISION IVEY & OAKS BLOCK / SECTION LOT 21 LOT AREA 0.4109 AC SITE CLASS PS1 DESIGN FLOW 240 L.T.A.R 0.336gpd/ft²

Septic Tank: 1000 Gallons. STB 1012 Date 12-19-95

Pump Tank: Gallons: PT Date

Pump Make: Model Serial No

Nitrification Field: No Fields 1 Square Feet 720 Linear Feet 240

No Lines 3 Trench Width 36" Max Trench Bottom Depth 18-36" Gravel Depth 12"

✓New System Repair System Type I II III IV V VI

System Description CONVENTIONAL GRAVITY

Repair System Description CONV. GRAVITY

Maintenance Agreement Required Yes ✓No

Slab ✓Crawl Space Basement w/plumbing Basement wo/plumbing

✓Mobile Home House/Mod Home No Bedrooms 2

Business No Bathrooms 1


Other No Employees

Water Supply: Individual, Community, ✓Public

Comments:

Comments

INITIAL SITE SKETCH

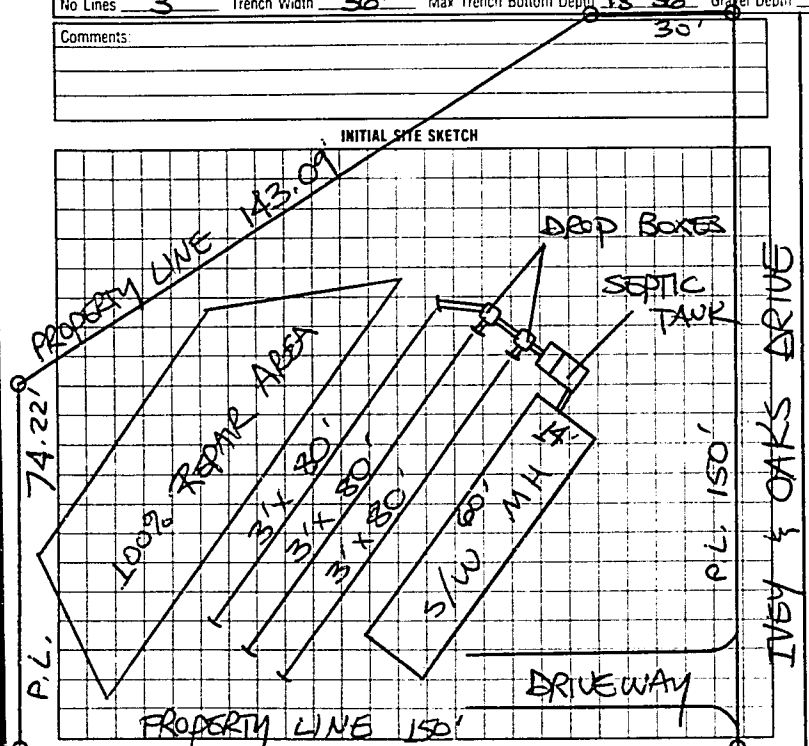

AS BUILT SKETCH

SYSTEM INSTALLED ACCORDING TO INITAL SITE SKETCH

I understand that this permit can be suspended or revoked if any false information is supplied toward securing the permit, any unauthorized changes are made to the site/any unauthorized changes are made in the installation of the system

AUTHORIZATION TO CONSTRUCT IS VALID FIVE (5) YEARS FROM DATE OF ISSUANCE. IMPROVEMENT PERMIT HAS NO EXPIRATION DATE.

Signed Ruth Pitman

Improvement Permit by STEVE HEDRICK date 3-6-96

AUTHORIZATION TO CONSTRUCT

~~Existing System Inspection~~ by STEVE HEDRICK date 3-6-96

Installed by DONALD LACKEY

~~Certificate of Completion~~ by date

Operation Permit by STEVE HEDRICK date 3-13-96

HEALTH DEPT COPY WHITE | INSPECTION COPY (FINAL) GREEN | OWNER COPY (FINAL) YELLOW | INSPECTION COPY (INITIAL) PINK | OWNER COPY (INITIAL) GOLD

188100