IREDELL COUNTY HEALTH DEPARTMENT

STATESVILLE 704-878-5305 MOORESVILLE 704-664-5281

IMPROVEMENT PERMIT / CERTIFICATE OF COMPLETION / OPERATION PERMIT / EXISTING SYSTEM INSPECTION

PROPERTY DESCRIPTION NO. 18156 DATE 4/4/94 TAX MAP NO. 13.D-A-1 Watershed: ☐ Yes ☑ No

OWNER OR CONTRACTOR RUTH PITMAN PHONE: Business _____ Home 873-6751

ADDRESS RT. 6, BOX 494 STVL NC 28677

LOCATION US21 N TL JENNINGS ROAD, TR IVEY'S OAKS MHP, 3RD LOT ON (L)

SUBDIVISION IVEY'S OAKS MHP BLOCK / SECTION _____ LOT 3 LOT AREA 90'x150' SITE CLASS. PS DESIGN FLOW 240 L.T.A.R. 0.35 GPD/FT2

Septic Tank: 1000 Gallons; STB 794 Date 12/3/93

Pump Tank: _____ Gallons; PT _____ Date _____

Pump Make: _____ Model _____ Serial No. _____

Nitrification Field: No Fields 1 Square Feet 690 Linear Feet 230

No Lines 3 Trench Width 36" Max Trench Bottom Depth 18-36" Gravel Depth 12"

☑ New System ☐ Repair System Type: I, (II), III, IV, V, VI

System Description: CONV. GRAVITY

Repair System Description: CONV. GRAVITY

Maintenance Agreement Required: ☐ Yes ☐ No

☐ House/Mod. Home ☑ Mobile Home ☐ Business ☐ Other

No. Bedrooms 2 No. Bathrooms 1 No. Employees ____


☐ Slab ☑ Crawl Space ☐ Basement w/plumbing ☐ Basement wo/plumbing

Water Supply: ☐ Individual ☑ Community ☑ Public ~~WELL~~

Comments:

Comments:

INITIAL SITE SKETCH

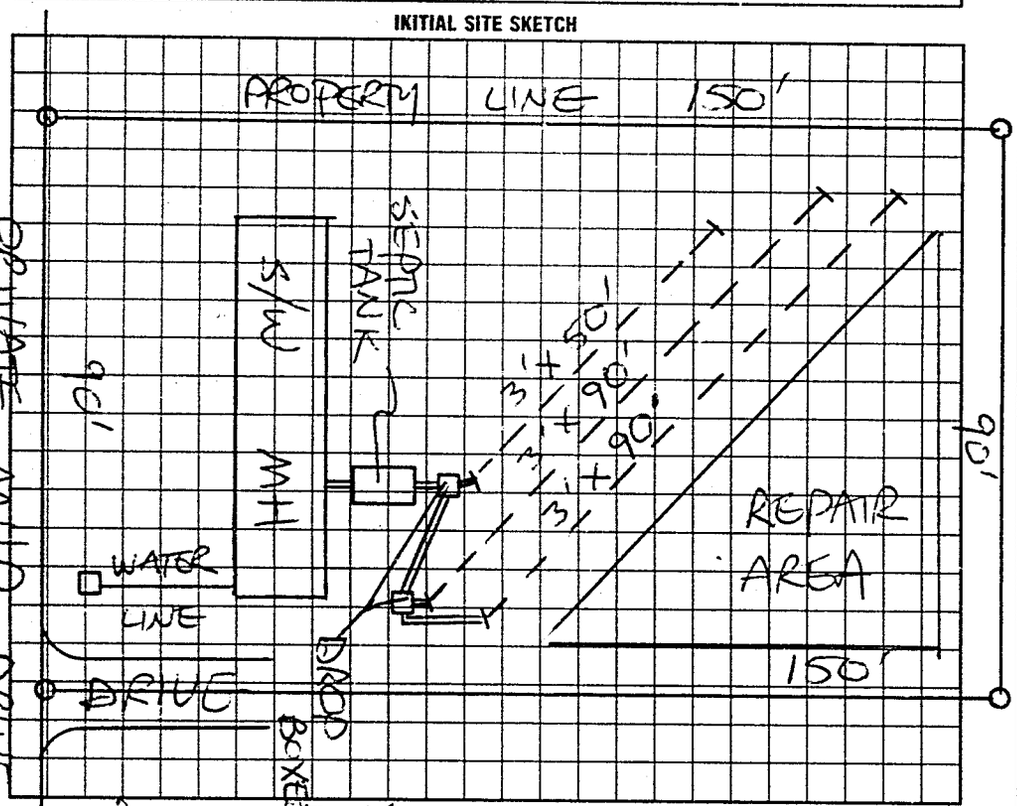

AS BUILT SKETCH

SYSTEM INSTALLED ACCORDING TO INITIAL SITE SKETCH

I understand that this permit can be suspended or revoked if any false information is supplied toward securing the permit/any unauthorized changes are made to the site/any unauthorized changes are made in the installation of the system. Improvement Permit is valid for 60 months from date of issuance.

Signed: Larry Pitman

Improvement Permit by: STEVE HEDRICK date 4/9/94

Existing System Inspection by: _____ date _____

Installed by: A-1 BACKHOE

Certificate of Completion by: STEVE HEDRICK date 4/29/94

Operation Permit by: _____ date _____

HEALTH DEPT. COPY: WHITE INSPECTION COPY (FINAL): GREEN OWNER COPY (FINAL): YELLOW INSPECTION COPY (INITIAL): PINK OWNER COPY (INITIAL): GOLD