IREDELL COUNTY HEALTH DEPARTMENT

STATESVILLE 704-878-5305 MOORESVILLE 704-664-5281

IMPROVEMENT PERMIT / CERTIFICATE OF COMPLETION / OPERATION PERMIT / EXISTING SYSTEM INSPECTION

PROPERTY DESCRIPTION NO. 19320 DATE 9/2/94 TAX MAP NO. 130-1-A-1 Watershed: ☐ Yes ☑ No

OWNER OR CONTRACTOR LARRY & RUTH PITMAN PHONE: Business Home 873-6751

ADDRESS RT. 6, BOX 494, STATESVILLE, NC 28677

LOCATION US 21 N, TL JENNINGS RD, CROSS S. YADKIN RIVER, ~1500' TR MHP, 4TH LOT ON LEFT

SUBDIVISION IVEY & OAKS BLOCK / SECTION LOT 5 LOT AREA 90 X 150' SITE CLASS. PS DESIGN FLOW 240' L.T.A.R. 0.336 AD/FT

Septic Tank: 1000 Gallons; STB 1012 Date 7/29/94

Pump Tank: Gallons; PT Date

Pump Make: Model Serial No.

Nitrification Field: No Fields 1 Square Feet 720 Linear Feet 240

No Lines 3 Trench Width 36" Max Trench Bottom Depth 18-36" Gravel Depth 12"

☑ New System ☐ Repair System Type: I, II, III, IV, V, VI

System Description: CONVENTIONAL GRAVITY

Repair System Description: CONV. GRAVITY

Maintenance Agreement Required: ☐ Yes ☑ No

☐ House/Mod. Home ☑ Mobile Home ☐ Business ☐ Other

No. Bedrooms 2 No. Bathrooms 1 No. Employees


☐ Slab ☑ Crawl Space ☐ Basement w/plumbing ☐ Basement wo/plumbing

Water Supply: ☐ Individual ☐ Community ☑ Public

Comments: (1) KEEP SYSTEM MINIMUM 5' FROM MH, 10' FROM PROPERTY LINE, 10' FROM WATER LINE (2) INSTALL LINES ON CONTOUR, NO DEEPER THAN 36", 9' APART MINIMUM ON CENTER

Comments:

INITIAL SITE SKETCH

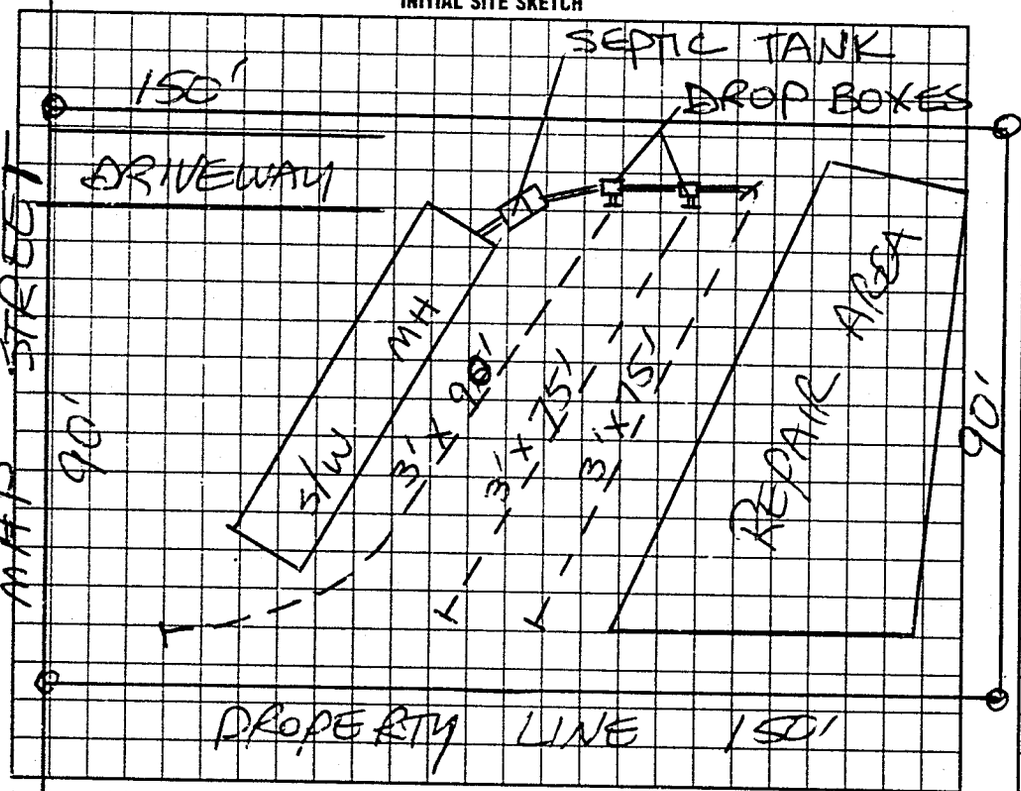

AS BUILT SKETCH

SYSTEM INSTALLED ACCORDING TO INITAL SITE SKETCH

I understand that this permit can be suspended or revoked if any false information is supplied toward securing the permit/any unauthorized changes are made to the site/any unauthorized changes are made in the installation of the system. Improvement Permit is valid for 60 months from date of issuance.

Signed: Ruth Pitman

Improvement Permit by: STEVE HEDRICK date 9/2/94

Existing System Inspection by: date

Installed by: JUNIOR HARTNESS

Certificate of Completion by: STEVE HEDRICK date 10/12/94

Operation Permit by: date

HEALTH DEPT. COPY: WHITE INSPECTION COPY (FINAL) GREEN OWNER COPY (FINAL) YELLOW INSPECTION COPY (INITIAL) PINK OWNER COPY (INITIAL): GOLD

506100