IREDELL COUNTY HEALTH DEPARTMENT

STATESVILLE 704-878-5305 MOORESVILLE 704-664-5281

IMPROVEMENT PERMIT / CERTIFICATE OF COMPLETION / OPERATION PERMIT / EXISTING SYSTEM INSPECTION

PROPERTY DESCRIPTION NO. 1932 DATE 9/2/94 TAX MAP NO. 13D-1-A-1 Watershed: ☐ Yes ☒ No

OWNER OR CONTRACTOR LARRY & RUTH PITMAN PHONE: Business Home 873-6751

ADDRESS RT. 6, BOX 494, STATESVILLE, NC 28677

LOCATION US 21 N, TL JENNINGS RD, CROSS S. YADKIN RIVER, TR 1500', 5TH LOT ON LEFT

SUBDIVISION IVEY'S OAKS BLOCK / SECTION LOT 6 LOT AREA 90X150' SITE CLASS. PS DESIGN FLOW 240 L.T.A.R. 0.33 GPD/FT²

Septic Tank: 1000 Gallons; STB 1012 Date 7/29/94

Pump Tank: Gallons; PT Date

Pump Make: Model Serial No.

Nitrification Field: No Fields 1 Square Feet 720 Linear Feet 240

No Lines 3 Trench Width 36" Max Trench Bottom Depth 18-36" Gravel Depth 12"

☒ New System ☐ Repair System Type: I, II, III, IV, V, VI

System Description: CONVENTIONAL GRAVITY

Repair System Description: CONV. GRAVITY

Maintenance Agreement Required: ☐ Yes ☒ No

☐ House/Mod. Home No. Bedrooms 2

☒ Mobile Home No. Bathrooms 1

☐ Business No. Employees

☐ Other


☐ Slab ☒ Crawl Space ☐ Basement w/plumbing ☐ Basement wo/plumbing

Water Supply: ☐ Individual ☐ Community ☒ Public


Comments: ① KEEP SYSTEM MINIMUM 5' FROM MH, 10' FROM PROPERTY LINE, 10' FROM WATER LINE ② INSTALL LINES ON CONTOUR AS FLAGGED, NO DEEPER THAN 36", 9' APART MINIMUM O.C.

Comments:

INITIAL SITE SKETCH

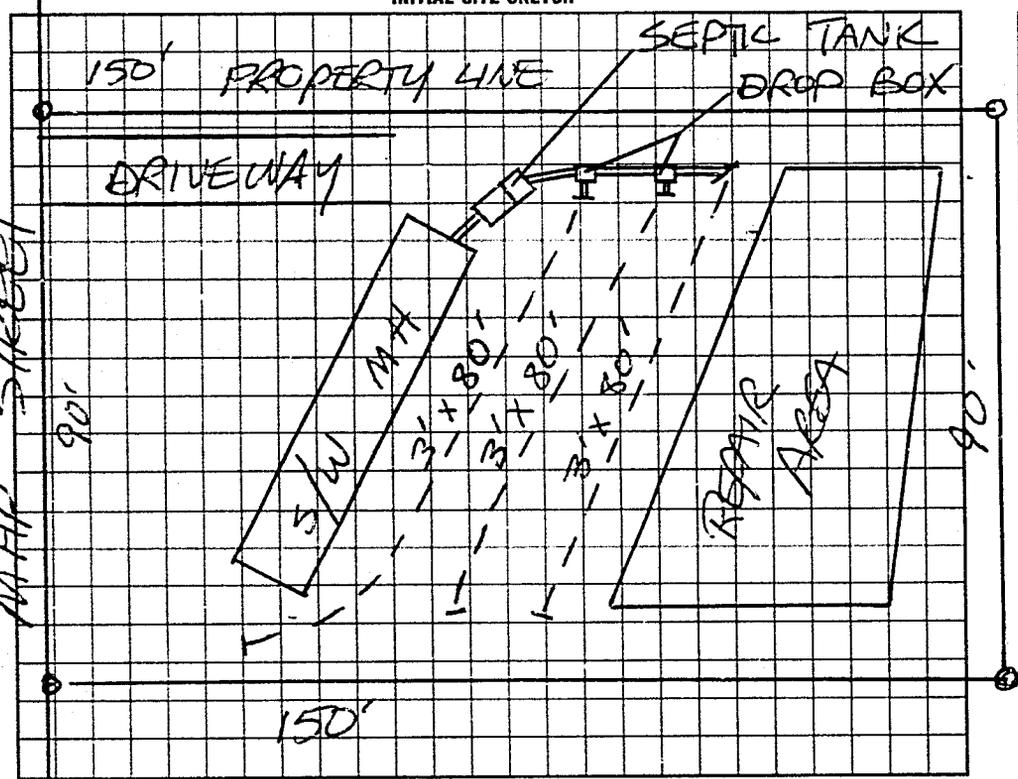

AS BUILT SKETCH

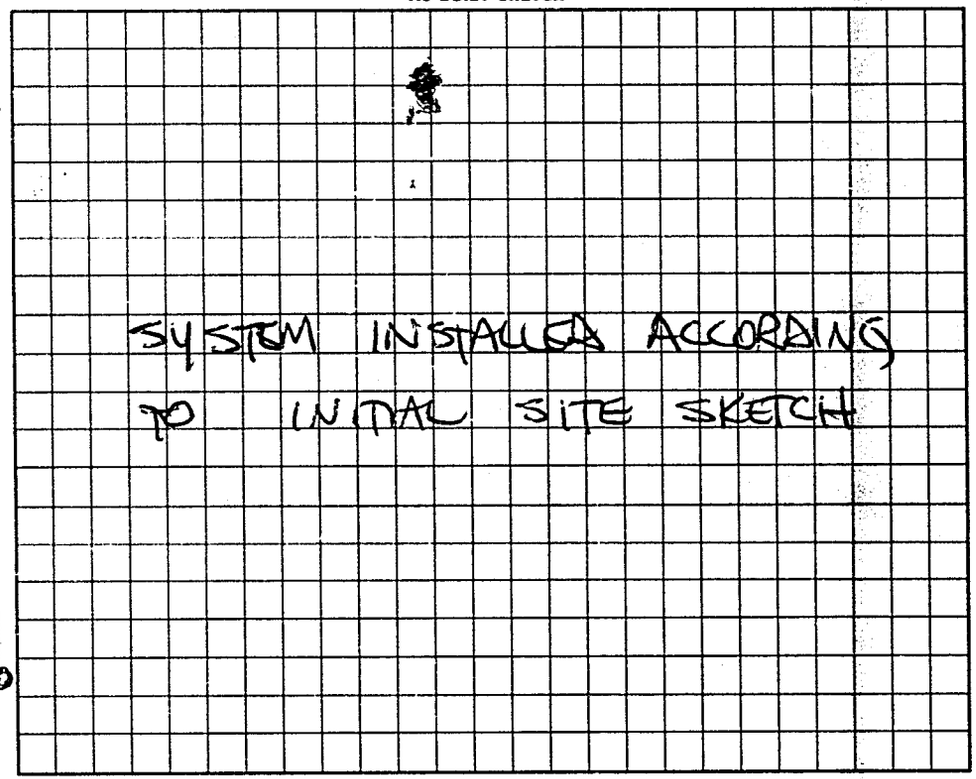

I understand that this permit can be suspended or revoked if any false information is supplied toward securing the permit/any unauthorized changes are made to the site/any unauthorized changes are made in the installation of the system. Improvement Permit is valid for 60 months from date of issuance.

Signed: Ruth Pitman

Improvement Permit by: STEVE HEDRICK date 9/2/94

Existing System Inspection by: date

Installed by: JUNIOR HARGNESS

Certificate of Completion by: STEVE HEDRICK date 10/12/94

Operation Permit by: date

HEALTH DEPT. COPY: WHITE INSPECTION COPY (FINAL): GREEN OWNER COPY (FINAL): YELLOW INSPECTION COPY (INITIAL): PINK OWNER COPY (INITIAL): GOLD

8 0 6 1 0 0