3-8-96 Pd $150 m.B

IREDELL COUNTY HEALTH DEPARTMENT

STATESVILLE 704-878-5305 MOORESVILLE 704-664-5281

IMPROVEMENT PERMIT / CERTIFICATE OF COMPLETION / OPERATION PERMIT / EXISTING SYSTEM INSPECTION

PROPERTY DESCRIPTION NO 23167 DATE 3-5-96 TAX MAP NO PART OF 13D-A-1 Watershed: Yes ✓ No

OWNER OR CONTRACTOR RUTH & LARRY PITTMAN PHONE: Business Home 873-6751

ADDRESS RT. 6, BOX 494 STATESVILLE, NC 28677

LOCATION US 21 N, TL JENNINGS RD, TR IVEY & OAKS, LOT AT END ON LEFT

SUBDIVISION IVEY & OAKS MAP BLOCK / SECTION LOT 9 LOT AREA ~116 x 150' SITE CLASS PS DESIGN FLOW 240 L.T.A.R 0.33 GPD/FT²

Septic Tank: 1000 Gallons STB 1012 Date 12-17-95
Pump Tank: Gallons PT Date
Pump Make: Model EQUIVALENT Serial No 180 EQUIVALENT
Nitrification Field No Fields 1 Square Feet 720 Linear Feet 240 ?
No Lines 3 Trench Width 36" Max Trench Bottom Depth 29-36" Gravel Depth N/A

✓ New System Repair System Type I II III IV V VI
System Description CHAMBERED GRAVITY
Repair System Description PPBS GRAVITY
Maintenance Agreement Required Yes ✓ No
Slab Crawl Space Basement w/plumbing Basement wo/plumbing


House/Mod Home No Bedrooms 2
✓ Mobile Home No Bathrooms 1
Business No Employees
Other

Water Supply: Individual, Community, ✓ Public

Comments: ① INSTALL 30 CHAMBERS IN THREE LINES AS SHOWN USING SERIAL DISTRIBUTION, ② USE SAND TO BACKFILL 6" ON CHAMBER SIDEWALL PER ATTACHED SHEET.

Comments

INITIAL SITE SKETCH

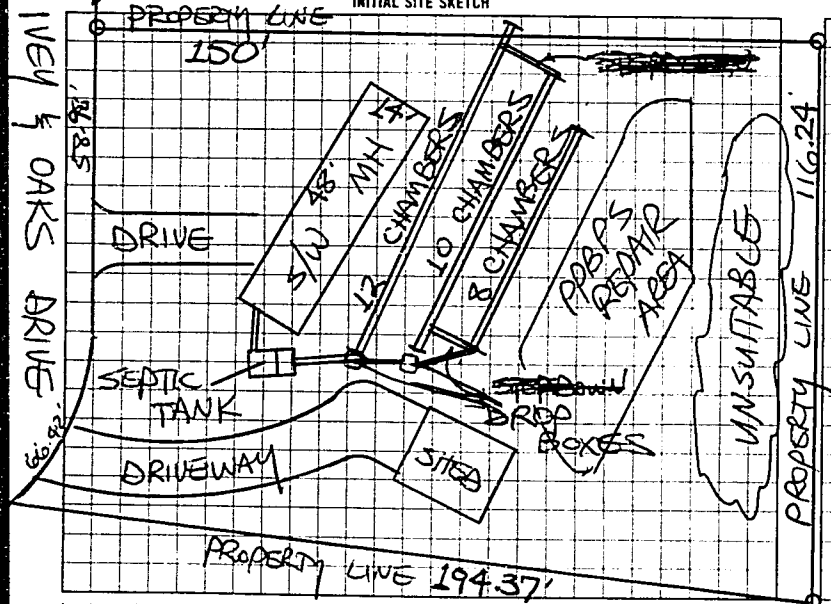

AS BUILT SKETCH

SYSTEM INSTALLED ACCORDING TO INITAL SITE SKETCH

I understand that this permit can be suspended or revoked if any false information is supplied toward securing the permit any unauthorized changes are made to the site/any unauthorized changes are made in the installation of the system

AUTHORIZATION TO CONSTRUCT IS VALID FIVE (5) YEARS FROM DATE OF ISSUANCE. IMPROVEMENT PERMIT HAS NO EXPIRATION DATE.

Signed: Ruth Pitman

Improvement Permit by STEVE HENDRICK date 3-5-96

AUTHORIZATION TO CONSTRUCT by STEVE HENDRICK date 3-5-96

Installed by DONALD LACKEY

~~Certificate of Completion by~~ date

Operation Permit by STEVE HENDRICK date 3-14-96

HEALTH DEPT COPY WHITE | INSPECTION COPY (FINAL) GREEN | OWNER COPY (FINAL) YELLOW | INSPECTION COPY (INITIAL) PINK | OWNER COPY (INITIAL) GOLD

788100