IREDELL COUNTY HEALTH DEPARTMENT

STATESVILLE 704-878-5305 MOORESVILLE 704-664-5281

IMPROVEMENT PERMIT / AUTHORIZATION TO CONSTRUCT / OPERATION PERMIT / EXISTING SYSTEM INSPECTION

PERMIT# 92375 PIN# 4748 34 6237 DATE 10/18/00

OWNER OR CONTRACTOR Larry Pittman PHONE: Business Home 924-9344

ADDRESS 123 Rock Haven Dr. Statesville NC 28625

LOCATION 21 N. to Jennings, R Eaglewood, 1st on Lt.

SUBDIVISION Every Oaks MHP BLOCK / SECTION 2 LOT 1 LOT AREA 11.36 SITE CLASS PS DESIGN FLOW 100 L.T.A.R. 0.3

Septic Tank: 1000 Gallons: STB 760 Date 1-2-01
Pump Tank: Gallons; PT Date
Pump Make: Model Serial No.
Nitrification Field: No Fields 1 Square Feet 315 Linear Feet 105
No Lines 3 @ 35' Trench Width 36" Max Trench Bottom Depth 36" Gravel Depth 12"

☒ New System ☐ Repair System Type: I (II) III, IV, V, VI
System Description: Gravity Conv.
Repair System Description: Same
Maintenance Agreement Required: ☐ Yes ☒ No
☒ Slab ☐ Crawl Space ☐ Basement w/plumbing ☐ Basement wo/plumbing


☐ House/Mod. Home ☐ Mobile Home ☒ Business ☐ Other
No. Bedrooms No. Bathrooms No. Employees 3

Water Supply: ☐ Individual ☒ Public ☐ Community


Comments/Conditions: Supply Line approx. 700'

Comments/Conditions: SEPTIC TANK W/ RISERS/MARKER INSTALLED USING "ZABEL" FILTER

INITIAL SITE SKETCH

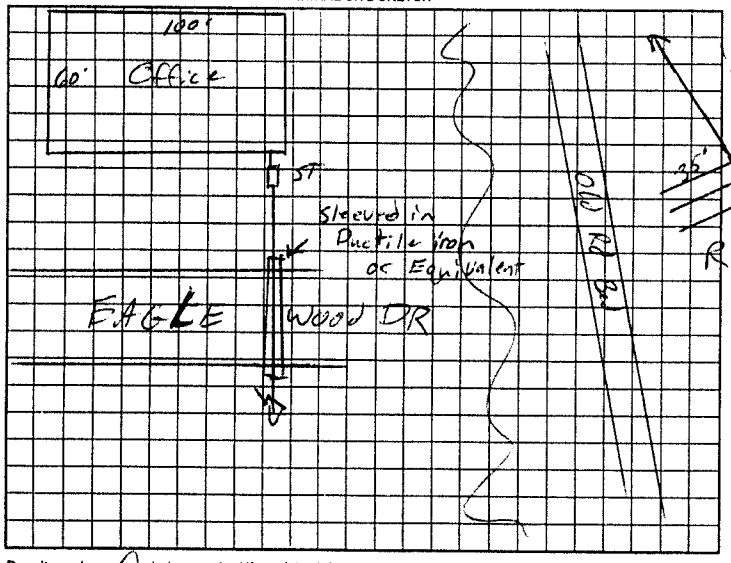

AS BUILT SKETCH

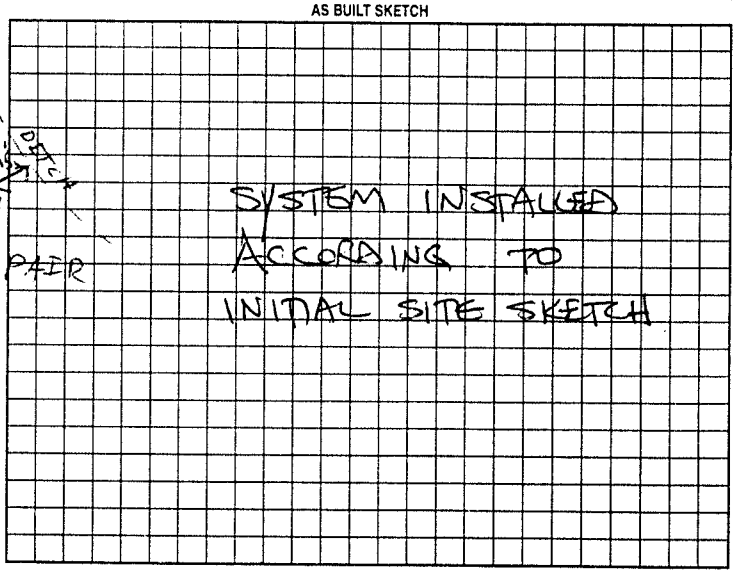

Permit can be suspended or revoked if any false information is supplied toward securing the permit/any unauthorized changes are made to the site/any unauthorized changes are made in the installation of the system. Improvement Permit with plat valid without expiration. Improvement Permit with site plan valid for sixty months. Authorization to Construct is valid for a period equal to that of Improvement Permit – not to exceed sixty months.

Signed: Larry Pittman date 10-20-00 Installed by: BRENT GALLIHER

Improvement Permit by: RSI date 10/18/00 Operation Permit by: STEVE HENDRICK date 5-24-01

Authorization to Construct by: RSI date 10/18/00 Existing System Inspection by: date

HEALTH DEPT. COPY: WHITE OWNER COPY (FINAL): YELLOW OWNER COPY (INITIAL): PINK