IREDELL COUNTY HEALTH DEPARTMENT

STATESVILLE 704-878-5305 MOORESVILLE 704-664-5281

IMPROVEMENT PERMIT / AUTHORIZATION TO CONSTRUCT / OPERATION PERMIT / EXISTING SYSTEM INSPECTION

PERMIT# 132057 PIN# 4774~~49~~49~~45~~ 400024 DATE 11-14-05

OWNER OR CONTRACTOR Dixieland Construction Inc PHONE: Business 704-202-4971 Home 704-876-6162

ADDRESS 323 Jennings RD Statesville NC 28625

LOCATION Jennings RD TO Deer Crossing TO Sundance circle end of culdesac

SUBDIVISION Deer Crossing BLOCK / SECTION 4 LOT 39 LOT AREA 1.284 SITE CLASS. PS DESIGN FLOW 360 L.T.A.R. .13

Septic Tank: 1000 Gallons; STB 825 Date 2-20-06

Pump Tank: _____ Gallons; PT _____ Date _____

Pump Make: _____ Model _____ Serial No. _____

Nitrification Field: No Fields ____ Square Feet 1200 Linear Feet 300

No Lines 4 Trench Width 36 Max Trench Bottom Depth 36 Gravel Depth NA

☑ New System ☐ Repair System Type: I, II, III, IV, V, VI

System Description: 25% Red - Sparty

Repair System Description: Pump CAP 1

Maintenance Agreement Required: ☐ Yes ☐ No ✓ Repair

☑ House/Mod. Home No. Bedrooms 3

☐ Mobile Home No. Bathrooms ____

☐ Business No. Employees ____

☐ Other _____


☐ Slab ☐ Crawl Space ☐ Basement w/plumbing ☐ Basement wo/plumbing

Water Supply: ☐ Individual ☑ Public ☐ Community


Comments:/Conditions: Install on contour - maintain all setbacks - House has walk out basement on side of septic system.

Comments:/Conditions: * Haul pipe Retaining wall drainage over Septic system to stream. (upper) * Drain Lower Retaining wall to drain to storm water Drain 88. 10' off of walk out basement with septic tank * Retaining walls must be installed and drainage diverted to stream and storm water drain * maintain 25' off of storm water Run 88. * maintain 50' off stream Blue Polly Vest top-tube * Full pressure system - System Designed Natural Soil

INITIAL SITE SKETCH

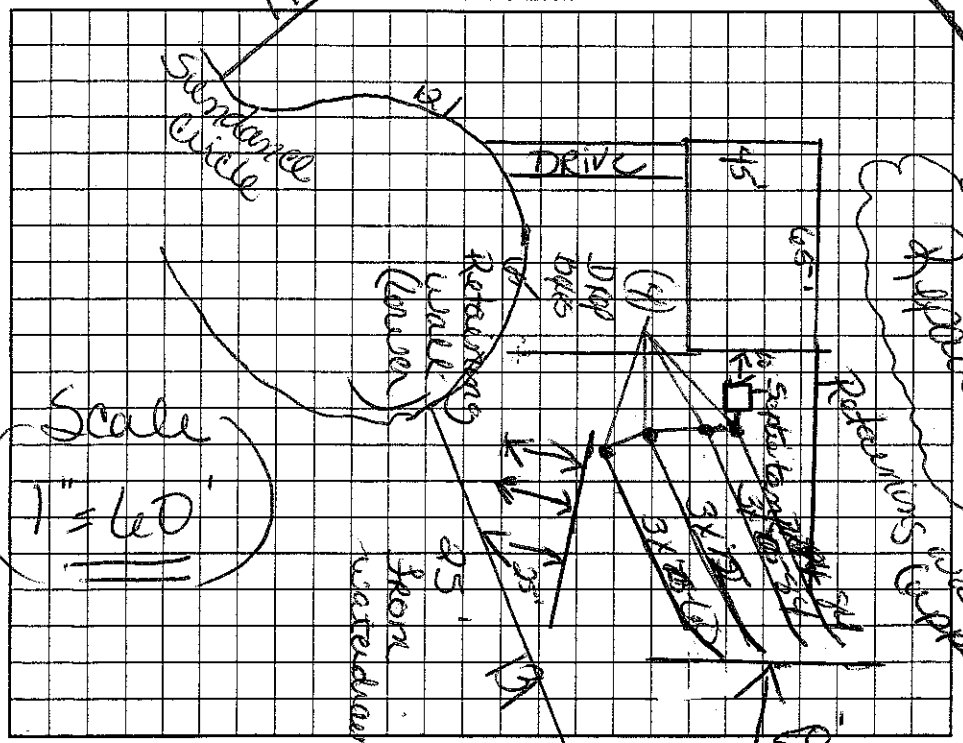

AS BUILT SKETCH

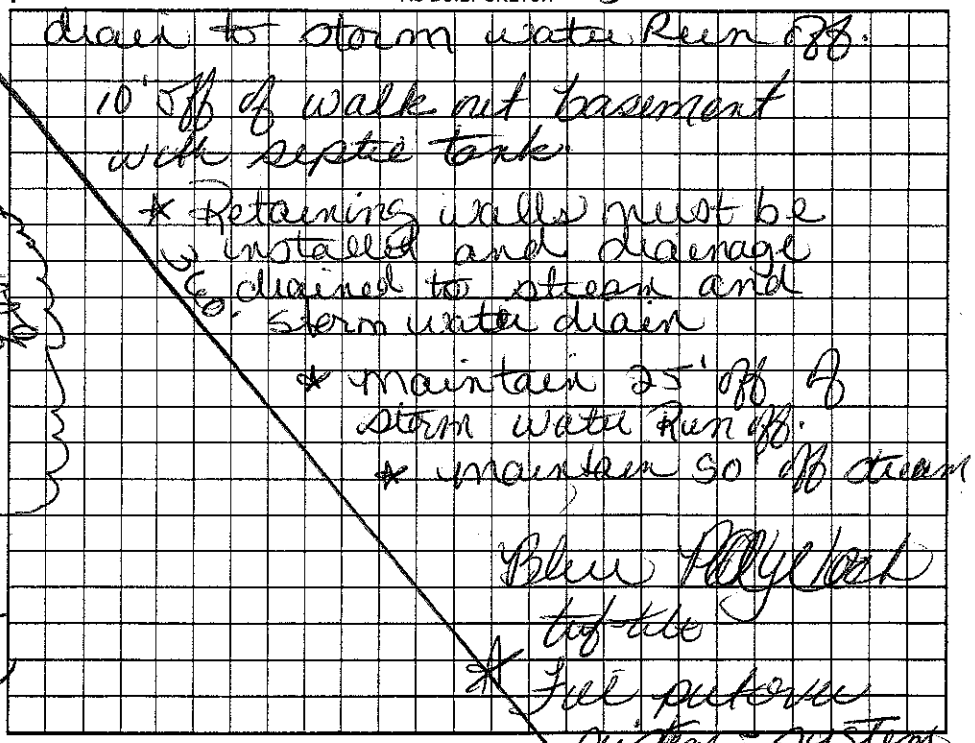

Permit can be suspended or revoked if any false information is supplied toward securing the permit/any unauthorized changes are made to the site/any unauthorized changes are made in the installation of the system. Improvement Permit with plat valid without expiration. Improvement Permit with site plan valid for sixty months. Authorization to Construct is valid for a period equal to that of Improvement Permit – not to exceed sixty months.

Signed: _____ 3-1-06 date _____ Installed by: KWAN 257

Improvement Permit by: _____ date 11-1-05 Operation Permit by: _____ date 5-15-06

Authorization to Construct by: _____ date 1-30-06 Existing System Inspection by: _____ date _____

HEALTH DEPT. COPY: WHITE OWNER COPY (FINAL): YELLOW OWNER COPY (INITIAL): PINK