IREDELL COUNTY HEALTH DEPARTMENT

STATESVILLE 704-878-5305 MOORESVILLE 704-664-5281

IMPROVEMENT PERMIT / AUTHORIZATION TO CONSTRUCT / OPERATION PERMIT / EXISTING SYSTEM INSPECTION

$130.00 Paid

PERMIT# 12809 PIN# 4748-~~20-8265-40~~ 40 21 60 DATE Dec 16, 04

OWNER OR CONTRACTOR Dixieland Inc. PHONE: Business _____ Home _____

ADDRESS 823 Jennings Pk, Statesville, N.C. 28625

LOCATION From Statesville US 21 N. TL Jennings Road on left past Squad Lane

SUBDIVISION Deer Crossing BLOCK / SECTION F LOT 10 LOT AREA .8 ac SITE CLASS PS DESIGN FLOW 360 gpd L.T.A.R. .3 initial sys // .25 Repair Area

Septic Tank: 1000 Gallons; STB 825 Date 11-20-04

Pump Tank: _____ Gallons; PT _____ Date _____

Pump Make: _____ Model _____ Serial No. _____

Nitrification Field: No Fields 1 Square Feet 900 Linear Feet 300

No Lines 4 (mostly centered) Trench Width 36" Max Trench Bottom Depth 36" Gravel Depth NA

☑ New System ☐ Repair System Type: I, II, III, IV, V, VI

System Description: Gravity 25% Reduction

Repair System Description: LP PPBPS

Maintenance Agreement Required: ☐ Yes ☑ No initially

☑ House/Mod. Home No. Bedrooms 3

☐ Mobile Home No. Bathrooms 2

☐ Business No. Employees ____

☐ Other _____

☐ Slab ☑ Crawl Space ☐ Basement w/plumbing ☐ Basement wo/plumbing

Water Supply: ☐ Individual ☑ Public ☐ Community


Comments/Conditions:

1"=50'

RW Jennings Road

Comments/Conditions: ① SYSTEM INSTALLED DURING PERIOD OF WET SOIL CONDITIONS ② SEPTIC TANK WITH MARKER INSTALLED USING "POLYLOK FILTER"

INITIAL SITE SKETCH

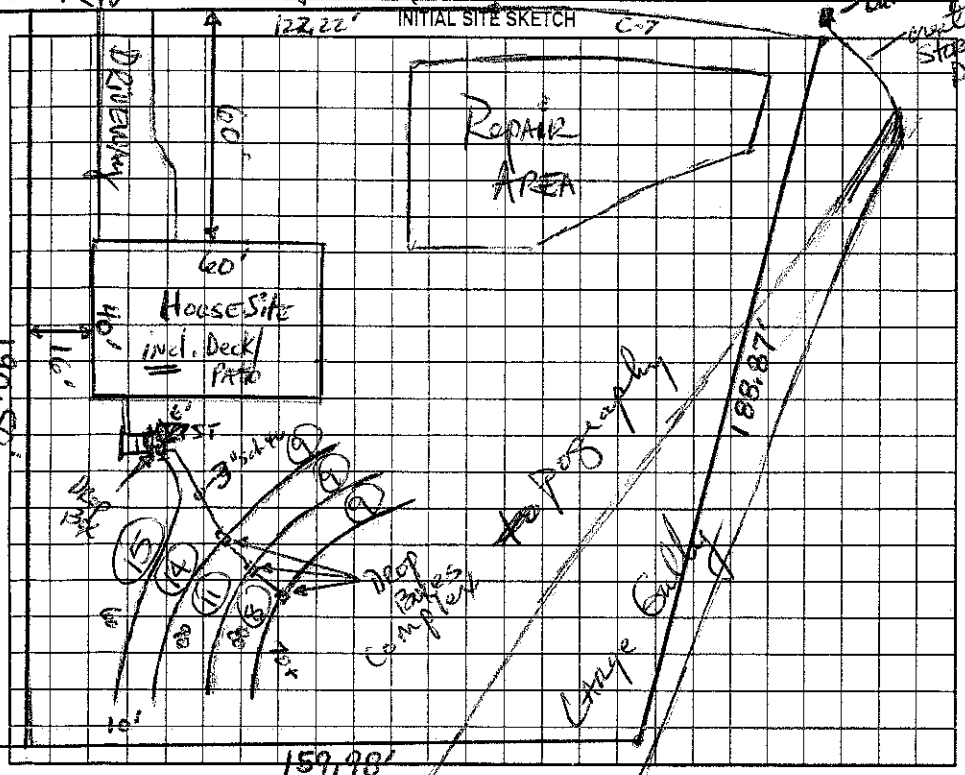

AS BUILT SKETCH

SYSTEM INSTALLED USING 75 "INFILTRATOR QUICK-4" CHAMBERS AS SHOWN

Permit can be suspended or revoked if any false information is supplied toward securing the permit/any unauthorized changes are made to the site/any unauthorized changes are made in the installation of the system. Improvement Permit with plat valid without expiration. Improvement Permit with site plan valid for sixty months. Authorization to Construct is valid for a period equal to that of Improvement Permit – not to exceed sixty months.

Signed: Daye Garrison date 12-17-04 Installed by: Rowan Septic

Improvement Permit by: D. Harrison, RS date 12-16-04 Operation Permit by: Steve Hedrick date 2-7-05

Authorization to Construct by: D. Harrison, RS date 12-16-04 Existing System Inspection by: _____ date _____

HEALTH DEPT. COPY: WHITE OWNER COPY (FINAL): YELLOW OWNER COPY (INITIAL): PINK