IREDELL COUNTY HEALTH DEPARTMENT

STATESVILLE 704-878-5305 MOORESVILLE 704-664-5281

IMPROVEMENT PERMIT / AUTHORIZATION TO CONSTRUCT / OPERATION PERMIT / EXISTING SYSTEM INSPECTION

PERMIT# 100560 PIN# 4748 45 4059 DATE 6-1-01

OWNER OR CONTRACTOR LARRY BLEVINS PHONE: Business Home 704-592-5562

ADDRESS 360 TROY MILL RD HAMPTONVILLE, NC 27020

LOCATION 21N, L JENNINGS, CROSS RIVER, BIG FIELD ON RT

SUBDIVISION PATTERSON ACRES BLOCK / SECTION LOT 1 LOT AREA 4.54 SITE CLASS PS DESIGN FLOW 480 L.T.A.R. .13

Septic Tank: 1000 Gallons: STB 760 Date 3-2-01
Pump Tank: Gallons: PT Date
Pump Make: Model Serial No.
Nitrification Field: No Fields 1 Square Feet 1600' Linear Feet 533'
No Lines 4 Trench Width 36" Max Trench Bottom Depth 36" Gravel Depth 12"

[X] New System [ ] Repair System Type: I. II. III. IV. V. VI
System Description: CONV GRAV
Repair System Description: CONV GRAV
Maintenance Agreement Required: [ ] Yes [X] No


[X] House/Mod. Home No. Bedrooms 4
[ ] Mobile Home No. Bathrooms 3
[ ] Business No. Employees
[ ] Other
[ ] Slab [X] Crawl Space [ ] Basement w/plumbing [ ] Basement wo/plumbing

Water Supply: [ ] Individual [X] Public [ ] Community


Comments/Conditions: ① INSTALL LINES ON CONTOUR ② USE 4 DROP BOXES ③ MAINTAIN SETBACKS

Comments/Conditions: SEPTIC TANK WITH MARKER INSTALLED USING "ZABEL" FILTER

INITIAL SITE SKETCH

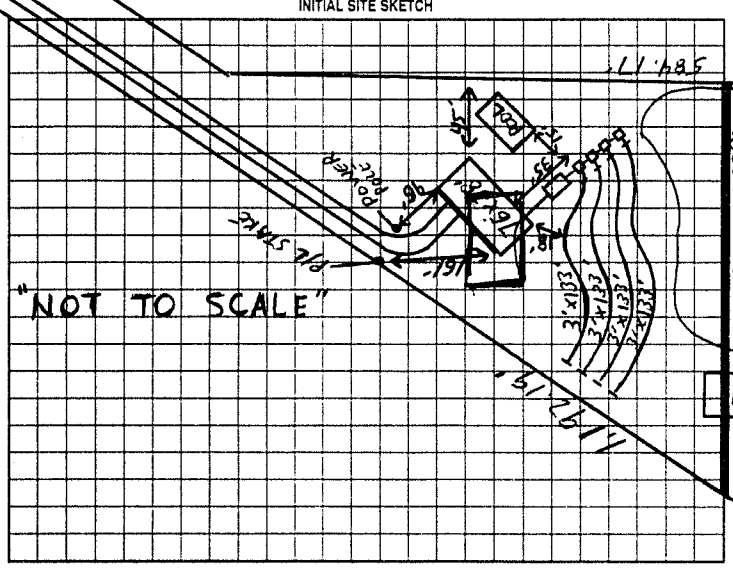

AS BUILT SKETCH

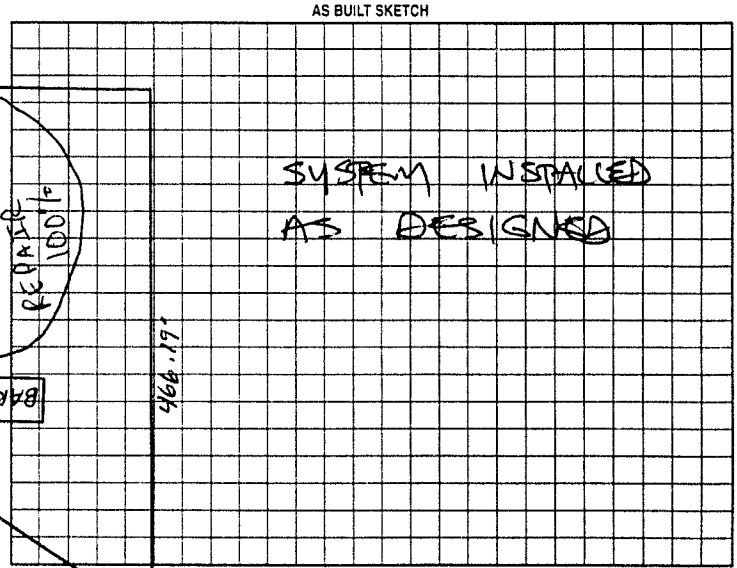

Permit can be suspended or revoked if any false information is supplied toward securing the permit/any unauthorized changes are made to the site/any unauthorized changes are made in the installation of the system. Improvement Permit with plat valid without expiration. Improvement Permit with site plan valid for sixty months. Authorization to Construct is valid for a period equal to that of Improvement Permit – not to exceed sixty months.

Signed: date 6-4-01 Installed by: SHERMAN DUNN

Improvement Permit by: date 6-1-01 Operation Permit by: STEVE HEDRICK date 7-11-01

Authorization to Construct by: date 6-1-01 Existing System Inspection by: date

HEALTH DEPT COPY WHITE OWNER COPY (FINAL) YELLOW OWNER COPY (INITIAL) PINK