IREDELL COUNTY HEALTH DEPARTMENT

Statesville Office (704) 878-5305 Mooresville Office (704) 660-3625 PERMIT # 301611

SEPTIC IMPROVEMENT PERMIT / AUTHORIZATION TO CONSTRUCT / OPERATION PERMIT / EXISTING SYSTEM

PIN # 4748463195.000

APPLICANT/OWNER: Lonnie Troutman APPLICANT ADDRESS: 232 Davie Ave Statesville NC 28677

SITE ADDRESS: 1032 Jennings Rd Statesville NC 28625 PHONE: 704 903 3202 ALT. PHONE 704 873 5233

SITE DIRECTIONS: Hwy 21 N Don Jennings Property on Right Approx 4 miles. SAP CONTROLLED: ☐ YES ☒ NO

SUBDIVISION: Cypress Acres SECTION: – LOT # 1 LOT AREA: 0.601 Acres. DESIGN FLOW: 360 L.T.A.R.: .30

Septic Tank	1000	(gal)	STB	760	Date						
Pump Tank		(gal)	PT		Date						
Pump Make		Model			Serial #						
# Nitrification Fields	1	# Lines	4		Linear Ft	300					
Trench Width	36	Trench Bottom Depth(Low side)	18 inches		Gravel Depth						

☒ New System ☐ Repair ☐ Expansion System Type: I II (III) IV V VI

System Description: Gravity 25% Reduction.

Repair System Description: LP - Horizontal Panel Block

Maintenance Agreement Required: ☐ YES ☒ NO

☒ GRAVITY ☐ PRESSURE

☒ Residence ☐ Business ☐ Other ☐ Slab ☐ Basement w/plumbing

No. Bedrooms 3 No. Persons 6 No. Employees ☒ Crawl Space


Water Supply: ☐ Private ☒ Public ☐ Community

☐ Basement w/o plumbing

Comments / Conditions: Install Septic drainlines on the contour of the Land and utilize serial distribution. Do not exceed mark of 24 inches. Repair System mark is 20 inches and will Require curtain. Do not grade, pave, build or bury utility in drainfield areas.

* No foundation Drain around backside of house *

INITIAL SITE SKETCH

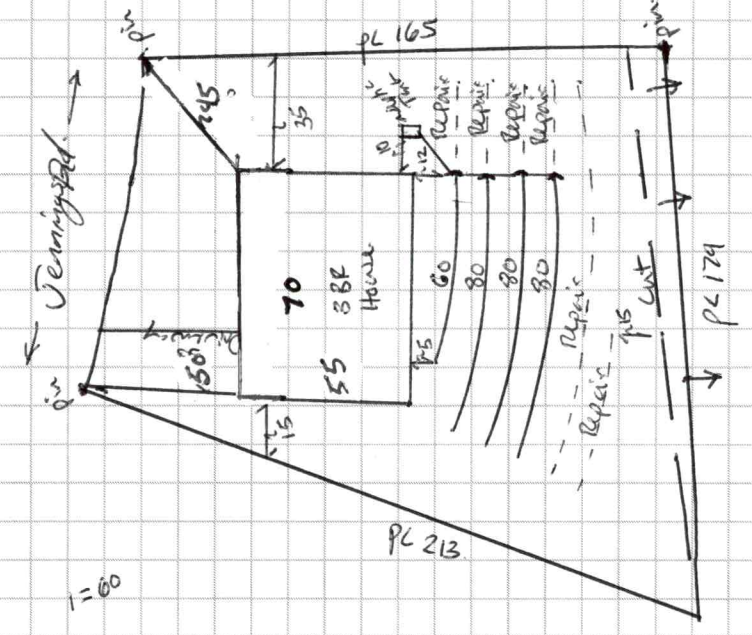

AS BUILT SKETCH

Installed as Permitted

Permit can be suspended or revoked if any false information is supplied toward securing the permit / any unauthorized changes are made to the site / any unauthorized changes are made in the installation of the system. **CONTACT A LOCATOR SERVICE PRIOR TO ANY EXCAVATION**

☐ **IMPROVEMENT PERMIT** ***with plat*** *valid without expiration.* ☒ **IMPROVEMENT PERMIT** ***with site plan*** *valid for 60 mos.* ☒ **AUTHORIZATION TO CONSTRUCT** *valid for period equal to IMPROVEMENT PERMIT--not to exceed 60 mo.*

Owner / Applicant Signature: W. S Date: 10/28/19 Installed by: Williams Excavating 6445

IMPROVEMENT PERMIT by: Benjamin A Bell Date: 10/23/2019 OPERATION PERMIT by: Benjamin A Bell Date: 5-20-2020

AUTHORIZATION TO CONSTRUCT by: Benjamin A Bell Date: 10/28/2019 Existing System Inspected by: _____ Date: _____

FOR SEPTIC FINAL INSPECTION: CALL 704-664-3703 between 8am-9am the day the inspection is needed. Be sure to speak with an inpsector to confirm your inspection time.

DEPARTMENT OF HEALTH AND HUMAN SERVICES
DIVISION OF PUBLIC HEALTH, ENVIRONMENTAL HEALTH SECTION
ON-SITE WATER PROTECTION BRANCH

Sheet 1 of 1
PROPERTY ID #: 4748463195

SOIL/SITE EVALUATION
for ON-SITE WASTEWATER SYSTEM

(Complete all fields in full) Lot 1

OWNER: Lonnie Trautman
ADDRESS: 232 Davis Ave SVL
PROPOSED FACILITY: 3BR House. PROPOSED DESIGN FLOW (.1949): 360 gpd.
LOCATION OF SITE: 1032 Sunny's Rd SVL NC

APPLICATION DATE 10/3/19.
DATE EVALUATED: 10/18/19.
PROPERTY SIZE: .601 Acs
PROPERTY RECORDED: Yes.

WATER SUPPLY: ☐ Private ☒ Public ☐ Well ☐ Spring ☐ Other
EVALUATION METHOD: ☐ Auger Boring ☒ Pit ☐ Cut
TYPE OF WASTEWATER: ☒ Sewage ☐ Industrial Process ☐ Mixed

PROFILE #	.1940 LANDSCAPE POSITION/ SLOPE %	HORIZON DEPTH (IN.)	SOIL MORPHOLOGY (.1941) .1941 STRUCTURE/ TEXTURE	SOIL MORPHOLOGY (.1941) .1941 CONSISTENCE/ MINERALOGY	OTHER PROFILE FACTORS .1942 SOIL WETNESS/ COLOR	.1943 SOIL DEPTH	.1956 SAPRO CLASS	.1944 RESTR HORIZ	PROFILE CLASS & LTAR
1	Ridge shoulder 4%	0-33	C SBK	SS SP FR SFXP	2.5Y 4/6	48		Little mottles in core & 39 inches	PS .30
		33-48	CL WSBK	SS SP FR					
2	Shoulder 4-6%	0-19	SC WSBK	SS SP FR SFXP	2.5Y 4/6	48		Rock @ 36 inches to 40 inches	PS .30 Max 24
		19-40	C SBK	SS SP FR					
		40-48	CL WSBK	SS SP VFR					
3	Shoulder 5%	0-4	SC WSBK	SS SP FR SFXP	2.5Y 4/6	53		Small Flat Rocks Throughout	PS .30
		4-37	C SBK	SS SP FR					
		37-53	CL WSBK	SS SP VFR					
4	Shoulder 5%	0-22	C WSBK	SS SP FR SFXP	2.5Y 4/6	46		Rock @ 34 Inches	PS .30 Max 2-Inches
		22-34	CL SBK	SS SP FR					
		34-48	FIRM Rock						

DESCRIPTION	INITIAL SYSTEM	REPAIR SYSTEM
Available Space (.1945)	300	200
System Type(s)	II 25%	II 50% Horizontal
Site LTAR	.3	.3

OTHER FACTORS (.1946): Shallow system / Cut Rear of property
SITE CLASSIFICATION (.1948): PS
EVALUATED BY: Bolton
OTHER(S) PRESENT: Neil STUTTS.

COMMENTS: Repair May Require Curtain Drain. & System GPS &

Updated February 2014

LEGEND

use the following standard abbreviations

LANDSCAPE POSITION	GROUP	SOIL TEXTURE	CONVENTIONAL .1955 LTAR*	LPP .1957 LTAR*	MINERALOGY/ CONSISTENCE	STRUCTURE
CC (Concave Slope)	I	S (Sand)	1.2 - 0.8	0.6 - 0.4	SEXP (Slightly Expansive)	G (Single Grain)
CV (Convex Slope)		LS (Loamy Sand)			EXP (Expansive)	M (Massive)
D (Drainage Way)						CR (Crumb)
DS (Debris Slump)	II	SL (Sandy Loam)	0.8 - 0.6	0.4 - 0.3		GR (Granular)
FP (Flood Plain)		L (Loam)				SBK (Subangular Blocky)
FS (Foot Slope)						ABK (Angular Blocky)
H (Head Slope)	III	Si (Silt)	0.6 - 0.3	0.3 - 0.15		PL (Platy)
L (Linear Slope)		SiCL (Silty Clay Loam)				PR (Prismatic)
N (Nose Slope)		CL (Clay Loam)				
R (Ridge)		SCL (Sandy Clay Loam)			**MOIST**	**WET**
S (Shoulder Slope)		SiL (Silt Loam)				
T (Terrace)					VFR (Very Friable)	NS (Non-sticky)
	IV	SC (Sandy Clay)	0.4 - 0.1	0.2 - 0.05	FR (Friable)	SS (Slightly Sticky)
		SiC (Silty Clay)			FI (Firm)	S (Sticky)
		C (Clay)			VFI (Very Firm v. Very Sticky)	VS (Very Sticky)
		O (Organic)	None	None	EFI (Extremely Firm)	NP (Non-plastic)
						SP (Slightly Plastic)
						P (Plastic)
						VP (Very Plastic)

*Adjust LTAR due to depth, consistence, structure, soil wetness, landscape, position, wastewater flow and quality.


NOTES

HORIZON DEPTH	In inches below natural soil surface
DEPTH OF FILL	In inches from land surface
RESTRICTIVE HORIZON	Thickness and depth from land surface
SAPROLITE	S(suitable) or U(unsuitable)
SOIL WETNESS	Inches from land surface to free water or inches from land surface to soil colors with chroma 2 or less - record Munsell color chip designation
CLASSIFICATION	S (Suitable), PS (Provisionally Suitable), or U (Unsuitable)

Evaluation of saprolite shall be by pits.

Long-term Acceptance Rate (LTAR): gal/day/ft^2


Show profile locations and other site features (dimensions, reference or benchmark, and North).

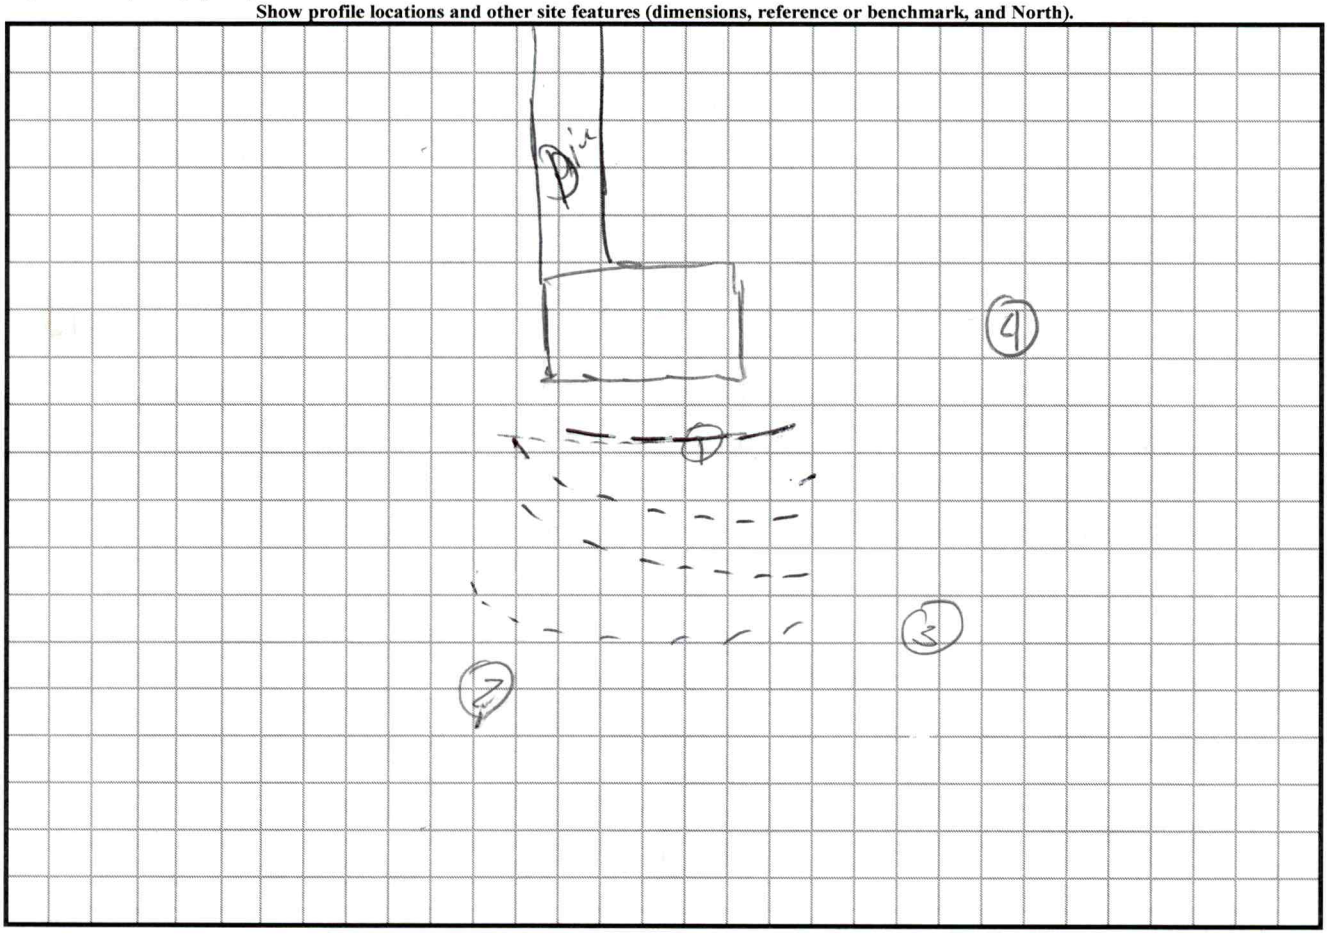

See GPS Layout

60
80
10
90

Updated February 2014

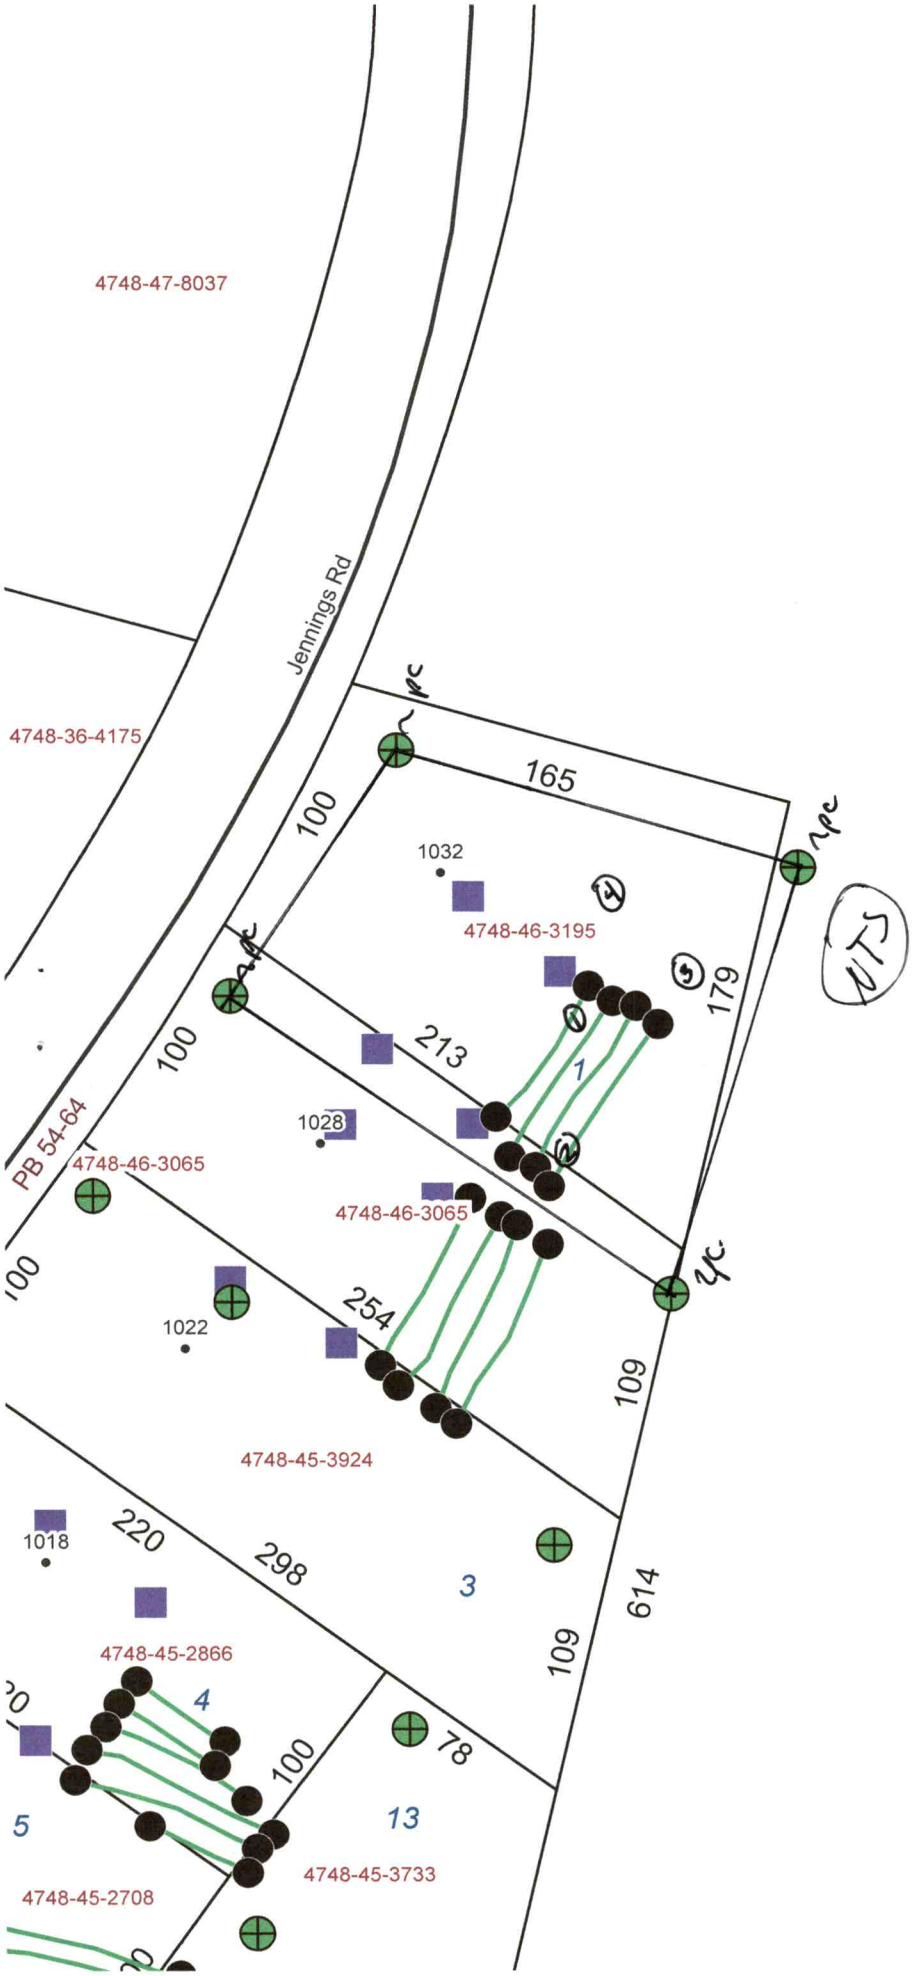
4748-47-8037
Jennings Rd
4748-36-4175
165
100
1032
4748-46-3195
179
213
100
1028
PB 54-64
4748-46-3065
4748-46-3065
254
1022
109
4748-45-3924
1018
220
298
3
614
109
4748-45-2866
4
100
78
5
13
4748-45-3733
4748-45-2708
4748-47-8037
NTS

(1) SVL

RECEIVED OCT 8, 2019

APPLICATION MUST BE FILLED OUT COMPLETELY & BE LEGIBLE OR IT WILL NOT BE PROCESSED

Paid $500.00

Iredell County Health Department – Environmental Health Division

PAGE 1: *APPLICATION FORM*

AP-301611

Application For: ( ) New Well Permit ( ) Well Repair Permit ( ) Well Abandonment
(✓) Septic Improvement Permit ( ) Authorization to Construct ( ) Existing System Inspection ( ) Septic System Repair

THE ABOVE PERMIT DOCUMENTS WILL BECOME INVALID IF INFORMATION PROVIDED ON THIS APPLICATION IS FALSIFIED OR CHANGED, OR IF THE SITE IS ALTERED. THE IMPROVEMENT PERMIT IS VALID FOR EITHER 60 MONTHS OR WITHOUT EXPIRATION DEPENDING UPON DOCUMENTATION SUBMITTED. APPLICATION WITH SITE PLAN 60 MONTHS, APPLICATION WITH COMPLETE, SCALED PLAT WITHOUT EXPIRATION. SEE 15A NCAC 18A .1937(f) FOR DETAILS.

Page 2: *Site Plan Worksheet* form MUST accompany this application

The following optional attachments may also be submitted: ( ) Survey Plat, scaled no more than 1 inch = 60 feet
Place an (X) beside whichever is submitted if applicable ( ) Custom Site Plan, scaled no more than 1 inch = 60 feet

Applicant Information: (PRINT CLEARLY)

Applicant Name: Lonnie Troutman Address: 232 Davie Avenue Statesville Zip: 28677
Applicant Email: lonnie@troutmanrealty.net Phone: 704.903.3202 Alt. Phone: 704-873-5233
Owner Name: Howard D. Hudgins Address: 186 Friendship Road Statesville Zip: 28625
Owner Email: — Phone: 704-876-6885 Alt. Phone: _____

Property Information:

Street Address: 1032 JENNINGS RD. STATESVILLE, NC 28625
Subdivision Name: CYPRESS ACRES Section/Phase: _____ Lot Number: 1
Driving Directions: HWY 21 NORTH, LEFT ON JENNINGS, PROPERTY ON RIGHT APPROX. 4 mi.

Site Development Information: *(check or complete ALL that apply*

(✓) New Single Family Residence
( ) New Multi-Family Residence
( ) Accessory Building
( ) Bedroom(s) Addition
( ) Repair to failing septic system ___ Tank ___ Drain lines Describe Problem: _____
Maximum Number of Bedrooms: 3
Maximum Number of Occupants: _____
( ) Swimming Pool
( ) Other Addition/Structure: _____
Non-Residential Site Development: Type of Business: _____
Square Footage of Building: _____ Max. Number of Employees: _____ Max. Number of Seats/Beds/Other: _____

CHECK FOUNDATION TYPE

(✓) Crawl Space Foundation
( ) Concrete Slab Foundation
( ) Basement with Plumbing
( ) Basement without Plumbing

Water Supply: ( ) Replacement Well – Reason: _____
( ) Multi-connection Well Number of Houses: _____ Number of Persons: _____
( ) New Well ( ) Existing Well ( ) Community Well ( ) City Water (✓) Other Public Water

Desired Septic System Type: *(you may rank in order of preference)* Year existing system installed: _____
( ) No Preference ( ) Alternative (✓) Conventional ( ) Innovative ( ) Modified Conventional ( ) Other: _____

Please answer the following to the best of your ability:

( ) Yes (✓) No Does the site contain any jurisdictional wetlands?
( ) Yes (✓) No Is any non-domestic sewage (i.e. industrial) to be generated?
( ) Yes (✓) No Is the site subject to approval by any other public agency?

I have read this application and certify that the information provided herein is true, complete, and correct. Authorized county and state officials are granted right of entry to conduct necessary inspections to determine compliance with applicable laws and rules. I understand that I am solely responsible for the proper identification and labeling of all property lines and corners and making the site accessible so that a complete site evaluation can be performed.

X **Signature:** L Troutman 10-3-19
Property owner or owner's legal representative signature (SIGNATURE REQUIRED) DATE


LOT 1

1032 JENNINGS RD

IREDELL COUNTY DEPARTMENT of ENVIRONMENTAL HEALTH

SITE PLAN WORKSHEET

SEE THE "SAMPLE SITE PLAN" BELOW. *INCOMPLETE SITE PLANS WILL BE RETURNED TO YOU FOR COMPLETION AND MAY RESULT IN A DELAY IN THE ISSUANCE OF YOUR SEPTIC SYSTEM OR WELL PERMIT!!!*

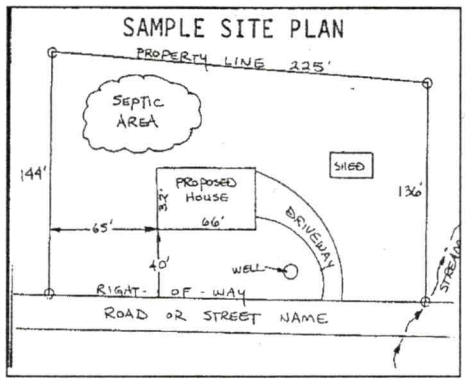

Place an (X) beside each item as you complete the site plan:


- (X) Property Line measurements are clearly identified
- (X) All proposed structures are indicated
- (X) Front and side setbacks from property line
- (X) Preferred driveway location
- ( ) Preferred well location
- ( ) Preferred septic system location
- (X) North arrow, or other sufficient indicator of direction

Circle N/A on the following if appropriate:

Location of septic systems and wells within 100' of your property	N/A
Location of easements and rights of ways on your property	N/A
Location of any designated wetlands on the property	N/A

USE THIS SPACE TO DRAW YOUR SITE PLAN

Show: proposed house or business footprint, wells, water lines, patios, pools and decks, and any other item that will occupy space on the site

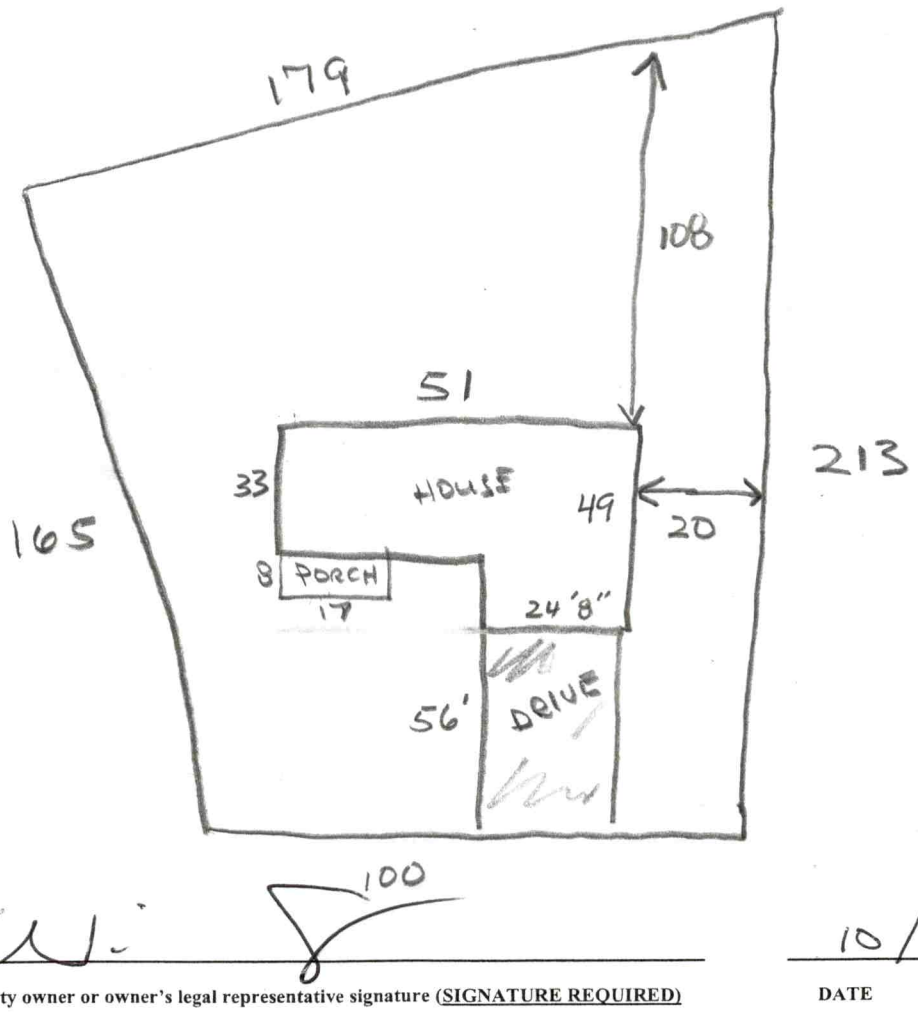

Signature: _____ 10/28/19

Property owner or owner's legal representative signature (SIGNATURE REQUIRED) **DATE**




* Installed as pumbaid

is de 200.19.

IREDELL COUNTY DEPARTMENT of ENVIRONMENTAL HEALTH

SITE PLAN WORKSHEET

SEE THE "SAMPLE SITE PLAN" BELOW. *INCOMPLETE SITE PLANS WILL BE RETURNED TO YOU FOR COMPLETION AND MAY RESULT IN A DELAY IN THE ISSUANCE OF YOUR SEPTIC SYSTEM OR WELL PERMIT!!!*

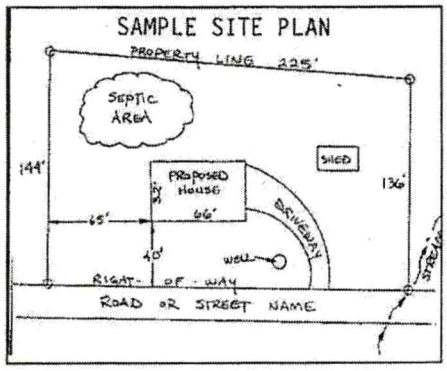

Place an (X) beside each item as you complete the site plan:


- (X) Property Line measurements are clearly identified
- (X) All proposed structures are indicated
- (X) Front and side setbacks from property line
- (X) Preferred driveway location
- ( ) Preferred well location
- ( ) Preferred septic system location
- (X) North arrow, or other sufficient indicator of direction

Circle N/A on the following if appropriate:

Location of septic systems and wells within 100' of your property	N/A
Location of easements and rights of ways on your property	N/A
Location of any designated wetlands on the property	N/A

USE THIS SPACE TO DRAW YOUR SITE PLAN

Show: proposed house or business footprint, wells, water lines, patios, pools and decks, and any other item that will occupy space on the site

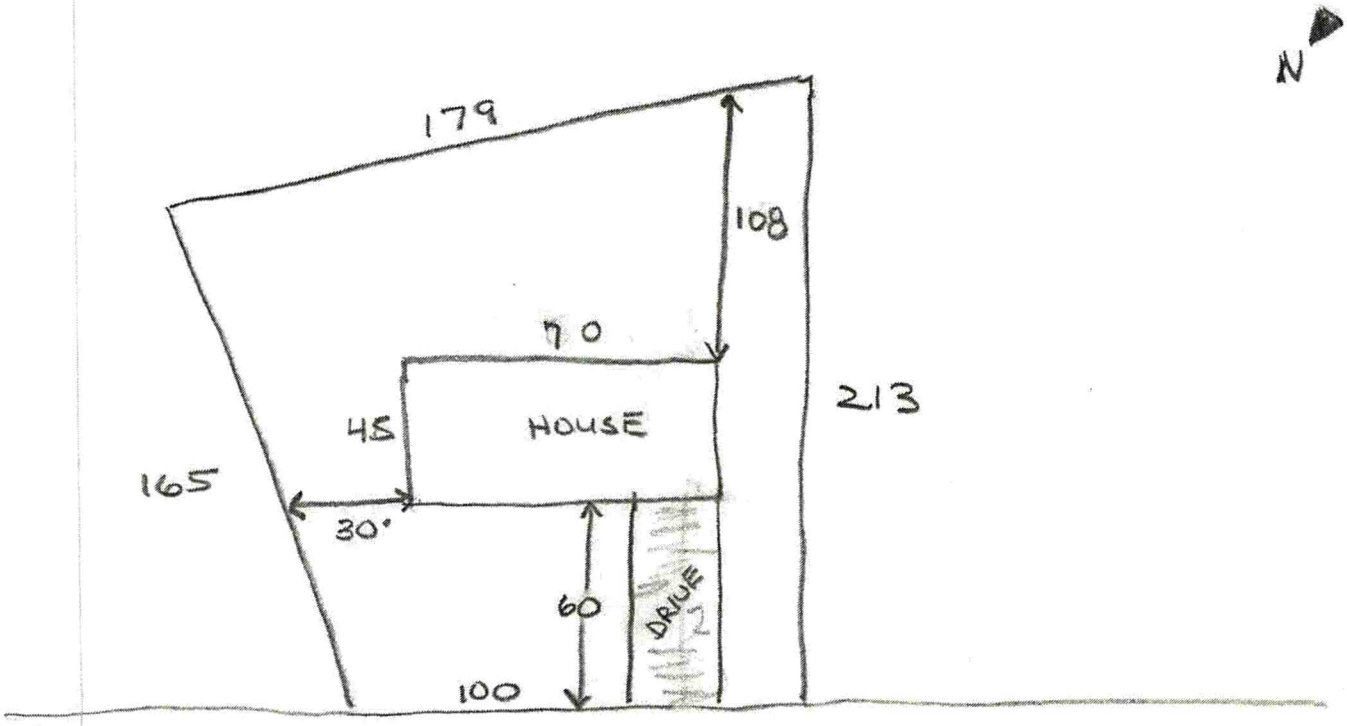

JENNINGS RD.

Signature: L Hontmon 10-3-19

Property owner or owner's legal representative signature (SIGNATURE REQUIRED) DATE

IREDELL COUNTY DEPARTMENT OF ENVIRONMENTAL HEALTH

DOCUMENTATION TO AUTHORIZE AN OWNER'S LEGAL REPRESENTATIVE

(Check and sign only ONE of the options below)

1. *** APPLICANT AND OWNER ARE THE SAME. *** (*Sign here*) _____

Applications for permits require the "signature of the owner or owner's legal representative" (15A NCAC 18A .1937). If the owner does not sign the application himself or herself, they can submit any one of the following documents to designate their legal representative: *Power of Attorney; Real Estate Contract; Estate executor; Bankruptcy trustee; Court ordered guardianship* In the absence of the above documentation, the property owner may provide the local health department with documentation that designates a legal representative. A property owner may:
Complete this form to document his or her legal representative, or provide his or her own form that contains the information in this form. If there are multiple property owners, then all property owners must sign the form that designates a legal representative.
By signing a form that designates a legal representative for purposes of 15A NCAC 18A .1937, the property owner authorizes that representative to act on their behalf in matters pertaining to the application and permitting process, including signing or receiving any application, document or permit. The owner retains full responsibility to meet all permit conditions specified by the local health department.

2. I, Howard D. Hudgins, am the legal owner(s) of the property located at 1032 Jennings Road, Statesville, NC, identified as

PIN (Parcel Identification Number) 4748-46-3195, located in Iredell County, North Carolina.

I do hereby authorize (**print legal representative/company name**) Lonnie Trautman, _____, to act as an agent on my behalf in applying for/signing/obtaining any of the documents described below.

- Application for Improvement Permit (IP) / Authorization to Construct (AC)
- Improvement Permit (IP) / Authorization to Construct (AC)
- Application for soil-site evaluation (new/repair)
- Application/permit for private drinking water well/well abandonment
- Application for Compliance Inspection


I agree to abide by all decisions and/or conditions between the legal representative acting on my behalf and the Iredell County Department of Public Health, Environmental Health Division.

Howard D Hudgins
Signature of Owner(s)

10-7-19
Date

Mooresville - Environmental Health
ronda.hart@co.iredell.nc.us
Fax: 704-662-3239
610 E. Center Avenue, Mooresville, NC 28115

Statesville - Environmental Health
adrienne.shea@co.iredell.nc.us
Fax: 704-871-3483
349 N. Center Street, Statesville, NC 28677

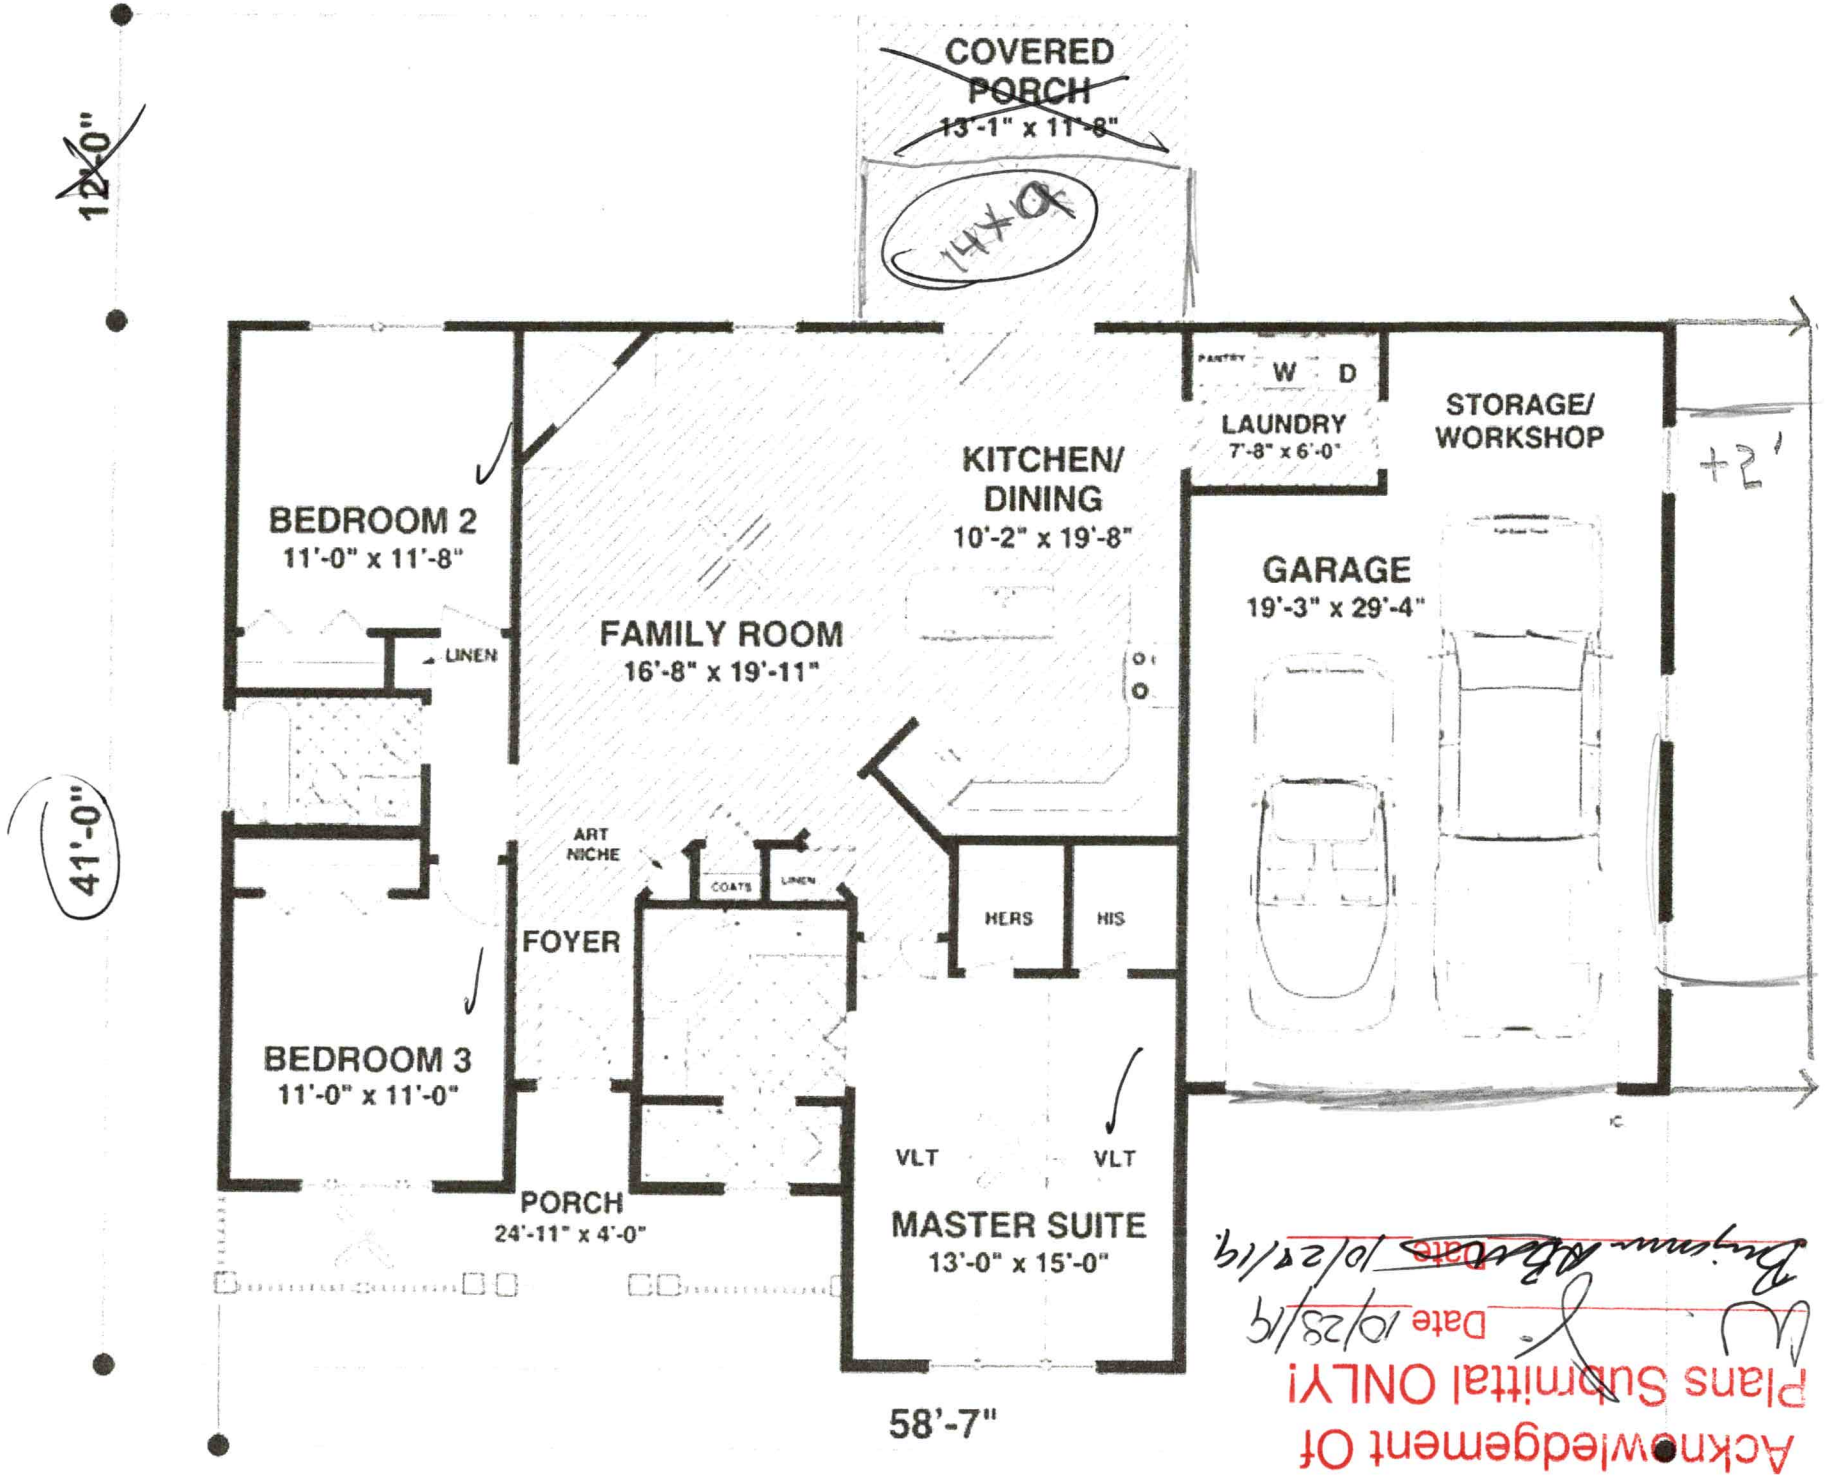

Acknowledgement Of
Plans Submittal ONLY!
Date 10/28/19
Date 10/28/19

IREDELL COUNTY · NC

IREDELL COUNTY
PO Box 788
349 North Center St.
Statesville, NC 28677

APPLICATION NUMBER
301611 Issue Date: 10/08/2019

Permit Type: ZONING RESIDENTIAL

Parcel Number	Street Address	Jurisdiction
4748463195.000	1032 JENNINGS RD	IREDELL COUNTY

Owner Information	Applicant Information
Name: HUDGINS HOWARD D	Name: TROUTMAN LONNIE
Address:	Address: 232 DAVIE AVE
,	, 28677
Phone:	Phone: (704)880-0357

Use Requested	Zone Code
Single Family Dwelling	RA

Lot Acreage	F Setback	B Setback	L Setback	R Setback	Watershed	Flood Zone
0.601	35	35	15	15	N/A	NO

Remarks
SFD

The applicant certifies that there are no deed restrictions, contractual agreements or governmental regulations of any kind that interfere with or prohibit the use of the property or the use for which this permit is requested. The applicant further acknowledges that enforcement of deed restrictions, plat conditions and other contractual agreements will not be undertaken by Iredell County and is the sole responsibility of the affected parties.

Date: 10/08/2019


Signature of Owner/Contractor

Permit Number	000517	TOTAL FEES:	$77.25

AP - 301611
ZR - 000517
ES - 000294

RA .601
FL NO
WS NO

ZONING DISCLAIMER

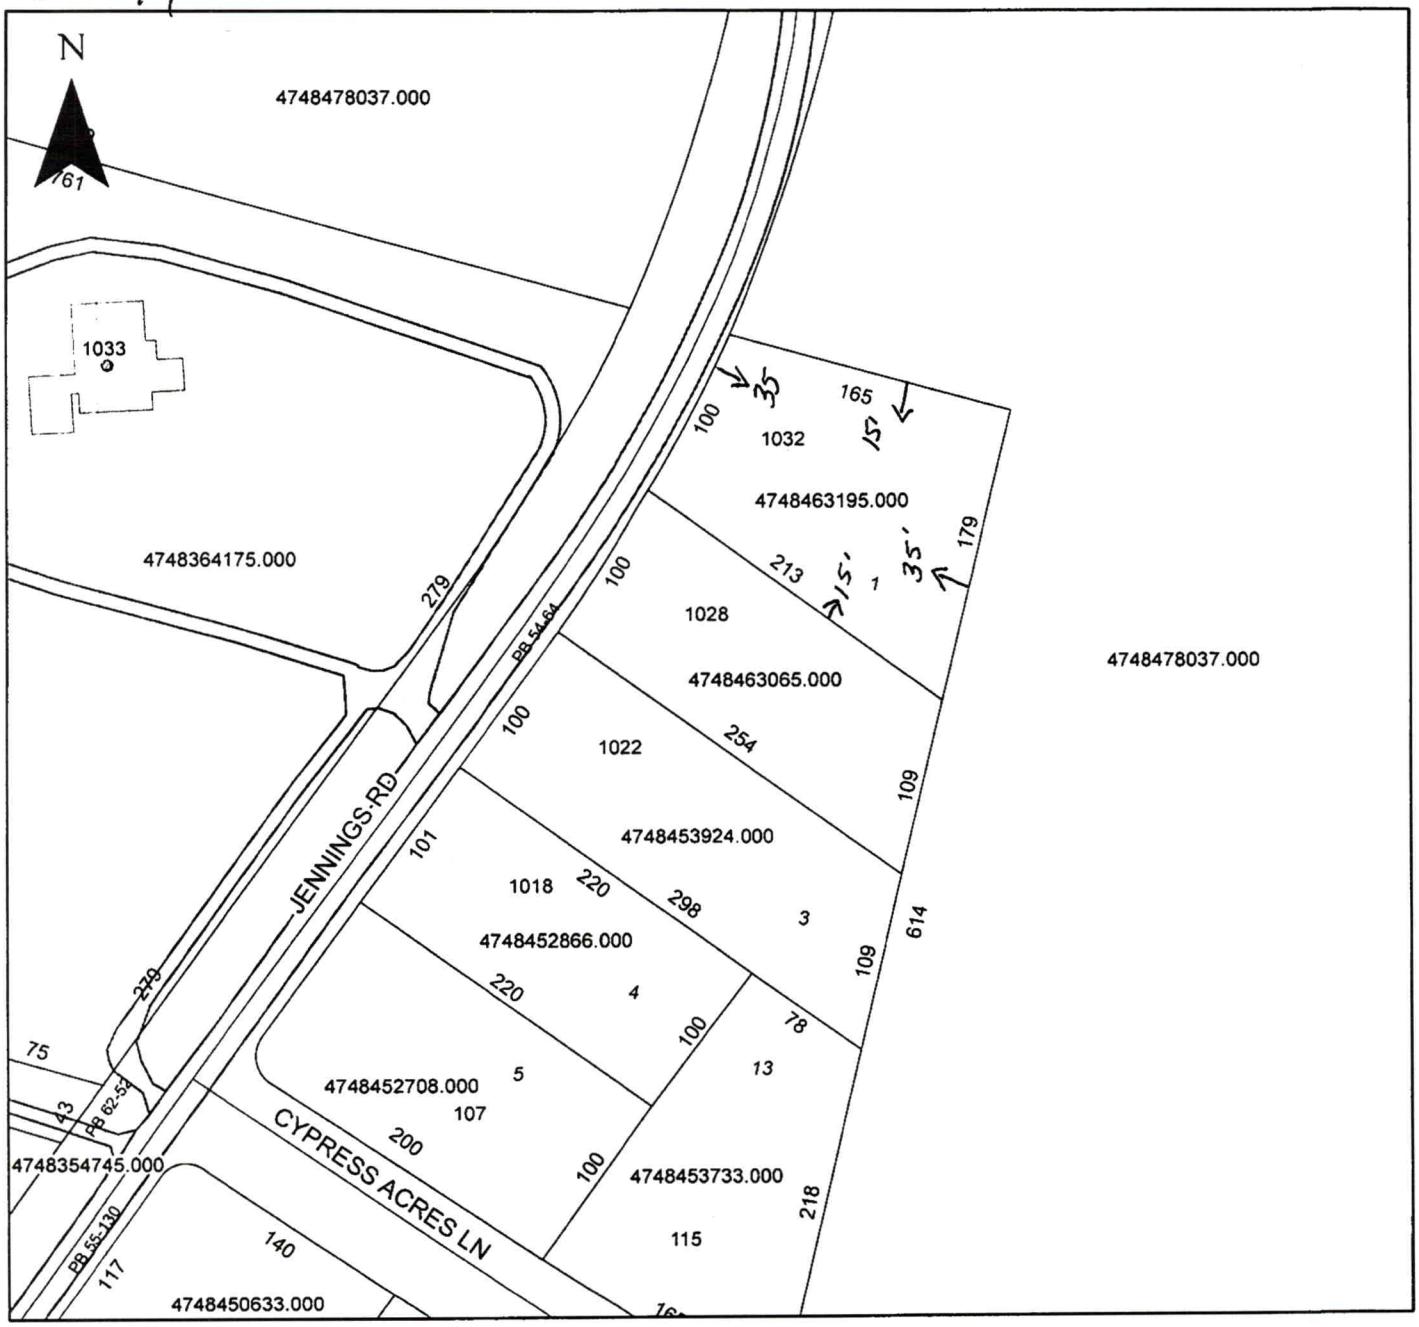

Property Address 1032 Jennings Rd.

The applicant certifies that there are no deed restrictions, contractual agreements or governmental regulations of any kind that interfere with or prohibit the use of the property or the use for which this permit is requested. Applicant further acknowledges that the enforcement of deed restrictions, plat conditions, and other contractual agreements will not be undertaken by Iredell County and is the sole responsibility of the affected parties.

L Fontana

Applicant

10-8-19

Date