Scott V. & Lindsay Chenevey

IREDELL COUNTY HEALTH DEPARTMENT

STATESVILLE 704-878-5305 MOORESVILLE 704-664-5281

IMPROVEMENT PERMIT / AUTHORIZATION TO CONSTRUCT / OPERATION PERMIT / EXISTING SYSTEM INSPECTION

PERMIT# 127503 PIN# 4748-59-~~4265~~ 4743 DATE 5-16-05

OWNER OR CONTRACTOR WYATT & WYATT CONSTRUCTION (BRN WYATT) PHONE: Business (336) 366-4118 Home (336) 366-7445

ADDRESS 180 GINSENG LANE ELKIN, NC 28621

LOCATION I-77 TL TOMLIN MILL RD TL JENNINGS ON LEFT BEFORE LENT2 RD

SUBDIVISION _____ BLOCK / SECTION _____ LOT _____ LOT AREA 4.993 SITE CLASS. P3 DESIGN FLOW 360 L.T.A.R. 0.30 GPD/FT²

Septic Tank: 1000 Gallons; STB 620 Date 3-18-05
Pump Tank: _____ Gallons; PT _____ Date _____
Pump Make: _____ Model _____ Serial No. _____
Nitrification Field: No Fields 1 Square Feet 1200 Linear Feet 300
No Lines 3 Trench Width 36" Max Trench Bottom Depth 30" Gravel Depth 12"

☑ New System ☐ Repair System Type: (I) II III IV, V, VI
System Description: (conv.) GRAVITY 25% REDUCTION
Repair System Description: LOW-PRESSURE PIPE
Maintenance Agreement Required: ☐ Yes ☑ No


☑ House/Mod. Home No. Bedrooms 3
☐ Mobile Home No. Bathrooms ____
☐ Business No. Employees ____
☐ Other _____
☐ Slab ☐ Crawl Space ☑ Basement w/plumbing ☐ Basement wo/plumbing

Water Supply:
☐ Individual
☑ Public
☐ Community


Comments:/Conditions: ① INSTALL LINES NO DEEPER THAN 30" ON CONTOUR ② MAINTAIN ALL SETBACKS ③ REMOVE BERM BELOW SYSTEM TO PREVENT PONDING ON SYSTEM

Comments:/Conditions: ① 'LABEL' FILTER IN TANK, NO MARKER (<6" BELOW GRADE) ② SYSTEM INSTALLED USING 'QUICK4' CHAMBERS

INITIAL SITE SKETCH

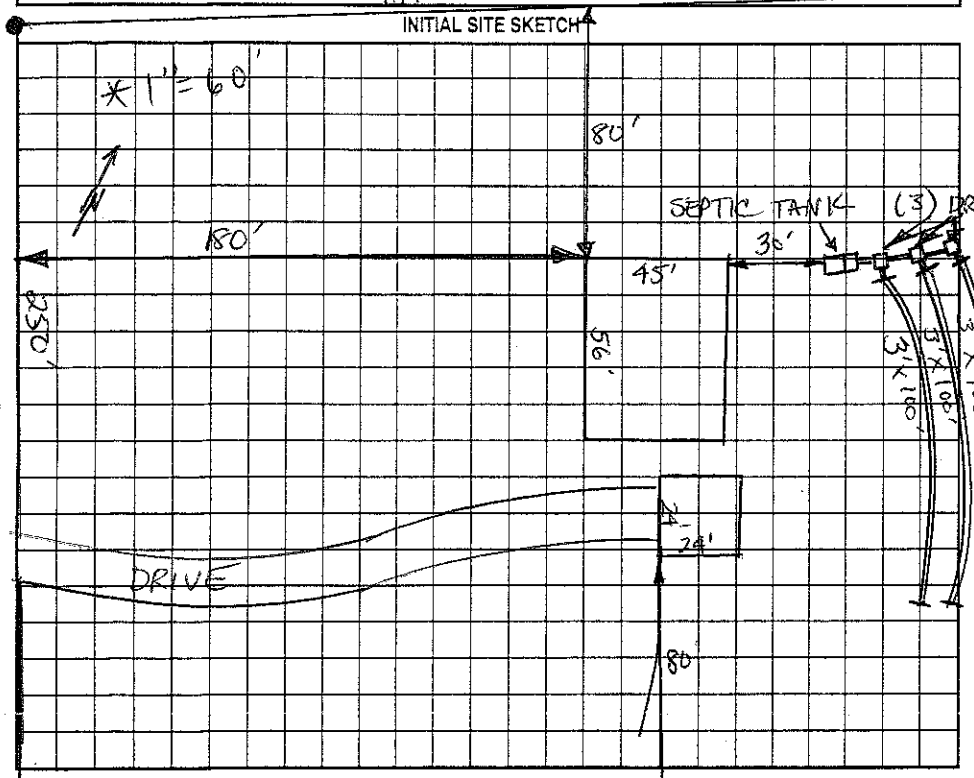

AS BUILT SKETCH

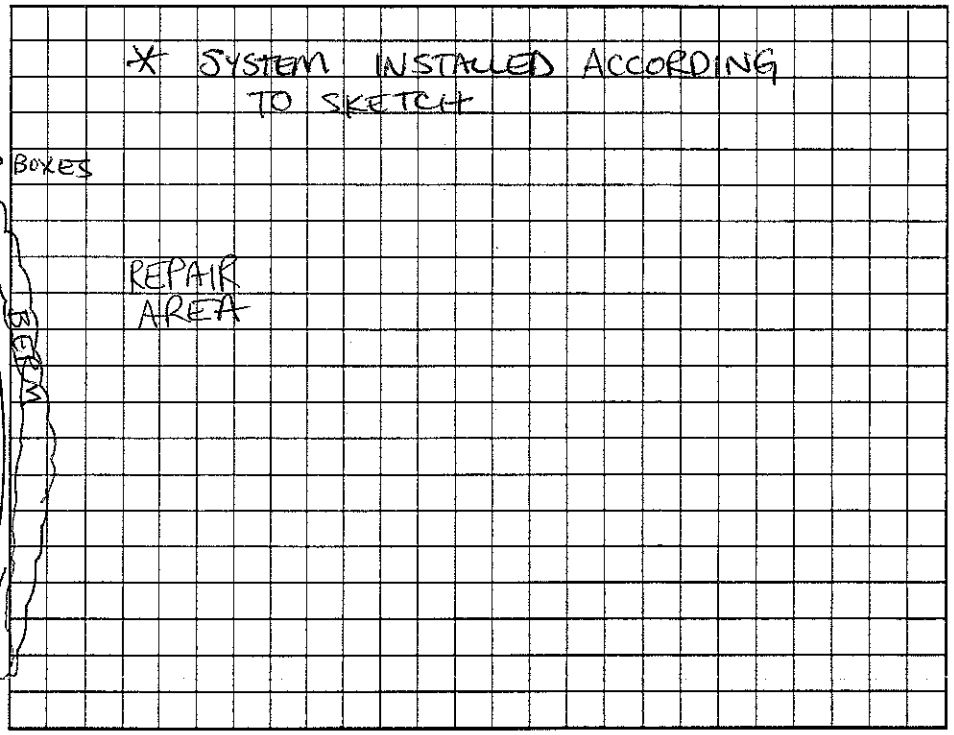

Permit can be suspended or revoked if any false information is supplied toward securing the permit/any unauthorized changes are made to the site/any unauthorized changes are made in the installation of the system. Improvement Permit with plat valid without expiration. Improvement Permit with site plan valid for sixty months. Authorization to Construct is valid for a period equal to that of Improvement Permit – not to exceed sixty months.

Signed: Brn Wyatt date 5-17-05 Installed by: JAMES GENTRY

Improvement Permit by: Christopher M. Sherrill, RS, LSS date 5-16-05 Operation Permit by: Christopher M. Sherrill, RS, LSS date 5-24-05

Authorization to Construct by: Christopher M. Sherrill, RS, LSS date 5-16-05 Existing System Inspection by: _____ date _____

HEALTH DEPT. COPY: WHITE OWNER COPY (FINAL): YELLOW OWNER COPY (INITIAL): PINK