IREDELL COUNTY HEALTH DEPARTMENT

STATESVILLE 704-878-5305 MOORESVILLE 704-664-5281

IMPROVEMENT PERMIT / AUTHORIZATION TO CONSTRUCT / OPERATION PERMIT / EXISTING SYSTEM INSPECTION

PERMIT# 073995 PIN# 4748748690 DATE 6-17-98

OWNER OR CONTRACTOR THOMAS WELCH PHONE: Business Home 528-3320

ADDRESS 894 S. MAIN ST. TROUTMAN NC 28166

LOCATION US 21 N, TL JENNINGS, TR LENTZ, TR LLOYD ROAD, TR WILLARD LANE, AT END ON LEFT

SUBDIVISION BLOCK / SECTION LOT LOT AREA 11.33 ACRES SITE CLASS. B DESIGN FLOW 480 L.T.A.R. 0.30 GPD/FT²

Septic Tank: 1000 Gallons; STB 1012 Date 4-22-98
Pump Tank: Gallons; PT Date
Pump Make: Model Serial No.
Nitrification Field: No Fields 1 Square Feet 1600 Linear Feet 533
No Lines FOUR Trench Width 36" Max Trench Bottom Depth 36" Gravel Depth

☑ New System ☐ Repair System Type: I (II) III, IV, V, VI
System Description: CONVENTIONAL GRAVITY
Repair System Description: CONV. GRAVITY
Maintenance Agreement Required: ☐ Yes ☑ No

☐ House/Mod. Home ☑ Mobile Home ☐ Business ☐ Other
No. Bedrooms 4 No. Bathrooms 2 No. Employees

☐ Slab ☑ Crawl Space ☐ Basement w/plumbing ☐ Basement wo/plumbing

Water Supply: ☑ Individual ☑ Public ☐ Community


Comments:/Conditions: KEEP SYSTEM 100' MINIMUM FROM WELL SITE

SCALE: 1" 60'


Comments:/Conditions:

WILLARD LANE

INITIAL SITE SKETCH

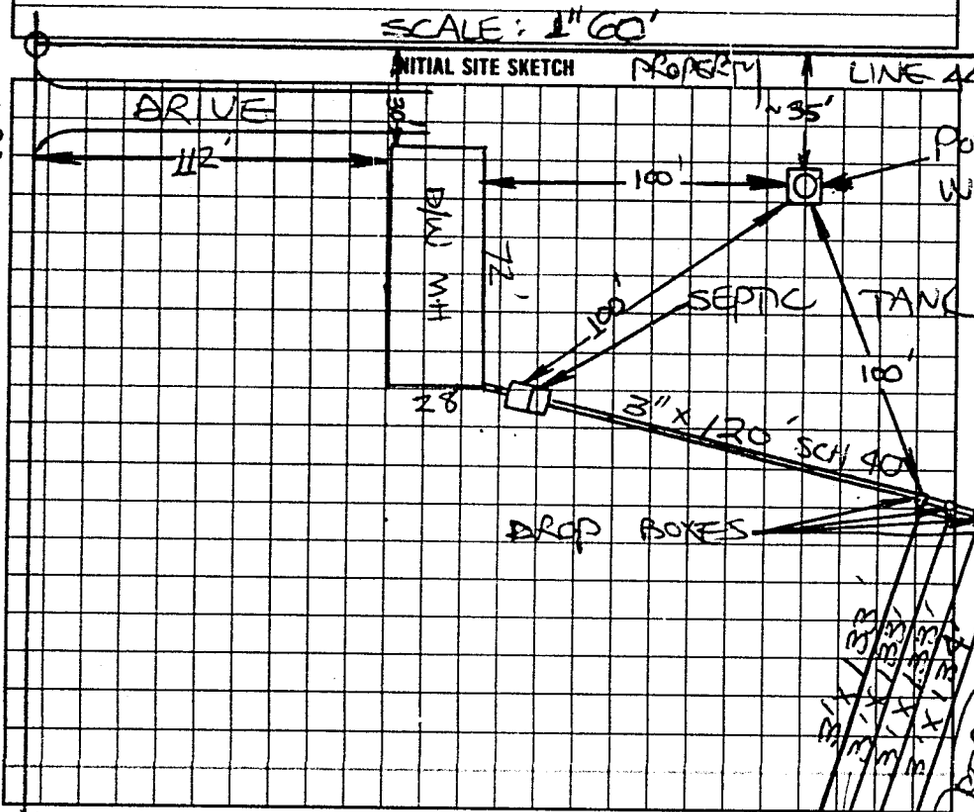

AS BUILT SKETCH

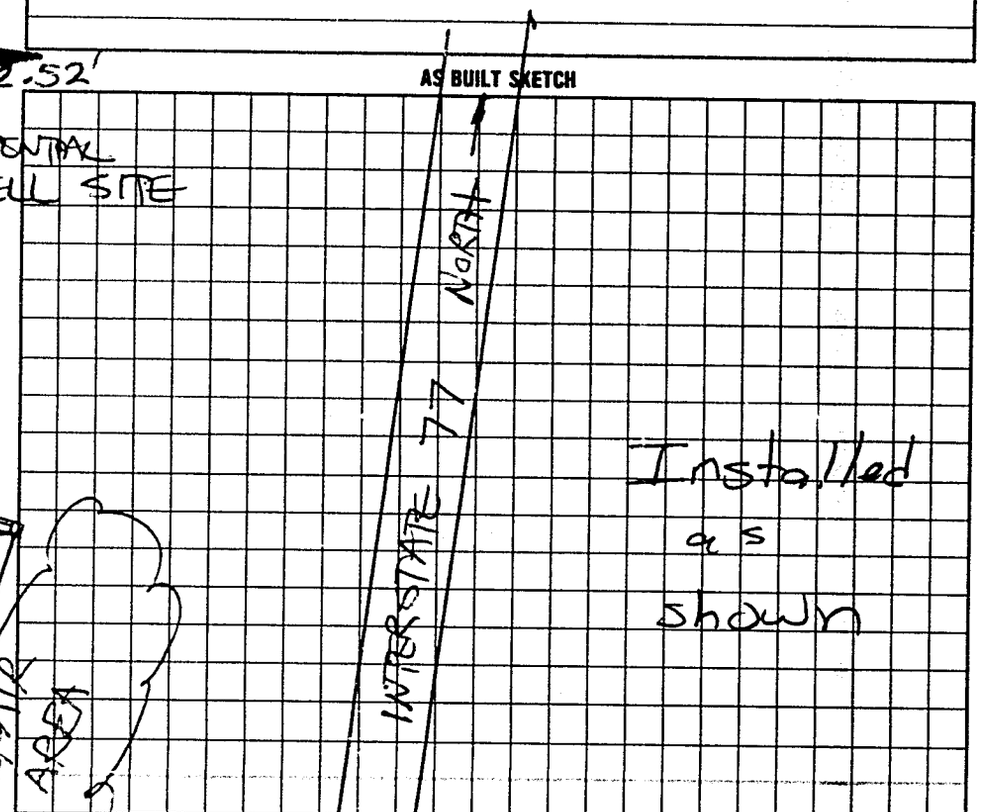

I understand that this permit can be suspended or revoked if any false information is supplied toward securing the permit/any unauthorized changes are made to the site/any unauthorized changes are made in the installation of the system. Improvement Permit with plat valid without expiration. Improvement Permit with site plan valid for sixty months. Authorization to Construct is valid for a period equal to that of Improvement Permit – not to exceed sixty months.

Signed: X Mark Wood date 6-18-98 Installed by: A-1 Backhoe

Improvement Permit by: STEVE HEDRICK date 6-17-98 Operation Permit by: M+C Out IS date 6-23-98

Authorization to Construct by: STEVE HEDRICK date 6-17-98 Existing System Inspection by: date

HEALTH DEPT COPY WHITE INSPECTION COPY (FINAL) GREEN OWNER COPY (FINAL) YELLOW INSPECTION COPY (INITIAL) PINK OWNER COPY (INITIAL) GOLD