IREDELL COUNTY HEALTH DEPARTMENT

STATESVILLE 704-878-5305 MOORESVILLE 704-664-5281

IMPROVEMENT PERMIT / CERTIFICATE OF COMPLETION / OPERATION PERMIT / EXISTING SYSTEM INSPECTION

PROPERTY DESCRIPTION NO. 2514673434 DATE 10-11-96 TAX MAP NO. 13C-A-2 (PART) Watershed: ☐ Yes ☒ No

OWNER OR CONTRACTOR TERRY ARMSTRONG PHONE: Business Home 663-0922

ADDRESS 850 LINWOOD ROAD MOORESVILLE, NC 28115

LOCATION US 21 N TL JENNINGS, TR LENTZ, TR LLOYD TR WILLARD LANE, LOT AT END ON RIGHT

SUBDIVISION DEER SPRING FARMS BLOCK / SECTION LOT 3 LOT AREA 11.146 AC SITE CLASS. PS DESIGN FLOW 360 L.T.A.R. 0.3 GPD/FT²

Septic Tank: 1000 Gallons; STB 1212 Date 10-21-96 ☑ New System ☐ Repair System Type: I, II, III, IV, V, VI

Pump Tank: Gallons; PT Date System Description: CONVENTIONAL GRAVITY

Pump Make: Model Serial No. Repair System Description: CONV. GRAVITY

Nitrification Field: No Fields 1 Square Feet 1200 Linear Feet 400 Maintenance Agreement Required: ☐ Yes ☒ No

No Lines FOUR Trench Width 36" Max Trench Bottom Depth 30" Gravel Depth 12" ☐ Slab ☐ Crawl Space ☒ Basement w/plumbing ☐ Basement wo/plumbing


☒ House/Mod. Home No. Bedrooms 3
☐ Mobile Home No. Bathrooms 2
☐ Business No. Employees
☐ Other

Water Supply: ☒ Individual ☐ Community ☐ Public WELL


Comments: KEEP SYSTEM MINIMUM 100' FROM WELL SITE

Comments:

INITIAL SITE SKETCH

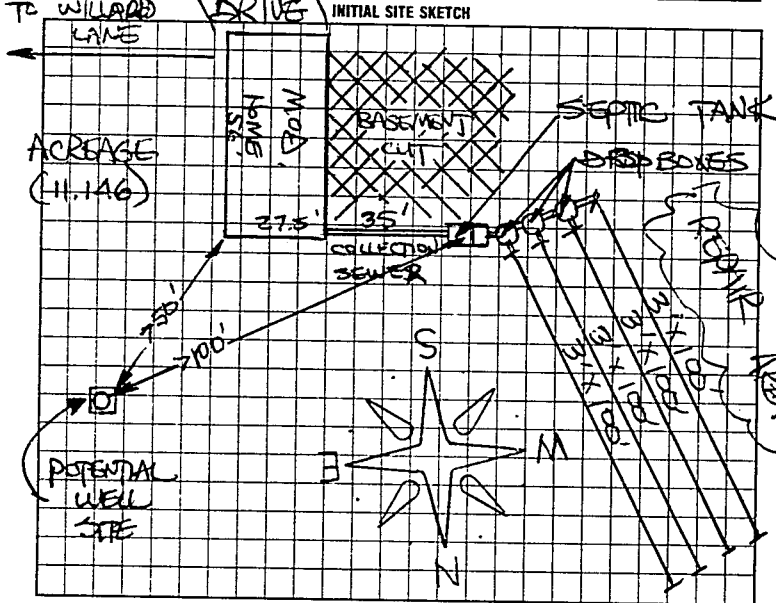

AS BUILT SKETCH

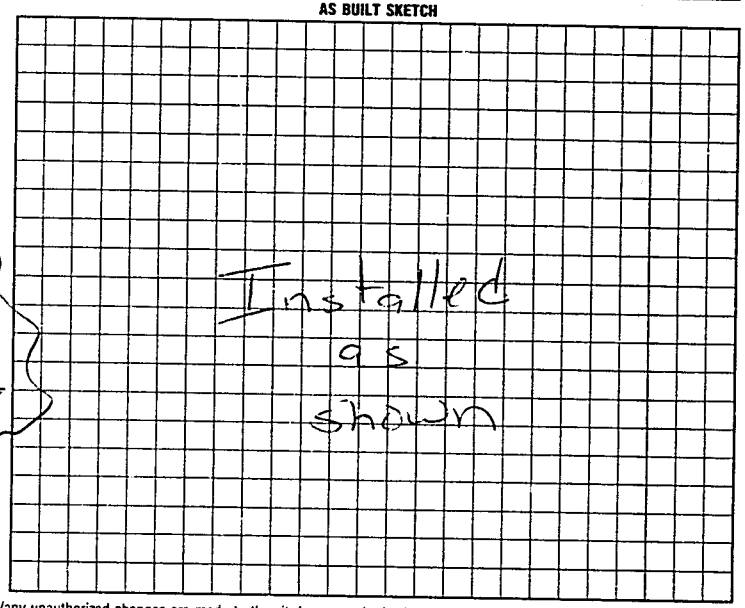

I understand that this permit can be suspended or revoked if any false information is supplied toward securing the permit/any unauthorized changes are made to the site/any unauthorized changes are made in the installation of the system.

AUTH. TO CONST. IS VALID FOR A PERIOD EQUAL TO THE VALIDITY OF THE I.P. NOT TO EXCEED FIVE YEARS. I.P. W/SITE PLAN IS VALID FOR FIVE YEARS.

Signed: X Terry Armstrong Installed by: Tommy Frye

Improvement Permit by: STEVE HERRICK date 10-11-96 Certificate of Completion by: date

AUTH. TO CONST. Existing System Inspection by: STEVE HERRICK date 10-11-96 Operation Permit by: date 7-10-98

HEALTH DEPT COPY WHITE INSPECTION COPY (FINAL) GREEN OWNER COPY (FINAL) YELLOW INSPECTION COPY (INITIAL) PINK OWNER COPY (INITIAL) GOLD