IREDELL COUNTY HEALTH DEPARTMENT

STATESVILLE 704-878-5305 MOORESVILLE 704-664-5281

IMPROVEMENT PERMIT / AUTHORIZATION TO CONSTRUCT / OPERATION PERMIT / EXISTING SYSTEM INSPECTION

PERMIT# 86830 PIN# 4749801239 DATE 1-05-00

OWNER OR CONTRACTOR Kelly mitchell PHONE: Business 336 669 3158 Home

ADDRESS 259 Lentz Rd Statesville 28625

LOCATION 21N TL Jennings TR Lentz 1/2 mi left

SUBDIVISION BLOCK / SECTION LOT LOT AREA 3.10 Acres SITE CLASS PS DESIGN FLOW 360 L.T.A.R. .33gal/sf/day

Septic Tank: 1000 Gallons; STB 1012 Date 11-21-99
Pump Tank: Gallons; PT Date
Pump Make: Model Serial No.
Nitrification Field: No Fields 1 Square Feet 1080 Linear Feet 360
No Lines 3 Trench Width 36" Max Trench Bottom Depth 36" Gravel Depth 12"

(X) New System ( ) Repair System Type: I (II) III IV V VI
System Description: Conv. Gravity
Repair System Description:
Maintenance Agreement Required: ( ) Yes (X) No

(X) House/Mod. Home No. Bedrooms 3
( ) Mobile Home No. Bathrooms 2
( ) Business No. Employees
( ) Other

( ) Slab (X) Crawl Space ( ) Basement w/plumbing ( ) Basement wo/plumbing

Water Supply: ( ) Individual (X) Public ( ) Community


Comments/Conditions:

369.05'


Comments/Conditions:

End of Long Lines Stabilized (6" rock)
May Need To RESET Top 2 Dist Boxes
if Failure occurs

INITIAL SITE SKETCH

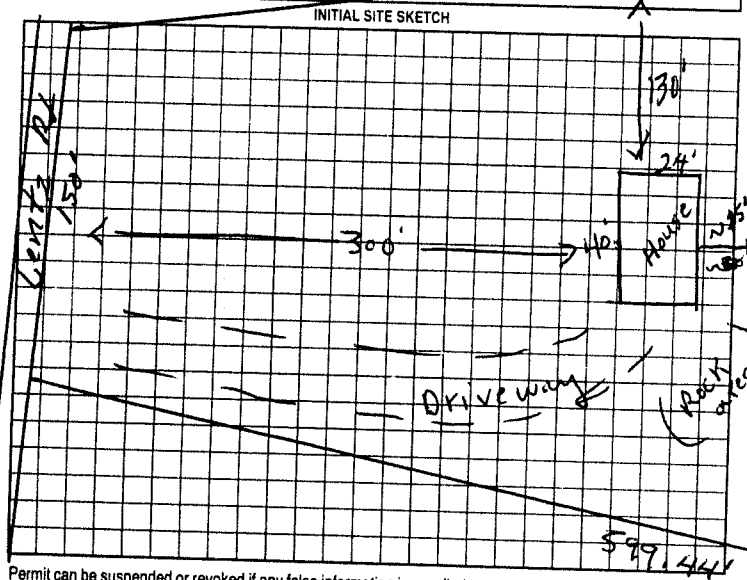

AS BUILT SKETCH

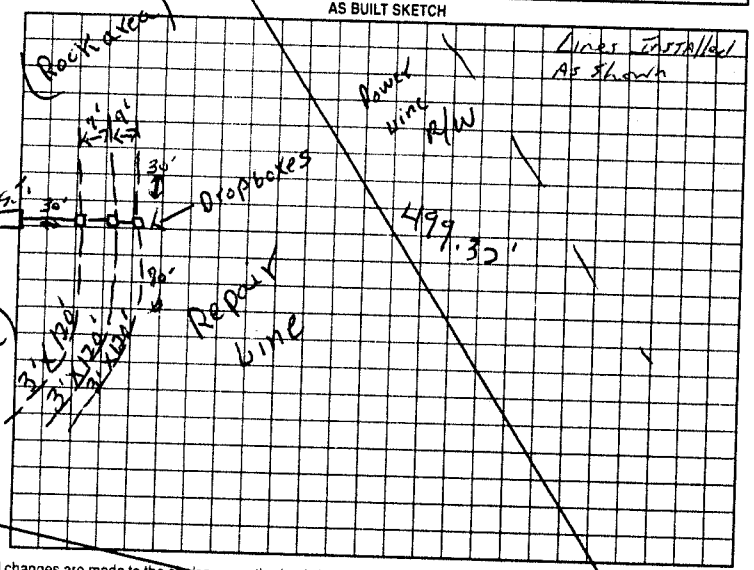

Permit can be suspended or revoked if any false information is supplied toward securing the permit/any unauthorized changes are made to the site/any unauthorized changes are made in the installation of the system. Improvement Permit with plat valid without expiration. Improvement Permit with site plan valid for sixty months. Authorization to Construct is valid for a period equal to that of Improvement Permit – not to exceed sixty months.

Signed: [signature] date 1-05-00 Installed by: Gallimore Grading

Improvement Permit by: P. C. Moore date 1-05-00 Operation Permit by: C. Potter date Mar. 29, 2000

Authorization to Construct by: P. C. Moore date 1-05-00 Existing System Inspection by: date

HEALTH DEPT COPY WHITE OWNER COPY (FINAL) YELLOW OWNER COPY (INITIAL) PINK