IREDELL COUNTY HEALTH DEPARTMENT

STATESVILLE 704-878-5305 MOORESVILLE 704-664-5281

IMPROVEMENT PERMIT / AUTHORIZATION TO CONSTRUCT / OPERATION PERMIT / EXISTING SYSTEM INSPECTION

PERMIT# 70923 PIN# 4748851502

OWNER OR CONTRACTOR John + Lori Root PHONE: Business Home 876-2828 DATE 7-27-99

ADDRESS 534 Carolina Ave Statesville

LOCATION 77N TL Tomlin Mill TL Lentz Rd TL Lloyd Rd TR Willard on left top of Hill

SUBDIVISION Bear Creek BLOCK / SECTION LOT 1 LOT AREA 11acres SITE CLASS P/S DESIGN FLOW 480 L.T.A.R. 0.3

Septic Tank: 1050 Gallons: STB 1007 Date 5-14-99

Pump Tank: Gallons: PT Date

Pump Make: Model Serial No

Nitrification Field: No Fields 1 Square Feet 1599 Linear Feet 533

No Lines 5 Trench Width 36in Max Trench Bottom Depth 36in Gravel Depth 12in

[X] New System [ ] Repair System Type [ ] II [ ] III, IV, V, VI

System Description: Gravity Conventional

Repair System Description: Conventional

Maintenance Agreement Required: [ ] Yes [X] No

[X] House/Mod. Home [ ] Mobile Home [ ] Business [ ] Other

No. Bedrooms 4 No. Bathrooms 3 1/2 No. Employees

[ ] Slab [X] Crawl Space [ ] Basement w/plumbing [ ] Basement wo/plumbing


Water Supply: [X] Individual [ ] Public [ ] Community

Comments /Conditions: Install 5 lines on contour
Keep well 100 Ft from system


Comments /Conditions

Note: First line split feed
rest end feed

INITIAL SITE SKETCH

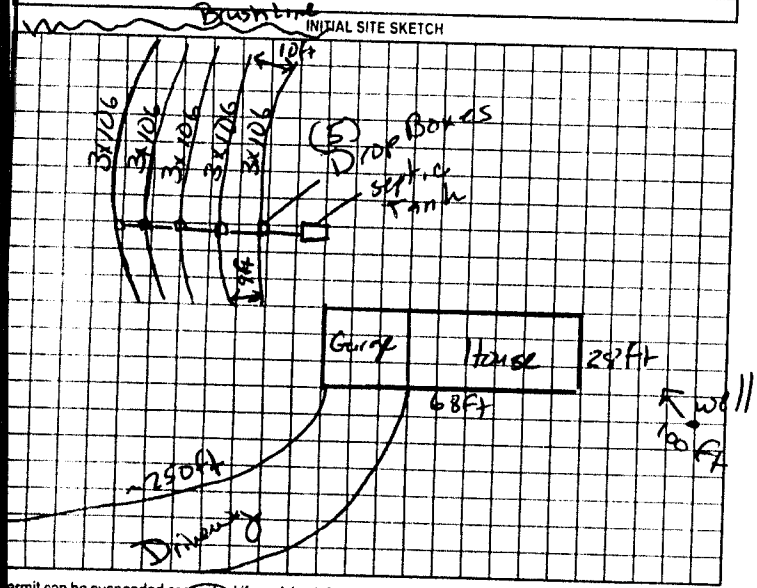

AS BUILT SKETCH

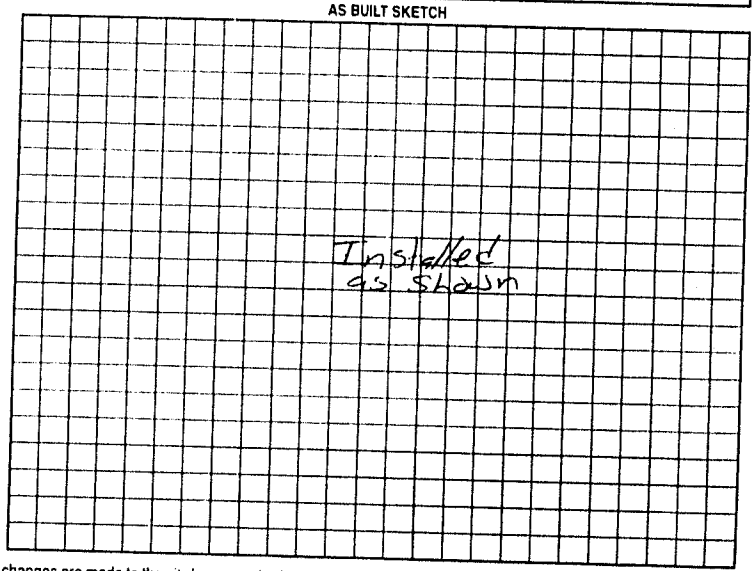

Permit can be suspended or revoked if any false information is supplied toward securing the permit/any unauthorized changes are made to the site/any unauthorized changes are made in the installation of the system. Improvement Permit with plat valid without expiration. Improvement Permit with site plan valid for sixty months. Authorization to Construct is valid for a period equal to that of Improvement Permit – not to exceed sixty months.

Signed: Not Root date 7/27/99 Installed by: James Hunter

Improvement Permit by: Mary C Ott RS date 7-27-99 Operation Permit by: Mary C Ott RS date 8-18-99

Authorization to Construct by: Mary C Ott RS date 7-27-99 Existing System Inspection by: date

HEALTH DEPT COPY WHITE OWNER COPY (FINAL) YELLOW OWNER COPY (INITIAL) PINK