IREDELL COUNTY HEALTH DEPARTMENT

STATESVILLE 704-878-5305 MOORESVILLE 704-664-5281

IMPROVEMENT PERMIT / CERTIFICATE OF COMPLETION / OPERATION PERMIT / EXISTING SYSTEM INSPECTION

PROPERTY DESCRIPTION NO. Repair DATE 6-4-93 TAX MAP NO. Repair

OWNER OR CONTRACTOR Don Anderson PHONE: Business Home

ADDRESS

LOCATION I-77 N TL Tomlin Mill Rd. TL Hentz Rd. 1st house on R past sharpe right-hand curve

SUBDIVISION NA BLOCK / SECTION LOT LOT AREA Ample SITE CLASS. P.S. L.T.A.R. Existing

Water Supply: ☑ Individual ☐ Community ☐ Public Well

Septic Tank: Existing Gallons; STB Date

Pump Tank: Gallons; PT Date

Nitrification Field: No Fields 2 Square Feet 300 Linear Feet 100'

No Lines 1 Trench Width 36" Trench Depth 36" Gravel Depth 12"

☐ New System ☑ Repair System Type: I, (II), III, IV, V, VI

System Description: conventional, gravity fed

Repair System Description: " "

Maintenance Agreement Required: ☐ Yes ☑ No

☑ House/Mod. Home ☐ Mobile Home ☐ Business ☐ Other

No. Bedrooms 3 No. Bathrooms 2 No. Employees -

Garbage Disposal: ☐ Yes ☑ No

Auto. Dishwasher: ☐ Yes ☑ No


Auto. Washing Machine: ☑ Yes ☐ No

Other


☐ Slab ☑ Crawl Space ☐ Basement w/plumbing ☐ Basement wo/plumbing

Comments System turned down on 1st Final inspection, grader on repair line had 2' of fall, used slotted corragated pipe, and D-box set wrong. Existing lines 3/4 clogged up with sludge.

INITIAL SITE SKETCH

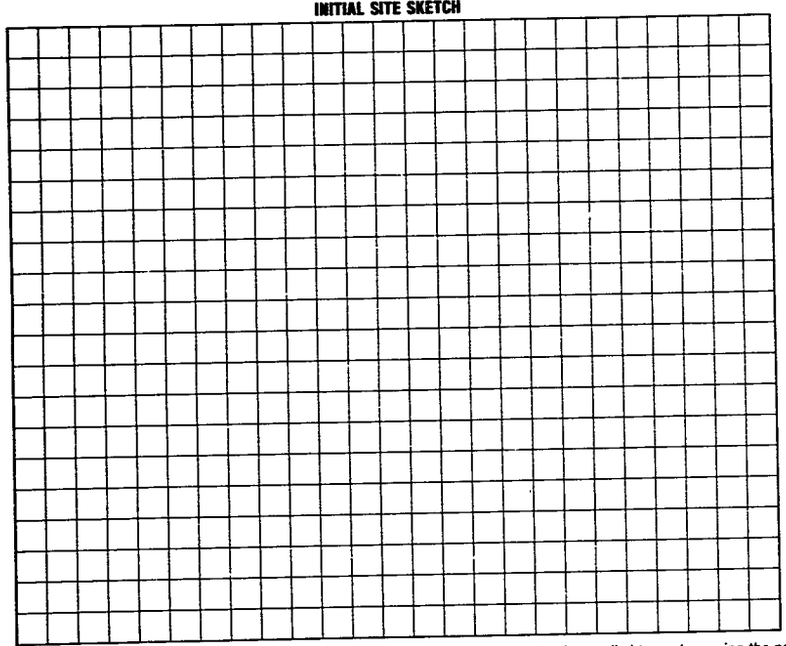

AS BUILT SKETCH

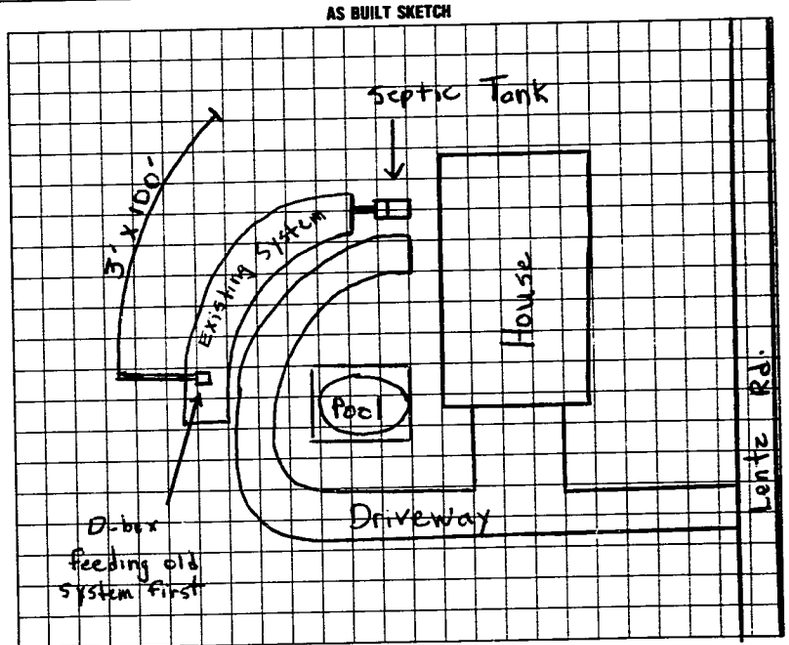

I understand that this permit can be suspended or revoked if any false information is supplied toward securing the permit/any unauthorized changes are made to the site/any unauthorized changes are made in the installation of the system. Improvement Permit is valid for 60 months from date of issuance.

Signed:

Improvement Permit by: Steve Hedrick date 5-12-93

Existing System Inspection by: date

Installed by: Billy Jones

Certificate of Completion by: Michael J. Dennis date 6-4-93

Operation Permit by: date

HEALTH DEPT. COPY: WHITE INSPECTION COPY (FINAL): GREEN OWNER COPY (FINAL): YELLOW INSPECTION COPY (INITIAL): PINK OWNER COPY (INITIAL): GOLD