IREDELL COUNTY HEALTH DEPARTMENT

STATESVILLE 704-878-5305 MOORESVILLE 704-664-5281 (c1)

IMPROVEMENT PERMIT / AUTHORIZATION TO CONSTRUCT / OPERATION PERMIT / EXISTING SYSTEM INSPECTION

PERMIT# 106770 PIN# 4892-00-4693 DATE 6-12-02

OWNER OR CONTRACTOR JOHN D. BURTON PHONE: Business Home 704-546-7870

ADDRESS 553 ABBEYDALE ROAD, HARMONY, NC 28634

LOCATION US 21 N, TR POWELL BRIDGE, TL ROCKY FORD, TR ABBEYDALE RD, ON LEFT AT BOX # 553

SUBDIVISION BLOCK / SECTION LOT LOT AREA 1.87 ACRE SITE CLASS PS DESIGN FLOW 240 L.T.A.R. 0.30 GPD/FT²

Septic Tank: 1000 Gallons; STB 620 Date 11-9-98
Pump Tank: Gallons; PT Date
Pump Make: Model Serial No.
Nitrification Field: No. Fields 1 Square Feet 810 Linear Feet 810
No. Lines FOUR Trench Width 36" Max Trench Bottom Depth 36"

☐ New System ☐ Repair System Type: I II III IV V
System Description: CONVENTIONAL GRAVITY
Repair System Description: 50% REDUCTION, GRAVITY
Maintenance Agreement Required: ☐ Yes ☒ No

☐ House/Mod Home ☑ Mobile Home ☐ Business ☐ Other
No. Bedrooms 3 No. Bathrooms 2 No. Employees

☐ Slab ☐ Crawl Space ☐ Basement w/plumbing ☐ Basement wo/plumbing


Water Supply: ☑ Individual ☐ Public ☐ Community WELL

Comments/Conditions:

Comments/Conditions

INITIAL SITE SKETCH

AS BUILT SKETCH

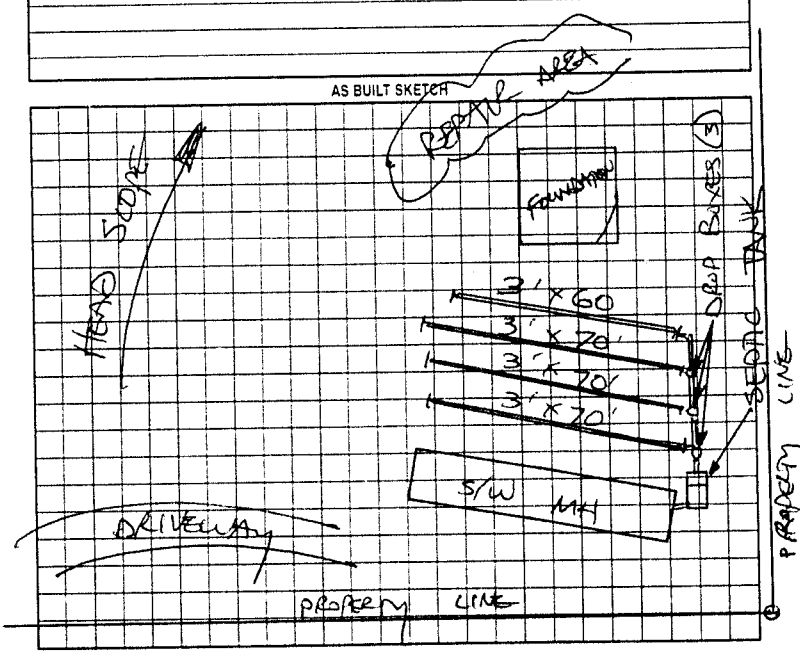

Permit can be suspended or revoked if any false information is supplied toward securing the permit/any unauthorized changes are made to the site/any unauthorized changes are made in the installation of the system. Improvement Permit with plat valid without expiration. Improvement Permit with site plan valid for sixty months. Authorization to Construct is valid for a period equal to that of Improvement Permit – not to exceed sixty months.

Signed: date Installed by:

Improvement Permit by: date Operation Permit by: date

Authorization to Construct by: date Existing System Inspection by: STEVE HERRICK date 6-12-02

HEALTH DEPT. COPY WHITE OWNER COPY (FINAL) YELLOW OWNER COPY (INITIAL) PINK