IREDELL COUNTY HEALTH DEPARTMENT

Statesville Office (704) 878-5305 Mooresville Office (704) 660-3625 PERMIT # 177080

IMPROVEMENT PERMIT / AUTHORIZATION TO CONSTRUCT / OPERATION PERMIT / EXISTING SYSTEM

PIN # 4749126078

APPLICANT: Steve Sordan (Ralph Dancy) APPLICANT ADDRESS: 165 Church Lane Dr

SITE ADDRESS: 272 Snow Creek Rd. PHONE: 704-902-2991 ALT. PHONE: N/A


SITE DIRECTIONS: Hwy 21 N TL Jennings Rd. TL Snow Creek Rd.

SUBDIVISION: N/A SECTION: N/A LOT # N/A LOT AREA: 0.51 acres DESIGN FLOW: 360 L.T.A.R.: 0.3

Septic Tank	Existing	(gal)	STB		Date		☐ New System	☑ Repair	☐ Expansion	System Type: I II ~~III~~ IV V VI	☑ ~~Residence~~	No. Bedrooms	3	**Water Supply**			
Pump Tank		(gal)	PT		Date		System Description:				☐ Business	No. Persons		☑ ~~Private~~			
Pump Make		Model			Serial #		Repair System Description:	25% Reduction			☐ Other	No. Employees		☑ ~~Public~~			
# Nitrification Fields	1	# Lines	3		Linear Ft:	154	Maintenance Agreement Required:	☐ YES	☑ ~~NO~~		☐ Slab	☑ ~~Crawl Space~~		☐ Community			
Trench Width	36"	Max. Trench Bottom Depth	36"		Gravel Depth	N/A		☑ GRAVITY	☐ PRESSURE		☐ Basement w/plumbing			☐ Basement w/o plumbing			

Comments / Conditions: Install a 25% Reduction System on contour with serial distribution. Replace septic tank if needed

INITIAL SITE SKETCH

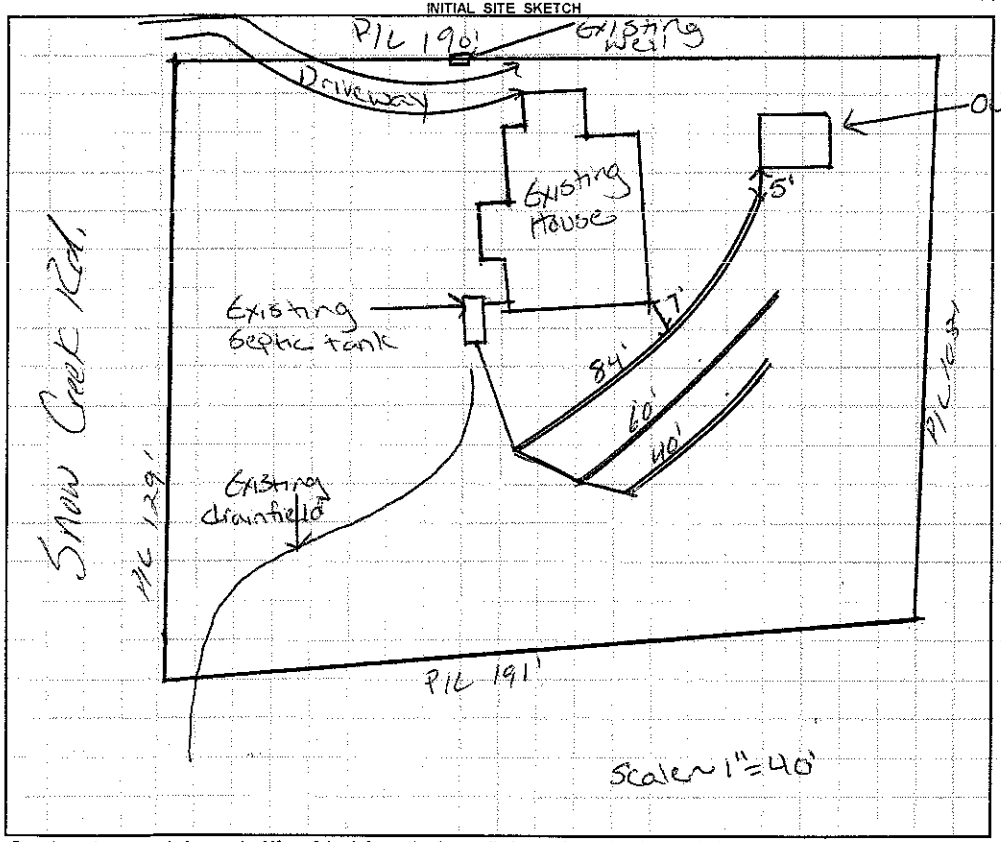

AS BUILT SKETCH

- Quick 4 chambers installed
- Installed as drawn

Permit can be suspended or revoked if any false information is supplied toward securing the permit / any unauthorized changes are made to the site / any unauthorized changes are made in the installation of the system. **CONTACT A LOCATOR SERVICE PRIOR TO ANY EXCAVATION**

☐ **IMPROVEMENT PERMIT** ***with plat*** *valid without expiration.* ☑ **IMPROVEMENT PERMIT** ***with site plan*** *valid for 60 mos.* ☑ **AUTHORIZATION TO CONSTRUCT** *valid for period equal to IMPROVEMENT PERMIT--not to exceed 60 mo.*

Owner / Applicant Signature: Steve Jordan Date: Installed by: Steve Jordan

IMPROVEMENT PERMIT by: Justin Henderson Date: 2-18-13 OPERATION PERMIT by: Justin Henderson Date: 2-20-13

AUTHORIZATION TO CONSTRUCT by: Justin Henderson Date: 2-18-13 Existing System Inspected by: Date:

Health Dept. Copy - WHITE Applicant (Final Approval) - YELLOW Applicant (Conditional Approval) - PINK