IREDELL COUNTY HEALTH DEPARTMENT

STATESVILLE 704-878-5305 MOORESVILLE 704-664-5281

IMPROVEMENT PERMIT / AUTHORIZATION TO CONSTRUCT / OPERATION PERMIT / EXISTING SYSTEM INSPECTION

PERMIT # 158536 PIN # 4774947552 DATE 10-27-09

OWNER or APPLICANT James Shavel (Clayton mH) PHONE: Business Home:

OWNER or APPLICANT ADDRESS 350 Friendship Rd Statesville 28625

LOCATION / DIRECTIONS 21 N (R) Jennings (R) Friendship at 3.3M Friendship

SUBDIVISION BLOCK / SECTION LOT # LOT AREA 1 AC DESIGN FLOW 360 L.T.A.R. .0Exist

Septic Tank Exist Gallons: STB Exist Date

Pump Tank Gallons: P T Date

Pump Make Model Serial #

Nitrification Field No Fields No Lines 3 Linear Feet Exist 1,240

Trench Width Exist Max. Trench Bottom Depth Exist Gravel Depth 12"

~~New System~~ Repair Expansion System Type I II III IV V VI

System Description: Conventional Trench

Repair System Description: Pump Backyard

Maintenance Agreement Required YES NO

GRAVITY PRESSURE

Residence No. Bedrooms 3

Business No. Persons

Other No. Employees

Slab Crawl Space

Basement w/plumbing Basement w/o plumbing


Water Supply: Private Public Community

Comments / Conditions

Comments / Conditions

INITIAL SITE SKETCH

AS BUILT SKETCH

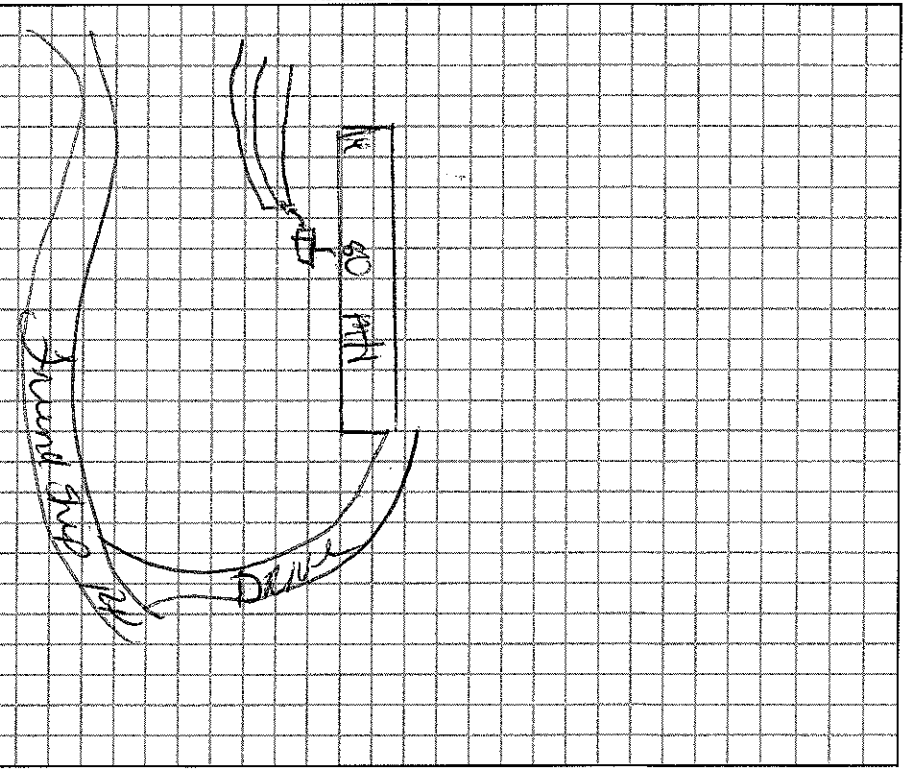

Permit can be suspended or revoked if any false information is supplied toward securing the permit / any unauthorized changes are made to the site / any unauthorized changes are made in the installation of the system.

☐ *IMPROVEMENT PERMIT w / plat valid without expiration* ☐ *IMPROVEMENT PERMIT w / site plan valid for 60 mos.* ☐ *AUTHORIZATION TO CONSTRUCT valid for period equal to IMPROVEMENT PERMIT-not to exceed 60 mo.*

Owner / Applicant Signature: Date 10/28/09

Improvement Permit by: Date

Authorization to Construct by: Date

YOU SHOULD CONTACT A LOCATOR SERVICE PRIOR TO ANY EXCAVATION.

Installed by:

Operation Permit by: Date:

Existing System Inspected by: Date: 10/28/09

WHITE COPY Environmental Health YELLOW COPY (Final) Owner / Applicant PINK COPY (Initial) Owner / Applicant