IREDELL COUNTY HEALTH DEPARTMENT

STATESVILLE 704-878-5305 (CI) MOORESVILLE 704-664-5281

IMPROVEMENT PERMIT / AUTHORIZATION TO CONSTRUCT / OPERATION PERMIT / EXISTING SYSTEM INSPECTION

PERMIT# 114672 PIN# 4749-53-~~7220~~ 7481 DATE 8-15-03

OWNER OR CONTRACTOR CLARENCE PITTS PHONE: Business _____ Home 704-876-1755

ADDRESS 159 POVERTY HILL LANE STATESVILLE, NC 28625

LOCATION 21N @ JENNINGS, @ FRIENDSHIP ® ≈ 1/8 on rt LOT # 1

SUBDIVISION CHARLES ACRES BLOCK / SECTION _____ LOT 1 LOT AREA .526 AC SITE CLASS. PS DESIGN FLOW 240 L.T.A.R. .25

Septic Tank: 1000 Gallons; STB 1017 Date 4-21-03
Pump Tank: _____ Gallons; PT _____ Date _____
Pump Make: _____ Model _____ Serial No. _____
Nitrification Field: No Fields 1 Square Feet ~~600~~ 960' Linear Feet 240'
No Lines 4 Trench Width 36" Max Trench Bottom Depth 36" Gravel Depth N/A

[X] New System [ ] Repair System Type: I, II, (III), IV, V, VI
System Description: GRAV 25% REDUCT
Repair System Description: LP PANEL
Maintenance Agreement Required: [ ] Yes [X] No


[X] House/Mod. Home No. Bedrooms 2
[ ] Mobile Home No. Bathrooms 1 1/2
[ ] Business No. Employees _____
[ ] Other _____
[ ] Slab [X] Crawl Space [ ] Basement w/plumbing [ ] Basement wo/plumbing

Water Supply: [ ] Individual [X] Public [ ] Community

Comments/Conditions: (1) KEEP STUBOUT 12" ABOVE NATURAL GRADE SO GRAVITY CAN BE MAINTAINED TO FIRST LINE & SO THE LINE WILL NOT EXCEED 36". (2) INSTALL LINES ON CONTOURS AS 1"=50'

Comments/Conditions: MAINTAIN SETBACKS; (3) SYSTEM IS COMPLETELY FLAGGED OUT. TUFFTITE FILTER + MARKER

INITIAL SITE SKETCH

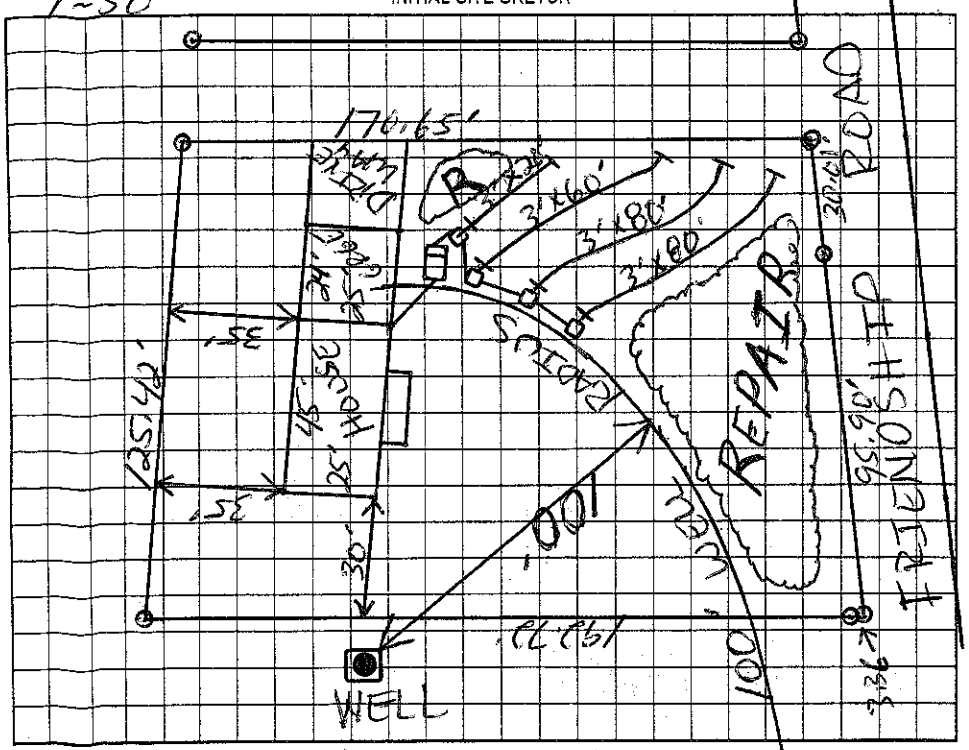

AS BUILT SKETCH

LAST DITCH 80' FROM WELL. ALLOWED. NO SAPROLITE IN SOIL
LINE BOXES SET W/ROOT, TURNED AROUND CORRECTLY & PLUGGED HOLES. VIO EVERYTHING OK 10-31-03 CL

Permit can be suspended or revoked if any false information is supplied toward securing the permit/any unauthorized changes are made to the site/any unauthorized changes are made in the installation of the system. Improvement Permit with plat valid without expiration. Improvement Permit with site plan valid for sixty months. Authorization to Construct is valid for a period equal to that of Improvement Permit – not to exceed sixty months.

Signed: Clarence Pitts date 8/18/03 Installed by: PITTS / SELF INSTALLED

Improvement Permit by: [signature] date 8-15-03 Operation Permit by: [signature] date 10-30-03

Authorization to Construct by: [signature] date 8-18-03 Existing System Inspection by: _____ date _____

HEALTH DEPT. COPY: WHITE OWNER COPY (FINAL): YELLOW OWNER COPY (INITIAL): PINK