IREDELL COUNTY HEALTH DEPARTMENT

STATESVILLE 704-878-5305 MOORESVILLE 704-664-5281

IMPROVEMENT PERMIT / AUTHORIZATION TO CONSTRUCT / OPERATION PERMIT / EXISTING SYSTEM INSPECTION

PERMIT # REPAIR PIN # 4749-53-8747 DATE NOVEMBER 20, 2008

OWNER or APPLICANT DAVID L. ANNAS PHONE: Business 704-928-5084 Home: 704-876-0776

OWNER or APPLICANT ADDRESS 148 FRIENDSHIP ROAD, STATESVILLE, NC 28625-9590

LOCATION / DIRECTIONS US 21 NORTH, TL JENNINGS ROAD, TL FRIENDSHIP ROAD, HOUSE ON RIGHT AT # 148

SUBDIVISION BLOCK / SECTION LOT # LOT AREA 3.03AC DESIGN FLOW 360 L.T.A.R. 0.30 gpd/sf2

Septic Tank EXISTING Gallons: STB Date

Pump Tank Gallons: P T Date

Pump Make Model Serial #

Nitrification Field No Fields No Lines 2 Linear Feet 160

Trench Width 36" Max. Trench Bottom Depth 36" Gravel Depth N/A

☐ New System ☑ Repair ☐ Expansion System Type I II (III) IV V VI

System Description: 3

Repair System Description: 25% REDUCTION, GRAVITY

Maintenance Agreement Required ☐ YES ☑ NO

☑ GRAVITY ☐ PRESSURE

☑ Residence No. Bedrooms 3

☐ Business No. Persons

☐ Other No. Employees

☐ Slab ☐ Crawl Space


☑ Basement w/plumbing ☐ Basement w/o plumbing

Water Supply: ☑ Private ☑ Public (Both) ☐ Community


Comments / Conditions: 3 INSTALL NEW DROP BOX AT LOCATION SHOWN, INTERCEPTING EXISTING LINE @ INSTALL NEW 25% REDUCTION SYSTEM ON CONTOUR USING SERIAL DISTRIBUTION.

Comments / Conditions

INITIAL SITE SKETCH

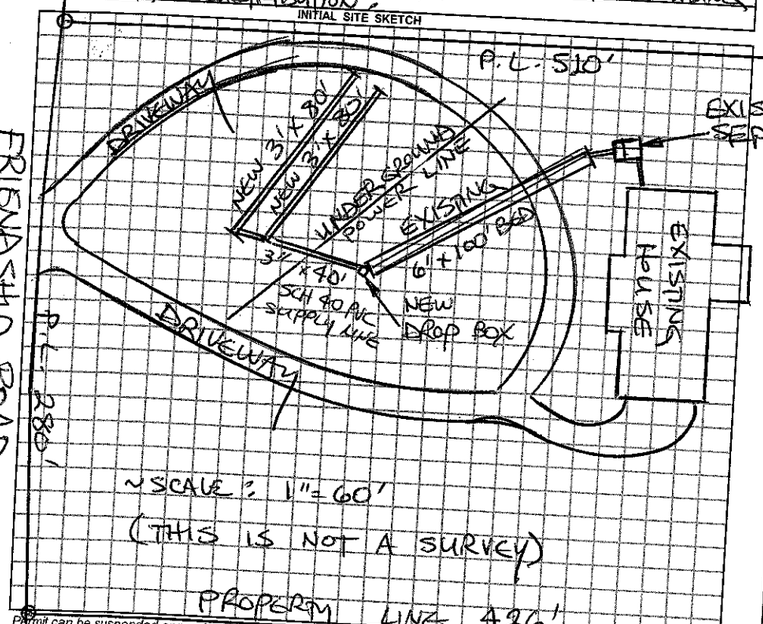

AS BUILT SKETCH

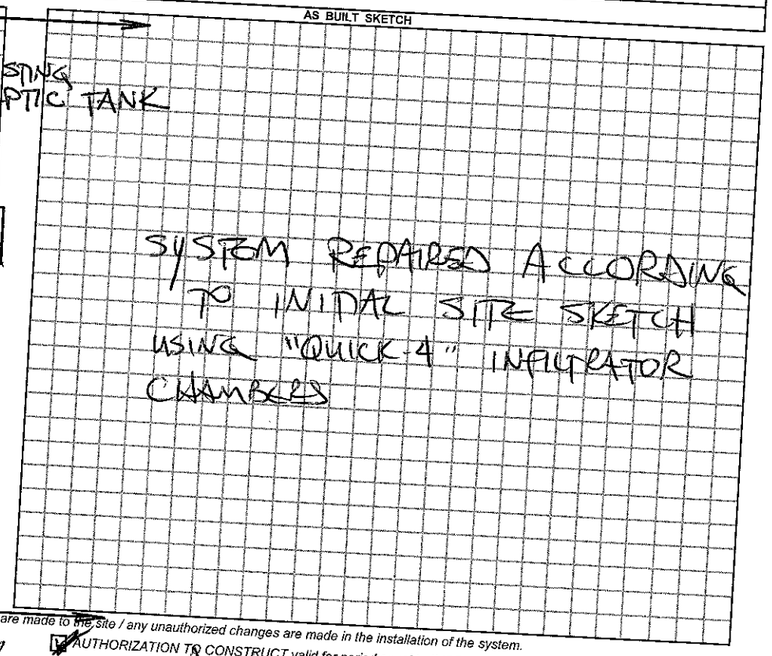

FRIENDSHIP ROAD R86-

Permit can be suspended or revoked if any false information is supplied toward securing the permit / any unauthorized changes are made to the site / any unauthorized changes are made in the installation of the system.

☐ IMPROVEMENT PERMIT w / plat valid without expiration ☑ IMPROVEMENT PERMIT w / site plan valid for 60 mos. ☑ AUTHORIZATION TO CONSTRUCT valid for period equal to IMPROVEMENT PERMIT-not to exceed 60 mo.

Owner / Applicant Signature: Date 11-20-8 Installed by: A-1 BACKHOE

Improvement Permit by: STEVE HEDRICK Date 11-20-2008 Operation Permit by: STEVE HEDRICK Date: 12-3-08

Authorization to Construct by: STEVE HEDRICK Date 11-20-2008 Existing System Inspected by: Date:

YOU SHOULD CONTACT A LOCATOR SERVICE PRIOR TO ANY EXCAVATION.

WHITE COPY Environmental Health YELLOW COPY (Final) Owner / Applicant PINK COPY (Initial) Owner / Applicant