IREDELL COUNTY HEALTH DEPARTMENT

STATESVILLE 704-878-5305 @ MOORESVILLE 704-664-5281

IMPROVEMENT PERMIT / AUTHORIZATION TO CONSTRUCT / OPERATION PERMIT / EXISTING SYSTEM INSPECTION

PERMIT # 163400 PIN # 4749-54-1221 DATE 20 October 10

OWNER or APPLICANT Joel McDaniel PHONE: Business (843) 495-7880 Home:

OWNER or APPLICANT ADDRESS 1912 Old Marks-ville Rd Statesville, NC

LOCATION / DIRECTIONS 21 N TL Jennings Rd, TL Friendship Rd. TL Bussell Rd. 6th on Rt.

SUBDIVISION BLOCK / SECTION LOT # LOT AREA 3.9ac. DESIGN FLOW 360gpd L.T.A.R. 0.35/FFA

Septic Tank 1000 Gallons: STB 1012 Date 3-18-10
Pump Tank Gallons: P T Date
Pump Make Model Serial #
Nitrification Field No Fields 1 No Lines 3 Linear Feet 300
Trench Width 36" Max. Trench Bottom Depth 36" Gravel Depth NA

☑ New System ☐ Repair ☐ Expansion System Type I II III IV V VI
System Description: 25% Reduction
Repair System Description: 25% Reduction
Maintenance Agreement Required ☐ YES ☑ NO
☑ GRAVITY ☐ PRESSURE

☑ Residence No. Bedrooms 3
☐ Business No. Persons
☐ Other No. Employees
☐ Slab ☑ Crawl Space
☐ Basement w/plumbing ☐ Basement w/o plumbing


Water Supply: ☑ Private ☐ Public ☐ Community

Comments / Conditions

Comments / Conditions

Polylock Filter

INITIAL SITE SKETCH

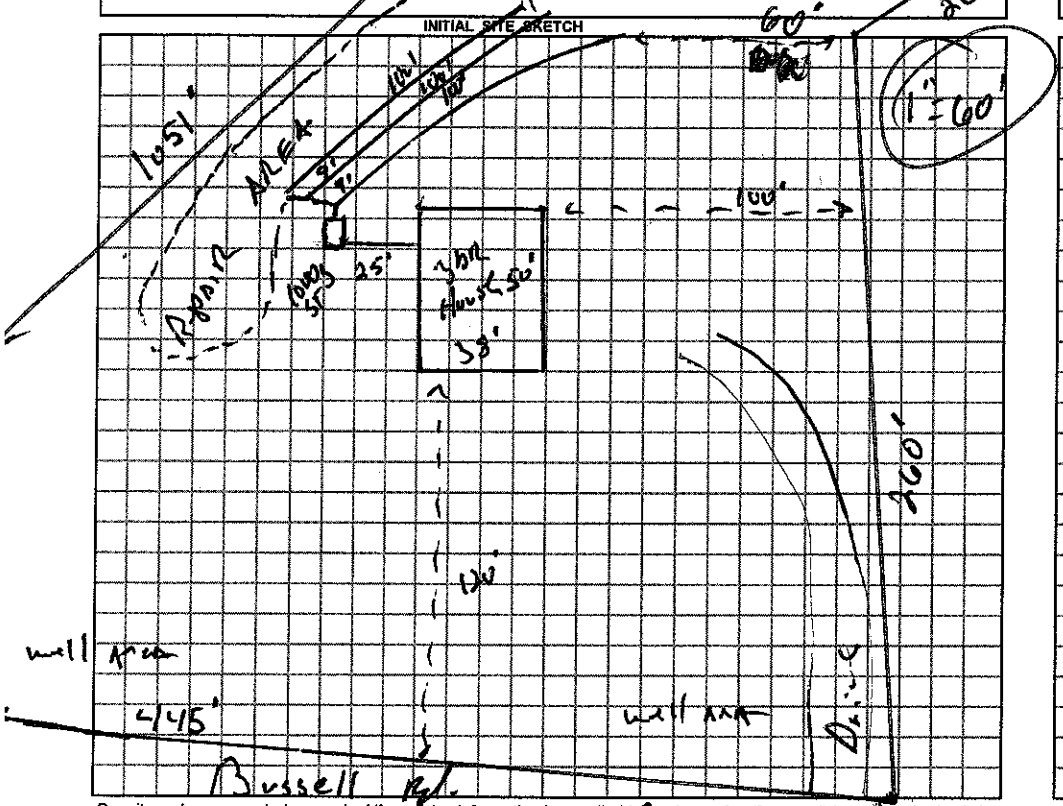

AS BUILT SKETCH

Installed as Drawn

Permit can be suspended or revoked if any false information is supplied toward securing the permit / any unauthorized changes are made to the site / any unauthorized changes are made in the installation of the system.

☐ *IMPROVEMENT PERMIT w / plat valid without expiration.* ☑ *IMPROVEMENT PERMIT w / site plan valid for 60 mos.* ☑ *AUTHORIZATION TO CONSTRUCT valid for period equal to IMPROVEMENT PERMIT-not to exceed 60 mo.*

Owner / Applicant Signature: Date 10-22-10

Improvement Permit by: R.S Date 20 Oct. 10

Authorzation to Construct by: R.S Date 20 Oct. 10

YOU SHOULD CONTACT A LOCATOR SERVICE PRIOR TO ANY EXCAVATION.

Installed by: Ground Breakers

Operation Permit by: R.S. Date: 29 Oct. 10

Existing System Inspected by: Date:

WHITE COPY Environmental Health YELLOW COPY (Final) Owner / Applicant PINK COPY (Initial) Owner / Applicant