IREDELL COUNTY HEALTH DEPARTMENT

STATESVILLE 704-878-5305 MOORESVILLE 704-664-5281

IMPROVEMENT PERMIT / AUTHORIZATION TO CONSTRUCT / OPERATION PERMIT / EXISTING SYSTEM INSPECTION

PERMIT # 160942 PIN # 4749543032 DATE 5-24-10

OWNER or APPLICANT KW Nicholson Inc - Stephen Skonie PHONE: Business 704-878-2517 Home:

OWNER or APPLICANT ADDRESS 930 Argyle Court

LOCATION / DIRECTIONS 132 Bussell Island Rd

SUBDIVISION n/a BLOCK / SECTION n/a LOT # LOT AREA 7.398 DESIGN FLOW 240 L.T.A.R. .3

Septic Tank 1000 Gallons: STB Ex Date Ex

Pump Tank Gallons: P T Date

Pump Make Model Serial #

Nitrification Field No Fields Ex No Lines Ex. Linear Feet Ex.

Trench Width Ex Max. Trench Bottom Depth Ex Gravel Depth Ex

☑ New System ☐ Repair ☐ Expansion System Type I II III IV V VI

System Description: 25% Gravity Reduction

Repair System Description: 25% Gravity Reduction

Maintenance Agreement Required ☐ YES ☑ NO

☑ GRAVITY ☐ PRESSURE

☑ Residence No. Bedrooms 2

☐ Business No. Persons

☐ Other No. Employees

☐ Slab ☑ Crawl Space

☐ Basement w/plumbing ☐ Basement w/o plumbing

Water Supply: ☐ Private ☑ Public ☐ Community


Comments / Conditions

Comments / Conditions

1" = 120

INITIAL SITE SKETCH

AS BUILT SKETCH

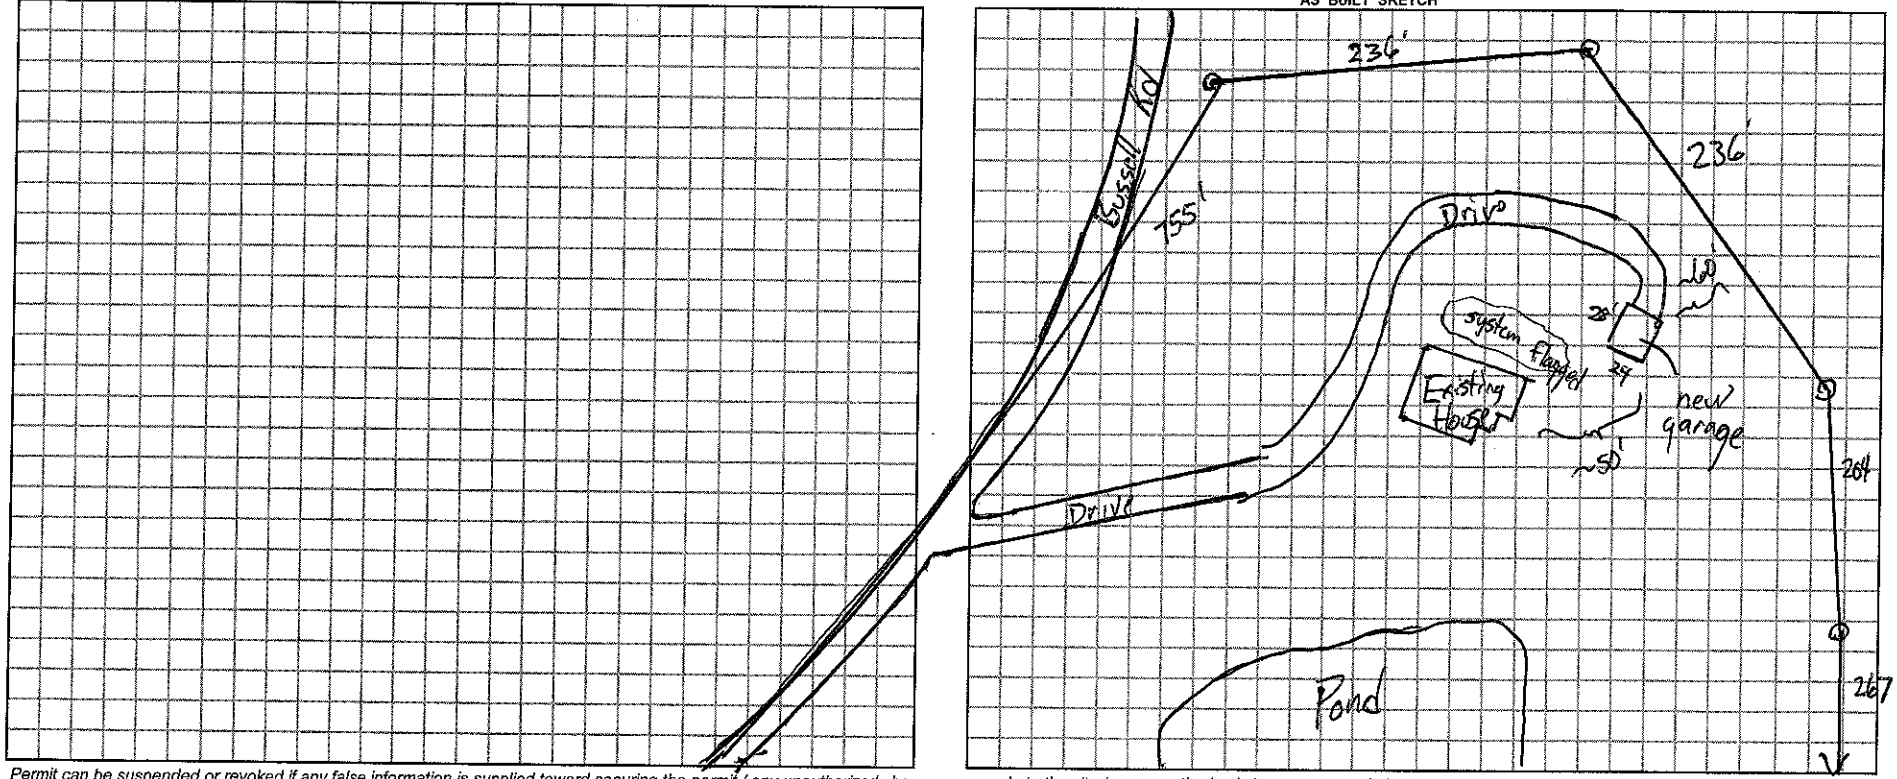

Permit can be suspended or revoked if any false information is supplied toward securing the permit / any unauthorized changes are made to the site / any unauthorized changes are made in the installation of the system.

☐ *IMPROVEMENT PERMIT w / plat valid without expiration.* ☐ *IMPROVEMENT PERMIT w / site plan valid for 60 mos.* ☐ *AUTHORIZATION TO CONSTRUCT valid for period equal to IMPROVEMENT PERMIT-not to exceed 60 mo.*

Owner / Applicant Signature: [signature] Date 5-24-10

Improvement Permit by: Date

Authorzation to Construct by: Date

YOU SHOULD CONTACT A LOCATOR SERVICE PRIOR TO ANY EXCAVATION.

Installed by:

Operation Permit by: Date:

Existing System Inspected by: [signature] Date: 5-24-10

WHITE COPY Environmental Health YELLOW COPY (Final) Owner / Applicant PINK COPY (Initial) Owner / Applicant