IREDELL COUNTY HEALTH DEPARTMENT - *ENVIRONMENTAL HEALTH* ☒ STATESVILLE OFFICE 704-878-5305 ☐ MOORESVILLE OFFICE 704-664-5281

IMPROVEMENT PERMIT / AUTHORIZATION TO CONSTRUCT / OPERATION PERMIT / EXISTING SYSTEM INSPECTION

PERMIT # 167485 PIN # 4749549424 8015 DATE 7-19-11

OWNER Troy & Deana Miller APPLICANT: PHONE: Home/Cell # 704 883 4648 Business #

SITE ADDRESS 167 Friendship Road OWNER / APPLICANT ADDRESS

SITE DIRECTIONS North on Jennings, (L) on Friendship, on right past 148 Friendship

SUBDIVISION none BLOCK / SECTION none LOT # n/a LOT AREA .914 ac DESIGN FLOW 360 L.T.A.R. .3

Septic Tank 1000 Gallons: STB 354 Date 6-8-11 ☒ New System ☐ Repair ☐ Expansion System Type I II (III) IV V VI

Pump Tank Gallons: P T Date System Description: 25% Reduction Gravity

Pump Make Model Serial # Repair System Description: 25% Reduction Gravity

No. Nitrification Fields: 1 No. Lines 3 Linear Feet 300 Total Maintenance Agreement Required ☐ YES ☒ NO

Trench Width 36" Max. Trench Bottom Depth 36" Gravel Depth n/a ☒ GRAVITY ☐ PRESSURE


☒ Residence No. Bedrooms 3 ☐ Business No. Persons ☐ Other No. Employees ☐ Slab ☒ Crawl Space ☐ Basement w/plumbing ☐ Basement w/o plumbing

Water Supply: ☐ Private ☒ Public ☐ Community


Comments / Conditions

1" = 50'

INITIAL SITE SKETCH

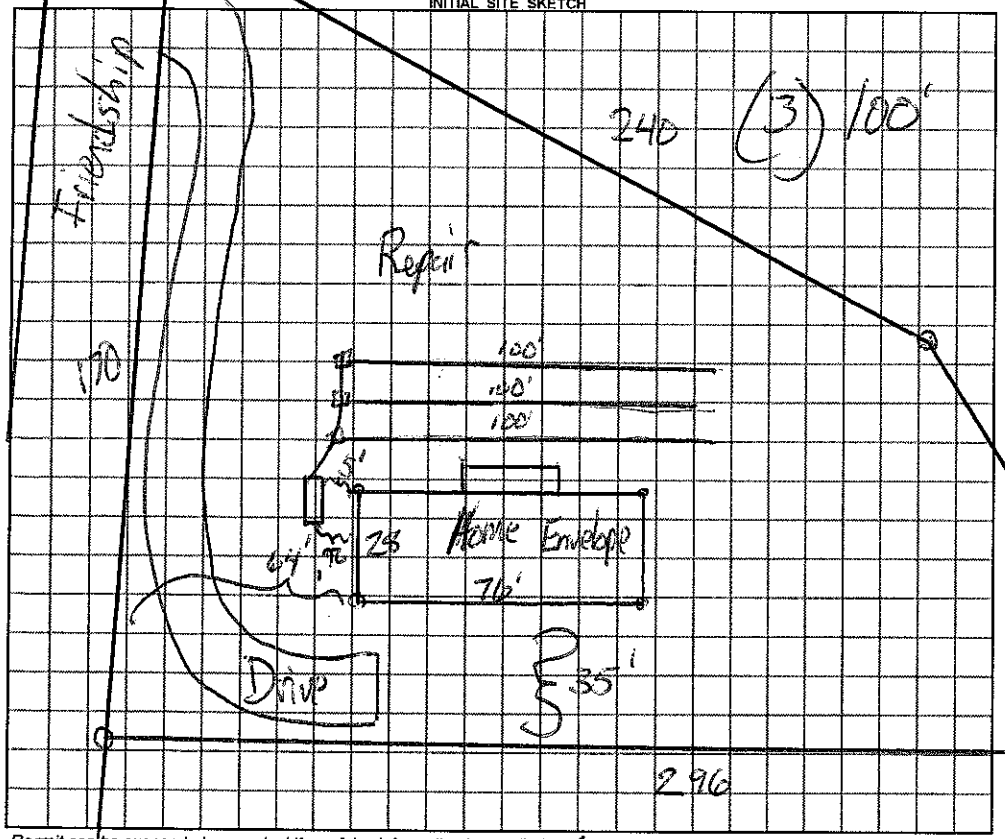

AS BUILT SKETCH

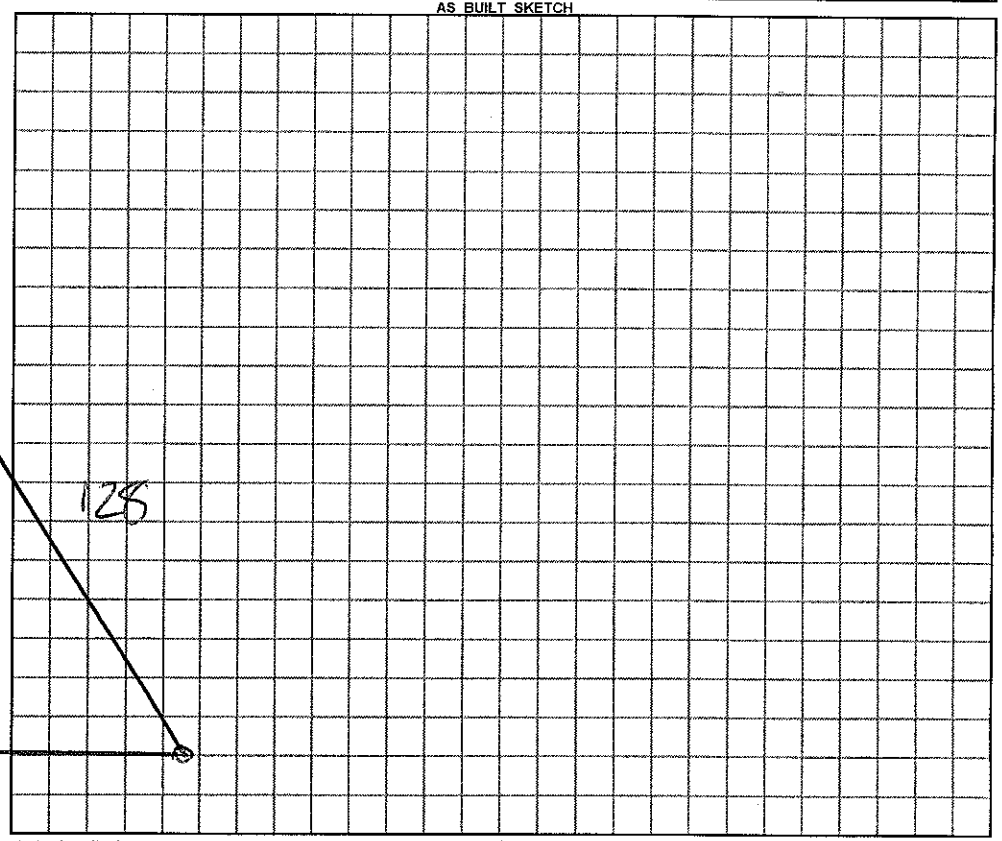

Permit can be suspended or revoked if any false information is supplied toward securing the permit / any unauthorized changes are made to the site / any unauthorized changes are made in the installation of the system.

☐ ***IMPROVEMENT PERMIT*** with plat valid without expiration. ☒ ***IMPROVEMENT PERMIT*** with plat valid without expiration, site plan valid 60 mo. ☒ ***AUTHORIZATION TO CONSTRUCT***, valid for period equal to IMPROVEMENT PERMIT--not to exceed 60 mo.

Owner / Applicant Signature: Troy Miller Date 7-20-11 Installed by: Jerry Carpenter

IMPROVEMENT PERMIT by: REHS Date 7-19-11 OPERATION PERMIT by: REHS Date 9-16-11

AUTHORIZATION TO CONSTRUCT by: REHS Date 7-19-11 Existing System Inspected by: REHS Date

YOU SHOULD CONTACT A LOCATOR SERVICE PRIOR TO ANY EXCAVATION

White Copy -- Environmental Health YELLOW COPY (Final) Owner / Applicant PINK COPY (Initial) Owner / Applicant