IREDELL COUNTY HEALTH DEPARTMENT

STATESVILLE 704-878-5305 MOORESVILLE 704-664-5281

IMPROVEMENT PERMIT / AUTHORIZATION TO CONSTRUCT / OPERATION PERMIT / EXISTING SYSTEM INSPECTION

PERMIT# 091401 PIN# 4749 58 5858 DATE 8-19-00

OWNER OR CONTRACTOR A-1 MOBILE HOMES PHONE: Business 873-1019 Home

ADDRESS 590 MOCKSVILLE HWY STATESVILLE NC 28625

LOCATION US 21 N, TL JENNINGS RD, TL RAIDER RD, TR CON-LEE DR, 3RD LOT ON LEFT PAST CURVE

SUBDIVISION CON-LEE HEIGHTS BLOCK / SECTION LOT 23 LOT AREA 100' x 200' SITE CLASS PS DESIGN FLOW 360 L.T.A.R. 0.30 GPD/FT²

Septic Tank: 1000 Gallons; STB 620 Date 1-5-01
Pump Tank: Gallons; PT Date
Pump Make: Model Serial No.
Nitrification Field: No Fields 1 Square Feet 1200 Linear Feet 400
No Lines RUE Trench Width 36" Max Trench Bottom Depth 36" Gravel Depth 12"

☒ New System ☐ Repair System Type: I (II) III IV V VI
System Description: CONVENTIONAL GRAVITY
Repair System Description: 50% REDUCTION PUMP
Maintenance Agreement Required: ☐ Yes ☒ No


☐ House/Mod. Home ☒ Mobile Home ☐ Business ☐ Other
No. Bedrooms 3 No. Bathrooms 2 No. Employees
☐ Slab ☒ Crawl Space ☐ Basement w/plumbing ☐ Basement wo/plumbing

Water Supply: ☐ Individual ☒ Public ☐ Community


Comments/Conditions:

Comments/Conditions: ① SEPTIC TANK W/ RISERS INSTALLED USING "TUFTITE" FILTER ② SYSTEM INSTALLED OUT OF CONTOUR AS SHOWN ③ SYSTEM INSTALLED DURING PERIOD OF SOIL WETNESS

INITIAL SITE SKETCH SCALE: 1" = 40'

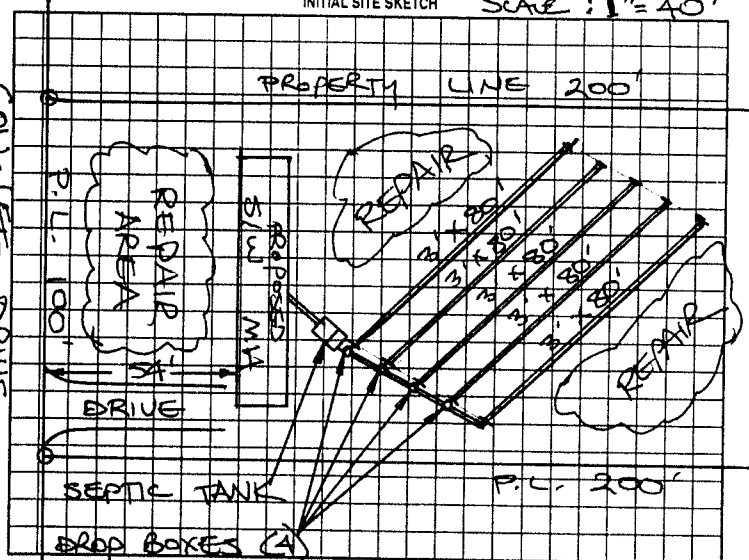

AS BUILT SKETCH

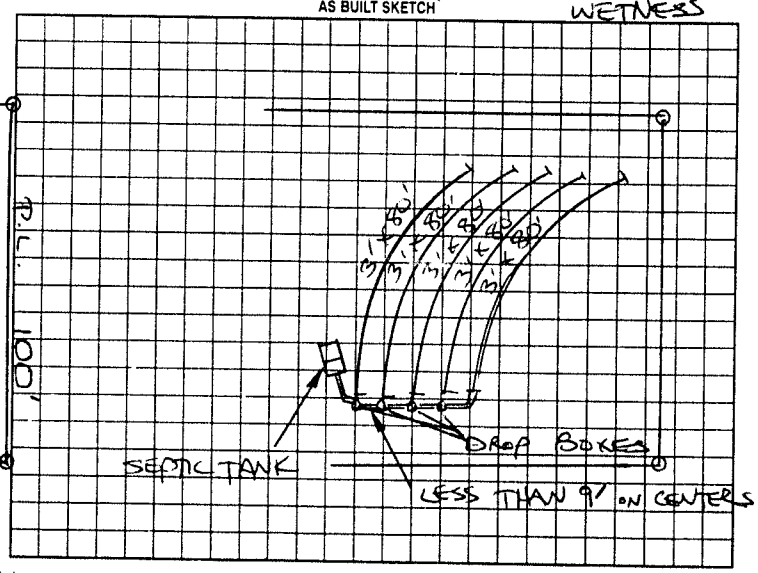

Permit can be suspended or revoked if any false information is supplied toward securing the permit/any unauthorized changes are made to the site/any unauthorized changes are made in the installation of the system. Improvement Permit with plat valid without expiration. Improvement Permit with site plan valid for sixty months. Authorization to Construct is valid for a period equal to that of Improvement Permit – not to exceed sixty months.

Signed: Roger Templeton date 8-19-00 Installed by: SAMMY REAVIS

Improvement Permit by: STEVE HEDRICK date 8-19-00 Operation Permit by: STEVE HEDRICK date 2-27-01

Authorization to Construct by: STEVE HEDRICK date 8-19-00 Existing System Inspection by: date

HEALTH DEPT COPY: WHITE OWNER COPY (FINAL): YELLOW OWNER COPY (INITIAL): PINK