IREDELL COUNTY HEALTH DEPARTMENT

STATESVILLE 704-878-5305 (C1) MOORESVILLE 704-664-5281

IMPROVEMENT PERMIT / AUTHORIZATION TO CONSTRUCT / OPERATION PERMIT / EXISTING SYSTEM INSPECTION

PERMIT# 103966 PIN# 4749-59-8148 DATE 1-14-02

OWNER OR CONTRACTOR A-1 MOBILE HOMES PHONE. Business (704) 873-1014 Home

ADDRESS 590 MOCKSVILLE HWY, STATESVILLE, NC 28625

LOCATION US 21 N, TL JENNINGS RD, TL RAIDER RD, TR CON-LEE DRIVE, LOT AT CURVE ON RIGHT

SUBDIVISION CON-LEE-HEIGHTS BLOCK / SECTION LOT 160 LOT AREA 0.59 ACRE SITE CLASS. PS DESIGN FLOW 360 L.T.A.R. 0.30 GPD/FT²

Septic Tank: 1000 Gallons. STB 1012 Date 9-17-01
Pump Tank: Gallons. PT Date
Pump Make: Model Serial No
Nitrification Field: No Fields 1 Square Feet 69, @ 1200 Linear Feet 300
No Lines SIX Trench Width 36" Max Trench Bottom Depth 36" Gravel Depth N/A

☑ New System ☐ Repair System Type I. II (III) IV. V. VI
System Description: 25% REDUCTION, GRAVITY
Repair System Description: 50% REDUCTION, LOW PRESSURE
Maintenance Agreement Required: ☐ Yes ☑ No Other

☐ House/Mod. Home ☑ Mobile Home ☐ Business
No. Bedrooms 3 No. Bathrooms 2 No. Employees


Water Supply: ☐ Individual ☒ Public ☐ Community

☐ Slab ☑ Crawl Space ☐ Basement w/plumbing ☐ Basement wo/plumbing


Comments /Conditions ① CONTACT HEALTH DEPARTMENT AFTER CLEARING & PRIOR TO INSTALLATION TO FLAG-OUT SYSTEM ② INSTALL 25% REDUCTION SYSTEM USING THIRTY HDS SECTIONS (AT REQUEST)

Comments /Conditions SEPTIC TANK WITH MARKER INSTALLED USING "POLY LOK" FILTER

INITIAL SITE SKETCH

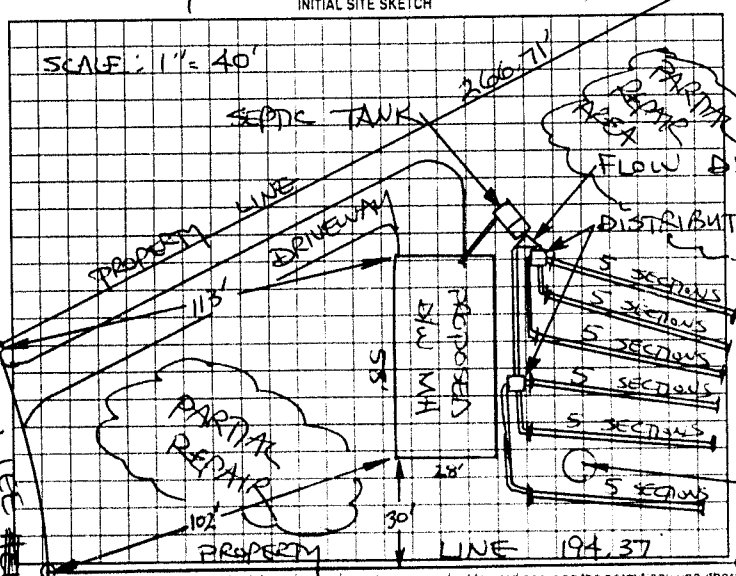

AS BUILT SKETCH

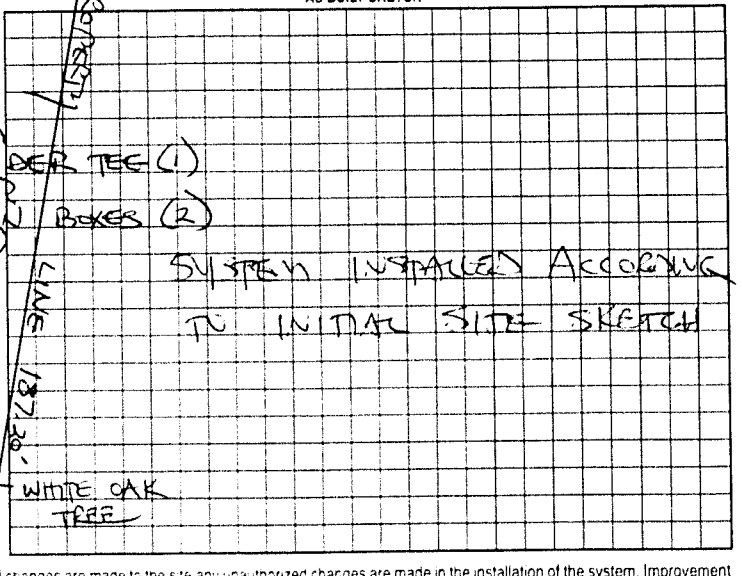

Permit can be suspended or revoked if any false information is supplied toward securing the permit any unauthorized changes are made to the site any unauthorized changes are made in the installation of the system. Improvement Permit with plat valid without expiration. Improvement Permit with site plan valid for sixty months. Authorization to Construct is valid for a period equal to that of Improvement Permit - not to exceed sixty months.

Signed [signature] date 1-15-02 Installed by MITCHELL GRADING

Improvement Permit by: STEVE HEDRICK date 1-14-02 Operation Permit by STEVE HEDRICK date 3-7-02

Authorization to Construct by: STEVE HEDRICK date 1-14-02 Existing System Inspection by date

HEALTH DEPT COPY WHITE OWNER COPY (FINAL) YELLOW OWNER COPY (INITIAL) PINK