IREDELL COUNTY HEALTH DEPARTMENT

STATESVILLE 704-878-5305 MOORESVILLE 704-664-5281

IMPROVEMENT PERMIT / AUTHORIZATION TO CONSTRUCT / OPERATION PERMIT / EXISTING SYSTEM INSPECTION

PERMIT# 078851 PIN# 4749 63 3965 (PT) DATE 1-25-99

OWNER OR CONTRACTOR DAVID GAGNON PHONE: Business Home 876-0116

ADDRESS 1409 JENNINGS ROAD, STATESVILLE, NC 28625

LOCATION US 21 NORTH, TL JENNINGS ROAD, ON LEFT JUST PAST BOX # 1409

SUBDIVISION BLOCK / SECTION LOT LOT AREA 11.6 ACRES SITE CLASS FS DESIGN FLOW 360 L.T.A.R. 0.33 GPD/FT²

Septic Tank: 1000 Gallons; STB 1012 Date 11-28-98

Pump Tank: Gallons; PT Date

Pump Make: Model Serial No.

Nitrification Field: No Fields 1 Square Feet 1080 Linear Feet 360

No Lines FOUR Trench Width 36" Max Trench Bottom Depth 36" Gravel Depth 12"

☑ New System ☐ Repair System Type: I II III IV V VI

System Description: CONVENTIONAL GRAVITY

Repair System Description: CONV. GRAVITY

Maintenance Agreement Required: ☐ Yes ☑ No

☐ House/Mod. Home ☑ Mobile Home ☐ Business ☐ Other FUTURE 3BR HOUSE

No. Bedrooms 3 No. Bathrooms 2 No. Employees

☐ Slab ☐ Crawl Space ☐ Basement w/plumbing ☐ Basement wo/plumbing


Water Supply: ☐ Individual ☑ Public ☐ Community

Comments/Conditions: S/W MH TO BE REMOVED UPON OCCUPANCY OF HOUSE


Comments/Conditions: "POLY GR" FILTER INSTALLED AT OUTLET OF SEPTIC TANK

SCALE: 1" = 40'

INITIAL SITE SKETCH

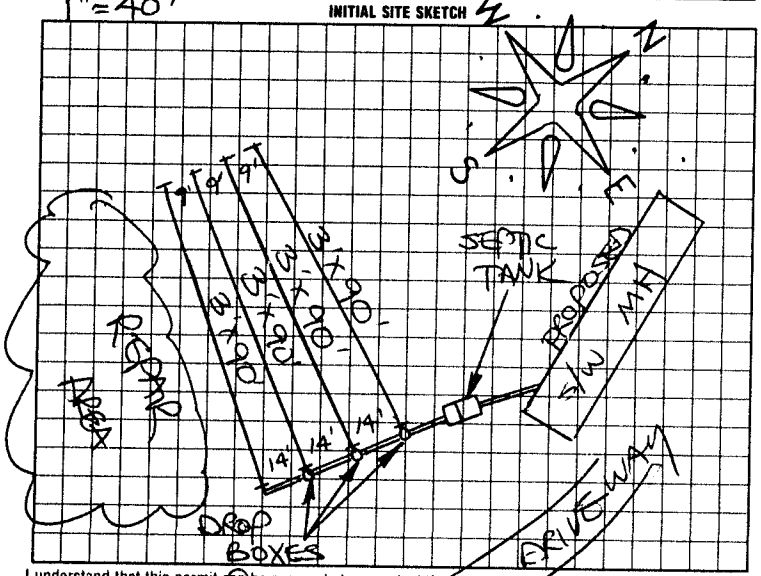

AS BUILT SKETCH

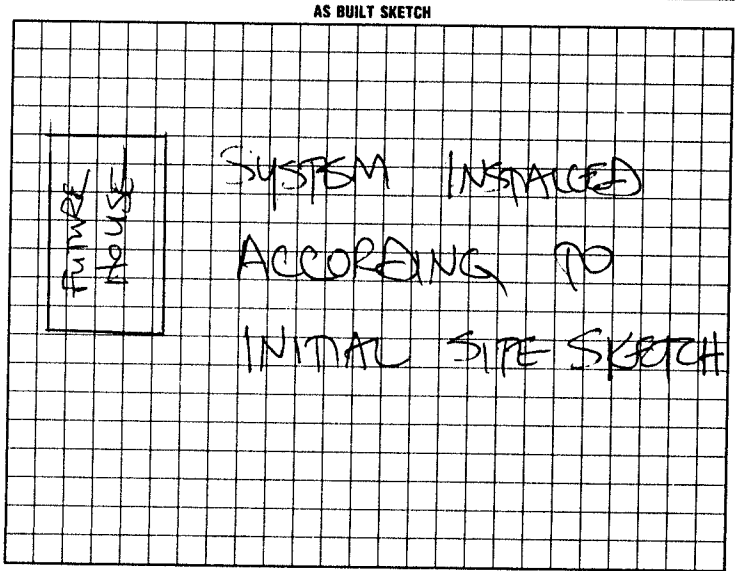

I understand that this permit can be suspended or revoked if any false information is supplied toward securing the permit/any unauthorized changes are made to the site/any unauthorized changes are made in the installation of the system. Improvement Permit with plat valid without expiration. Improvement Permit with site plan valid for sixty months. Authorization to Construct is valid for a period equal to that of Improvement Permit – not to exceed sixty months.

Signed: David Gagnon

Improvement Permit by: STEVE HEDRICK date 1-25-99

Authorization to Construct by: STEVE HEDRICK date 1-25-99

Installed by: DALE FOX

Operation Permit by: STEVE HEDRICK date 2-8-99

Existing System Inspection by: date

HEALTH DEPT. COPY: WHITE INSPECTION COPY (FINAL): GREEN OWNER COPY (FINAL): YELLOW INSPECTION COPY (INITIAL): PINK OWNER COPY (INITIAL): GOLD