IREDELL COUNTY HEALTH DEPARTMENT

STATESVILLE 704-878-5305 CJ MOORESVILLE 704-664-5281

IMPROVEMENT PERMIT / AUTHORIZATION TO CONSTRUCT / OPERATION PERMIT / EXISTING SYSTEM INSPECTION

PERMIT# 126009 PIN# 4749-69-0973 DATE 2-21-05

OWNER OR CONTRACTOR REMAX PROPERTIES PLUS INC (SUSAN RAWLS) PHONE: Business (704) 437-1611 Home

ADDRESS 303 N. CENTER ST. STATESVILLE NC 28677

LOCATION I-77N TL TOMLIN MILLRD (EXIT 59) TL JENNINGS TR FRIENDSHIP TR BRADFORD 2ND LOT ON LEFT

SUBDIVISION BRADFORD ACRES BLOCK / SECTION LOT 2 LOT AREA 1.05 SITE CLASS PS DESIGN FLOW 360 L.T.A.R. 0.30 gpd/ft²

Septic Tank: 1000 Gallons; STB 1007 Date 3-15-05
Pump Tank: Gallons; PT Date
Pump Make: Model Serial No.
Nitrification Field: No Fields 1 Square Feet 1200 Linear Feet 300
No Lines 4 Trench Width 36" Max Trench Bottom Depth 24" Gravel Depth N/A

☑ New System ☐ Repair System Type: I, II, (III), IV, V, VI
System Description: GRAVITY 25% REDUCTION
Repair System Description: LP PANEL 50% REDUCTION
Maintenance Agreement Required: ☐ Yes ☑ No


☑ House/Mod. Home No. Bedrooms 3
☐ Mobile Home No. Bathrooms
☐ Business No. Employees
☐ Other
☐ Slab ☑ Crawl Space ☐ Basement w/plumbing ☐ Basement wo/plumbing

Water Supply: ☑ Individual ☑ Public ☐ Community


Comments:/Conditions: ① INSTALL LINES 24" ON CONTOUR ② INSTALL SUBSURFACE INTERCEPTOR DRAIN 36" TO DAYLIGHT ③ MAINTAIN ALL SETBACKS

Comments:/Conditions: * COUNTY WATER AVAILABLE TO LOT
7ABEL FILTER SMARTRAIN
BUILDER APPROVED CHANGES

INITIAL SITE SKETCH

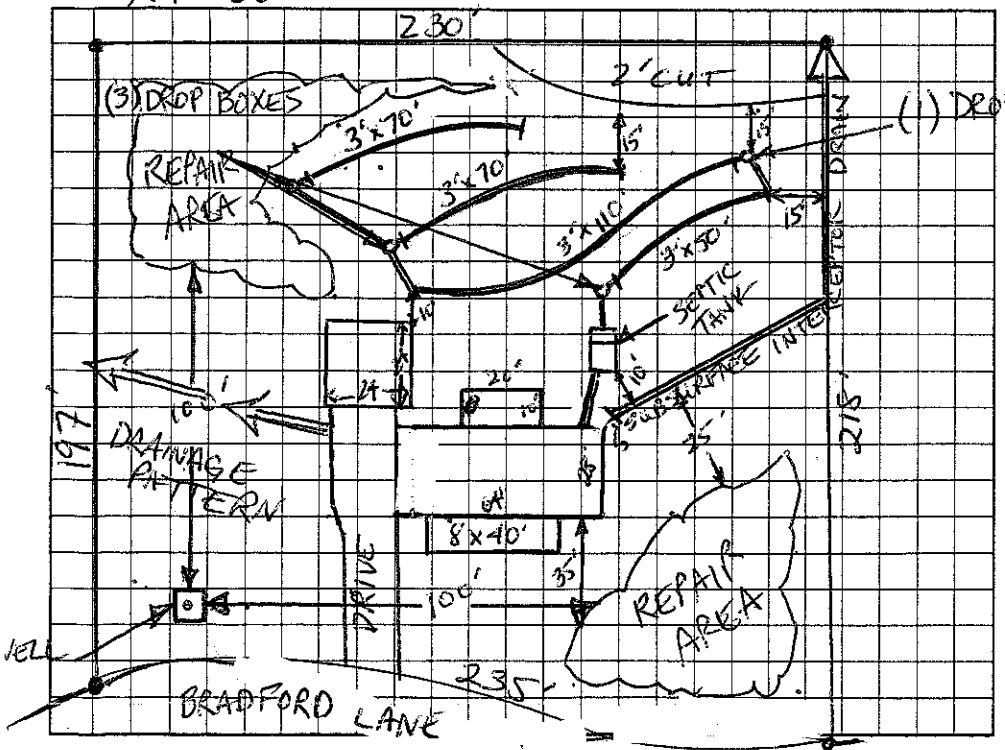

AS BUILT SKETCH

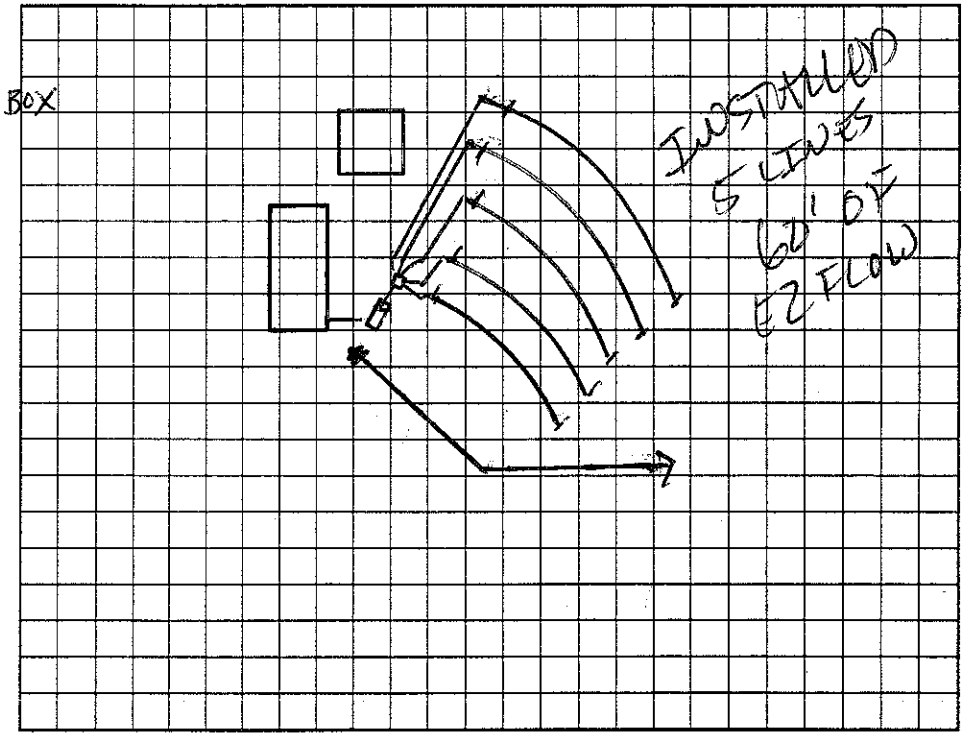

Permit can be suspended or revoked if any false information is supplied toward securing the permit/any unauthorized changes are made to the site/any unauthorized changes are made in the installation of the system. Improvement Permit with plat valid without expiration. Improvement Permit with site plan valid for sixty months. Authorization to Construct is valid for a period equal to that of Improvement Permit – not to exceed sixty months.

Signed: date 3.7.05 Installed by: JAMES HUDDLE

Improvement Permit by: Christopher M. Sherrill REHS/CSS date 2-21-05 Operation Permit by: date 5-11-05

Authorization to Construct by: Christopher M. Sherrill REHS/CSS date 2-21-05 Existing System Inspection by: date

HEALTH DEPT. COPY: WHITE OWNER COPY (FINAL): YELLOW OWNER COPY (INITIAL): PINK