IREDELL COUNTY HEALTH DEPARTMENT

STATESVILLE 704-878-5305 MOORESVILLE 704-664-5281

IMPROVEMENT PERMIT / AUTHORIZATION TO CONSTRUCT / OPERATION PERMIT / EXISTING SYSTEM INSPECTION

PERMIT# 081799 PIN# 4749 64 7960 DATE 6-18-99

OWNER OR CONTRACTOR PAUL BONHAM PHONE: Business 521-8777 Home 489-1381

ADDRESS 7310 RIGHT ANGLE STREET, SHERRILLS FORD, NC 28673

LOCATION US 21 N, TL JENNINGS ROAD, TL FRIENDSHIP RD, TR BRADFORD LANE, LOT AT END ON LEFT

SUBDIVISION BRADFORD ACRES BLOCK / SECTION ____ LOT 5 LOT AREA 1.650 ACRES SITE CLASS PS DESIGN FLOW 480 L.T.A.R. 0.35 GPD/FT²

Septic Tank: 1000 Gallons: STB 1012 Date 8-8-99

Pump Tank: 1000 Gallons: P.T. 17 Date ____

Pump Make: HYDROMATIC Model SHEDDAIR Serial No. ____

Nitrification Field: No Fields 1 Square Feet 1380 Linear Feet 345

No Lines FIVE Trench Width 36" Max Trench Bottom Depth 36" Gravel Depth SAND 6"

☑ New System ☐ Repair System Type: I. II. III. IV. V. VI

System Description: 25% REDUCTION, PUMP

Repair System Description: 50% REDUCTION PUMP

Maintenance Agreement Required: ☐ Yes ☑ No

☑ House/Mod. Home ☐ Mobile Home ☐ Business ☐ Other

No. Bedrooms 4 No. Bathrooms 4 No. Employees ____


☐ Slab ☐ Crawl Space ☐ Basement w/plumbing ☐ Basement wo/plumbing

Water Supply: ☐ Individual ☑ Public ☐ Community


Comments/Conditions: ① INSTALL 25% REDUCTION SYSTEM USING FIFTY-FIVE (55) CHAMBERS OR THIRTY FIVE (35) HDS SECTIONS ② SEE ATTACHED SHEETS FOR PUMP AND PRESSURE MANIFOLD REQUIREMENTS

Comments/Conditions: TANKS & LINES INSPECTED 10-26 PRESSURE SET 10-26

INITIAL SITE SKETCH

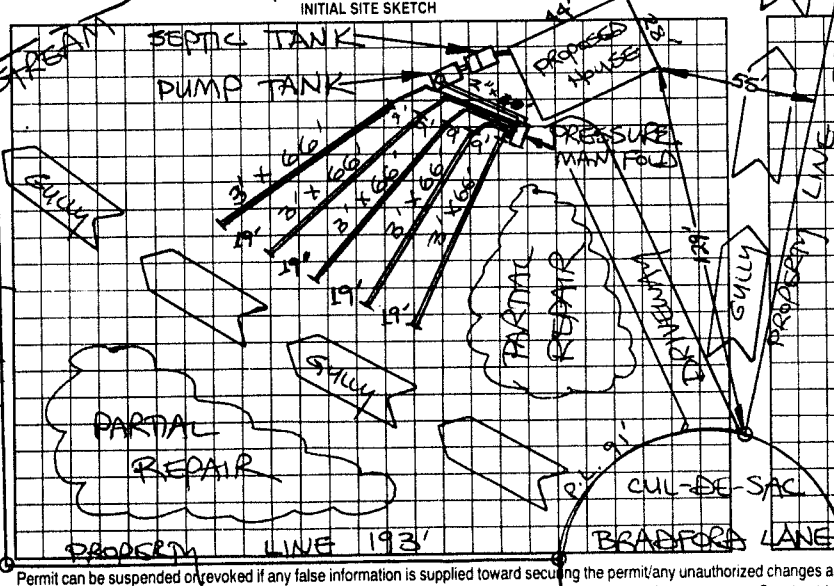

AS BUILT SKETCH

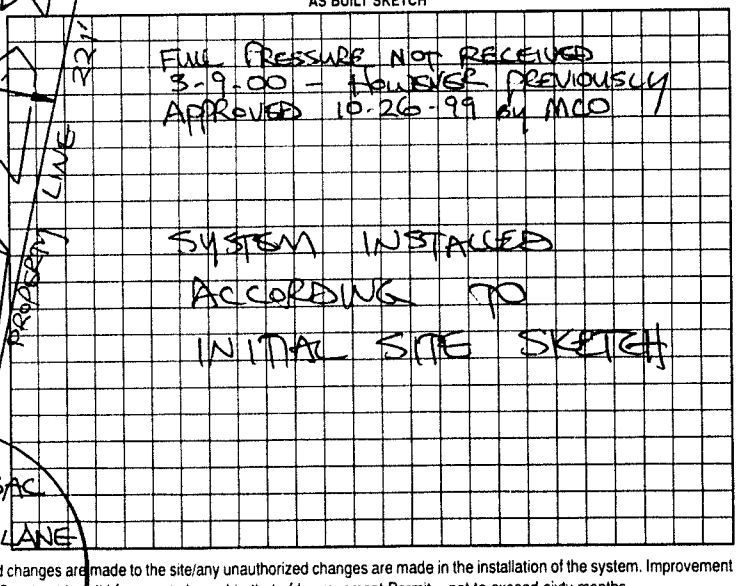

Permit can be suspended or revoked if any false information is supplied toward securing the permit/any unauthorized changes are made to the site/any unauthorized changes are made in the installation of the system. Improvement Permit with plat valid without expiration. Improvement Permit with site plan valid for sixty months. Authorization to Construct is valid for a period equal to that of Improvement Permit – not to exceed sixty months.

Signed: Paul W. Bonham date 6-18-99 Installed by C & W Grading

Improvement Permit by: STEVE HEDRICK date 6-18-99 Operation Permit by: STEVE HEDRICK date 3-9-00

Authorization to Construct by: STEVE HEDRICK date 6-18-99 Existing System Inspection by: ____ date ____

HEALTH DEPT COPY: WHITE | OWNER COPY (FINAL): YELLOW | OWNER COPY (INITIAL): PINK