IREDELL COUNTY HEALTH DEPARTMENT

STATESVILLE 704-878-5305 MOORESVILLE 704-664-5281 (CI)

IMPROVEMENT PERMIT / AUTHORIZATION TO CONSTRUCT / OPERATION PERMIT / EXISTING SYSTEM INSPECTION

PERMIT# 105930 PIN# 4749-65-3725 DATE 4-30-02

OWNER OR CONTRACTOR JEFFERY & BELINDA KING PHONE: Business _____ Home 704-876-3410

ADDRESS 123 SERENITY LANE, STATESVILLE, NC 28625

LOCATION US 21 N, TL JENNINGS RD, TL FRIENDSHIP ROAD, TR SERENITY LANE, 2ND DRIVE ON LEFT

SUBDIVISION _____ BLOCK / SECTION _____ LOT _____ LOT AREA 1.0 ACRE SITE CLASS PS DESIGN FLOW 360 L.T.A.R. EXISTING

Septic Tank: 1000 Gallons: STB _____ Date _____

Pump Tank: _____ Gallons: PT _____ Date _____

Pump Make: _____ Model _____ Serial No _____

Nitrification Field: No Fields 1 Square Feet _____ Linear Feet EXISTING

No Lines TWO Trench Width _____ Max Trench Bottom Depth _____

☐ New System ☐ Repair System Type: (I) II, IV, V, VI

System Description: CONVENTIONAL, GRAVITY

Repair System Description: _____

Maintenance Agreement Required: ☐ Yes ☑ No

☐ Slab ☑ Crawl Space ☐ Basement w/plumbing ☐ Basement wo/plumbing

☐ House/Mod. Home ☑ Mobile Home ☐ Business ☐ Other _____

No. Bedrooms 3 No. Bathrooms 2 No. Employees ____

Water Supply: ☑ Individual ☐ Public ☐ Community

WELL


Comments/Conditions:

Comments/Conditions SYSTEM UNDERSIZED ACCORDING TO TODAY'S STANDARDS

INITIAL SITE SKETCH

AS BUILT SKETCH

~ SCALE: 1"=60'

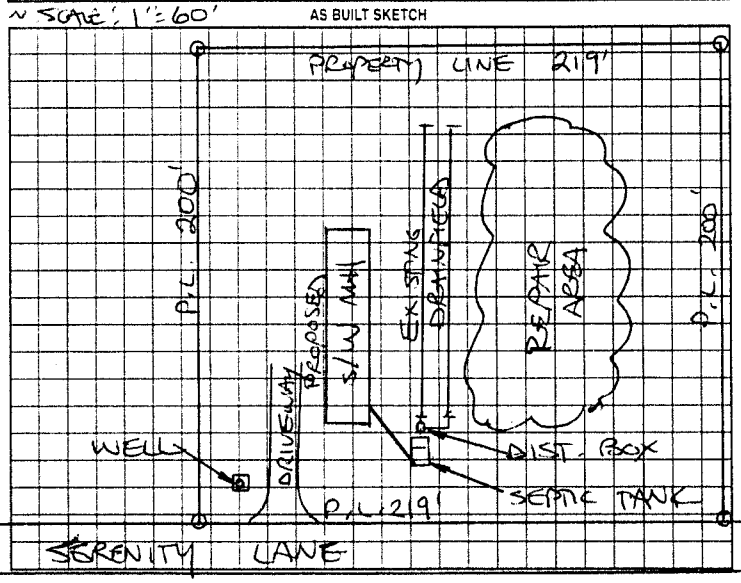

Permit can be suspended or revoked if any false information is supplied toward securing the permit/any unauthorized changes are made to the site any unauthorized changes are made in the installation of the system. Improvement Permit with plat valid without expiration. Improvement Permit with site plan valid for sixty months. Authorization to Construct is valid for a period equal to that of Improvement Permit – not to exceed sixty months.

Signed: _____ date _____ Installed by: _____

Improvement Permit by: _____ date _____ Operation Permit by: _____ date _____

Authorization to Construct by: _____ date _____ Existing System Inspection by: STEVE HEDRICK date 4-30-02

HEALTH DEPT. COPY WHITE OWNER COPY (FINAL) YELLOW OWNER COPY (INITIAL) PINK

