IREDELL COUNTY HEALTH DEPARTMENT

STATESVILLE 704-878-5305 MOORESVILLE 704-664-5281

IMPROVEMENT PERMIT / AUTHORIZATION TO CONSTRUCT / OPERATION PERMIT / EXISTING SYSTEM INSPECTION

PERMIT# 102166 PIN# 4749 68 0339 DATE 9-10-01

OWNER OR CONTRACTOR A-1 MOBILE HOMES PHONE: Business (704) 873-1014 Home

ADDRESS 590 MOCKSVILLE HWY STATESVILLE NC 28677

LOCATION US 21 N TL JENNINGS RD TL RAMER RD TR CON-LEE DR, LOT #8 ON RIGHT

SUBDIVISION CON-LEE HEIGHTS BLOCK / SECTION LOT 8 LOT AREA 100' x 200' SITE CLASS PS DESIGN FLOW 360 L.T.A.R. 0.30 GPD/FT²

Septic Tank: 1000 Gallons: STB 1012 Date 5-20-01
Pump Tank: Gallons: PT Date
Pump Make: Model Serial No
Nitrification Field: No Fields 1 Square Feet EQ. TO 1200 Linear Feet 300+
No Lines FIVE Trench Width 36" Max Trench Bottom Depth 36"

☑ New System ☐ Repair System Type: I. II. (III.) 25% RED.
System Description ~~25% REDUCTION~~ GRAVITY
Repair System Description: 50% REDUCTION, PUMP
Maintenance Agreement Required: ☐ Yes ☐ No

☐ House/Mod. Home ☑ Mobile Home ☐ Business ☐ Other
No. Bedrooms 3 No. Bathrooms 2 No. Employees


☐ Slab ☑ Crawl Space ☐ Basement w/plumbing ☐ Basement wo/plumbing

Water Supply: ☐ Individual ☑ Public ☐ Community

Comments/Conditions: INSTALL 25% REDUCTION ~~SYSTEM~~ USING THIRTY (30) HDS SECTIONS, OR 50 CHAMBERS UTILIZING CONTOUR WEDGES


Comments/Conditions: SYSTEM ALTERED AS SHOWN BELOW WITHOUT PRIOR HEALTH DEPARTMENT APPROVAL, LINES INSTALLED OUT OF CONTOUR, (2) SEPTIC TANK W/ MARKER

INITIAL SITE SKETCH SCALE 1" = 40'

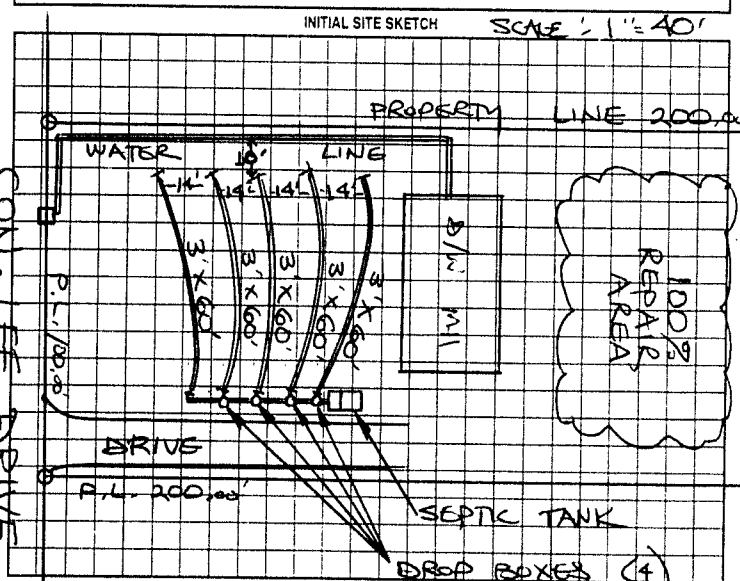

AS BUILT SKETCH

INSTALLED USING "POLYLOK" FILTER
(3) SYSTEM INSTALLED USING 30 HDS SECTIONS

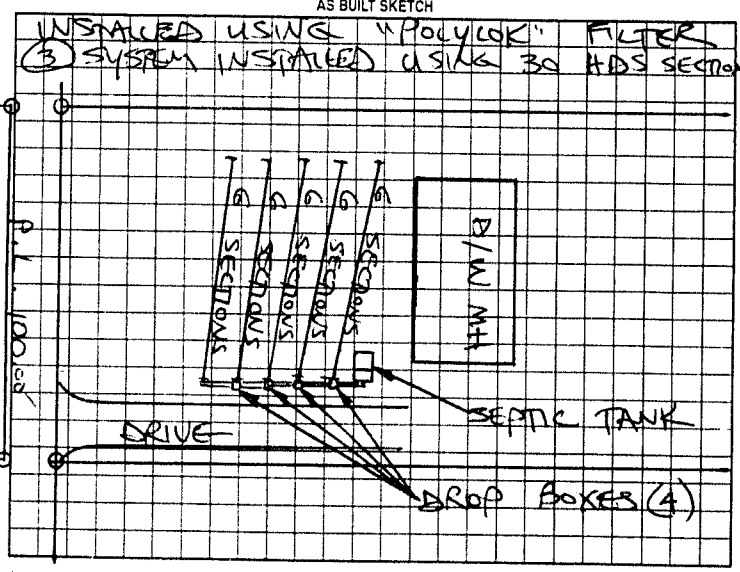

Permit can be suspended or revoked if any false information is supplied toward securing the permit/any unauthorized changes are made to the site/any unauthorized changes are made in the installation of the system. Improvement Permit with plat valid without expiration. Improvement Permit with site plan valid for sixty months. Authorization to Construct is valid for a period equal to that of Improvement Permit – not to exceed sixty months.

Signed: [signature] date

Improvement Permit by: STEVE HEDRICK date 9-10-01

Authorization to Construct by: STEVE HEDRICK date 9-10-01

Installed by: MITCHEL HAULING & GRADING

Operation Permit by: STEVE HEDRICK date 9-12-01

Existing System Inspection by: date

HEALTH DEPT COPY WHITE OWNER COPY (FINAL) YELLOW OWNER COPY (INITIAL) PINK