IREDELL COUNTY HEALTH DEPARTMENT

STATESVILLE 704-878-5305 MOORESVILLE 704-664-5281

IMPROVEMENT PERMIT / AUTHORIZATION TO CONSTRUCT / OPERATION PERMIT / EXISTING SYSTEM INSPECTION

PERMIT# 150593 PIN# 4749680709 DATE 6-9-08

OWNER OR APPLICANT Freedom Homes PHONE: Business 704 872 0179 Home

ADDRESS 154 Con-Lee Dr

LOCATION Jennings Rd (L) on Raider Rd, (R) on Con-Lee Lot on (R)

SUBDIVISION Con-Lee Heights BLOCK / SECTION LOT 12 LOT AREA SITE CLASS. RS DESIGN FLOW 360 L.T.A.R. .3

Septic Tank: 100 Gallons; STB 900 Date 4-23-08

Pump Tank: Gallons; PT Date

Pump Make: Model Serial No.

Nitrification Field: No Fields 1 Square Feet 1200 Linear Feet 300

No Lines 5 Trench Width 36 Max Trench Bottom Depth 36 Gravel Depth

■ New System ☐ Repair ☐ Expansion System Type: I (II) III IV V VI

System Description: 25% Reduction Gravity

Repair System Description: 25% Reduction

Maintenance Agreement Required: ☐ Yes ☑ No

☐ House/Mod. Home ■ Mobile Home ☐ Business ☐ Other

No. Bedrooms 3 No. Persons No. Employees


Water Supply: ☐ Individual ■ Public ☐ Community

■ Gravity ☐ Pressure ☐ Slab ■ Crawl Space ☐ Basement w/plumbing ☐ Basement wo/plumbing


Comments/Conditions:

Comments/Conditions: Poly lock f:ll.

INITIAL SITE SKETCH

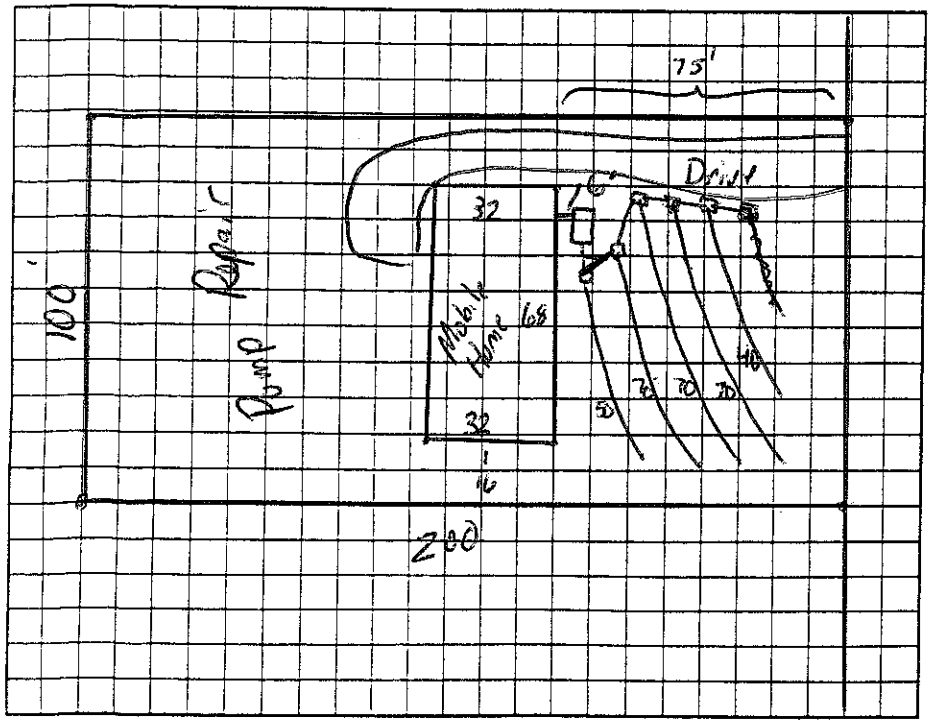

AS BUILT SKETCH

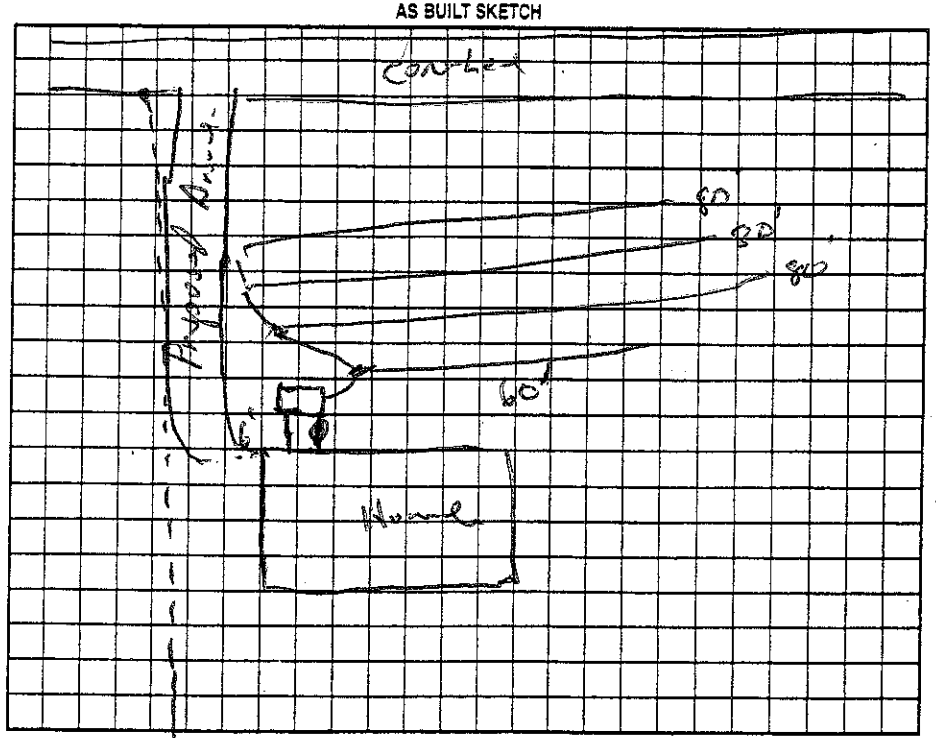

Permit can be suspended or revoked if any false information is supplied toward securing the permit/any unauthorized changes are made to the site/any unauthorized changes are made in the installation of the system. Improvement Permit with plat valid without expiration ☐ Improvement Permit with site plan valid for sixty months ■ Authorization to Construct is valid for a period equal to that of Improvement Permit – not to exceed sixty months.

Signed: Brenda Register date 6-10-08 Installed by: Tim Abee

Improvement Permit by: date 6-9-08 Operation Permit by: , R.S. date 15 Nov 2008

Authorization to Construct by: date 6-9-08 Existing System Inspection by: date

HEALTH DEPT. COPY: WHITE OWNER COPY (FINAL): YELLOW OWNER COPY (INITIAL): PINK