MW

ICHD - ENVIRONMENTAL HEALTH DIVISION

Statesville Office (704) 878-5305 Mooresville Office (704) 660-3625 PERMIT # AP 2022-4881

SEPTIC: IMPROVEMENT PERMIT / AUTHORIZATION TO CONSTRUCT / OPERATION PERMIT / EXISTING SYSTEM

PIN # 4749 -- 76 -- 7090

APPLICANT/OWNER: Thom Kincaid APPLICANT ADDRESS: 1567 Jennings Rd, Statesville

SITE ADDRESS: 1567 Jennings Rd, Statesville 28625 PHONE: 704-402-0942 ALT. PHONE -

SITE DIRECTIONS: 77 N - Tomlin Mill - Jennings SAP CONTROLLED: ☐ YES ☐ NO

SUBDIVISION: - SECTION: - LOT # - LOT AREA: 4.8 acres DESIGN FLOW: EX L.T.A.R.: EX

Septic Tank	1000	(gal)	STB	960	Date	10/1/22	☐ New System	☒ Repair	☐ Expansion
Pump Tank		(gal)	PT		Date		System Description:	-	
Pump Make			Model		Serial #		Repair System Description:	Tank Replacement	
# Nitrification Fields	EX		# Lines	EX	Linear Ft	EX	Maintenance Agreement Required:	☐ YES	☒ NO
Trench Width	EX		Trench Bottom Depth(Low side)		EX		Gravel Depth	-	☒ GRAVITY ☐ PRESSURE


System Type: I (II) III IV V VI

☒ Residence No. Bedrooms EX
☐ Business No. Persons EX
☐ Other No. Employees
☐ Slab ☒ Crawl Space
☐ Basement w/ plumbing ☐ Basement w/o plumbing

Water Supply: ☐ Private ☒ Public ☐ Community

Comments / Conditions: Pump, crush, & fill old septic tank. Replace distribution if necessary.

INITIAL SITE SKETCH

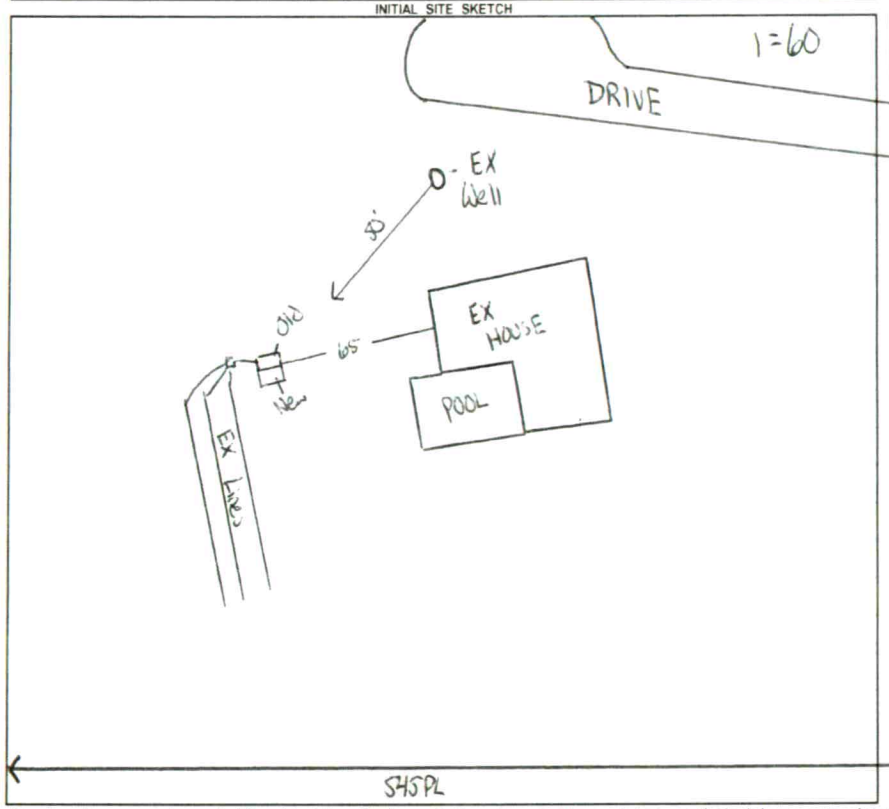

AS BUILT SKETCH

FOR SEPTIC FINAL INSPECTION CALL: 704-664-3703 between 8am-9am the day the inspection is needed. Be sure to speak with an inspector to confirm your time.

Installed as Drawn

Permit can be suspended or revoked if any false information is supplied toward securing the permit / any unauthorized changes are made to the site / any unauthorized changes are made in the installation of the system. **CONTACT A LOCATOR SERVICE PRIOR TO ANY EXCAVATION**

☐ **IMPROVEMENT PERMIT** ***with plat*** *valid without expiration.* ☒ **IMPROVEMENT PERMIT** ***with site plan*** *valid for 60 mos.* ☒ **AUTHORIZATION TO CONSTRUCT** *valid for period equal to IMPROVEMENT PERMIT--not to exceed 60 mo.*

Owner / Applicant Signature: Date: Installed by: Lentz

IMPROVEMENT PERMIT by: Cary Wil Date: 9/29/22 OPERATION PERMIT by: Cary Wil Date: 11/7/22

AUTHORIZATION TO CONSTRUCT by: Cary Wil Date: 9/29/22 Existing System Inspected by: Date:

FOR SEPTIC FINAL INSPECTION: CALL 704-664-3703 between 8am-9am the day the inspection is needed.