1:30 (1) This Permit Replaces previous permit issued on 6-21-05

IREDELL COUNTY HEALTH DEPARTMENT

STATESVILLE 704-878-5305 MOORESVILLE 704-664-5281

IMPROVEMENT PERMIT / AUTHORIZATION TO CONSTRUCT / OPERATION PERMIT / EXISTING SYSTEM INSPECTION

PERMIT# 127100 PIN# 4749-88-1836 ~~4749-88-1836~~ 985502 DATE 11-28-06

OWNER OR APPLICANT Tim Matthews PHONE: Business 704 501 2400 Home 704 391 2613

ADDRESS 1711 Jennings Rd

LOCATION

SUBDIVISION Raider Heights BLOCK / SECTION LOT 63 LOT AREA 12.21 SITE CLASS. PS DESIGN FLOW 600 L.T.A.R. .3

Septic Tank: 1500 Gallons; STB Date

Pump Tank: Gallons; PT Date

Pump Make: Model Serial No.

Nitrification Field: No Fields 1 Square Feet 2000 Linear Feet 667'

No Lines 6 Trench Width 36" Max Trench Bottom Depth 36" Gravel Depth 12"

☒ New System ☐ Repair ☐ Expansion System Type: I (II) III IV V VI

System Description: Conventional Gravity

Repair System Description: Conventional Gravity

Maintenance Agreement Required: ☐ Yes ☒ No

☒ House/Mod. Home ☐ Mobile Home ☐ Business ☐ Other

No. Bedrooms 5 No. Persons No. Employees


Water Supply: ☐ Individual ☒ Public ☐ Community

☒ Gravity ☐ Pressure ☐ Slab ☐ Crawl Space ☐ Basement w/plumbing ☐ Basement wo/plumbing


Comments:/Conditions: L_1=200 L_2=200 L_3=115 L_4=115 L_5=65 An approved system may also be used. - Keep system maximum feasible distance from well, not less than 50' - Install lines on contour as shown

Comments:/Conditions:

INITIAL SITE SKETCH

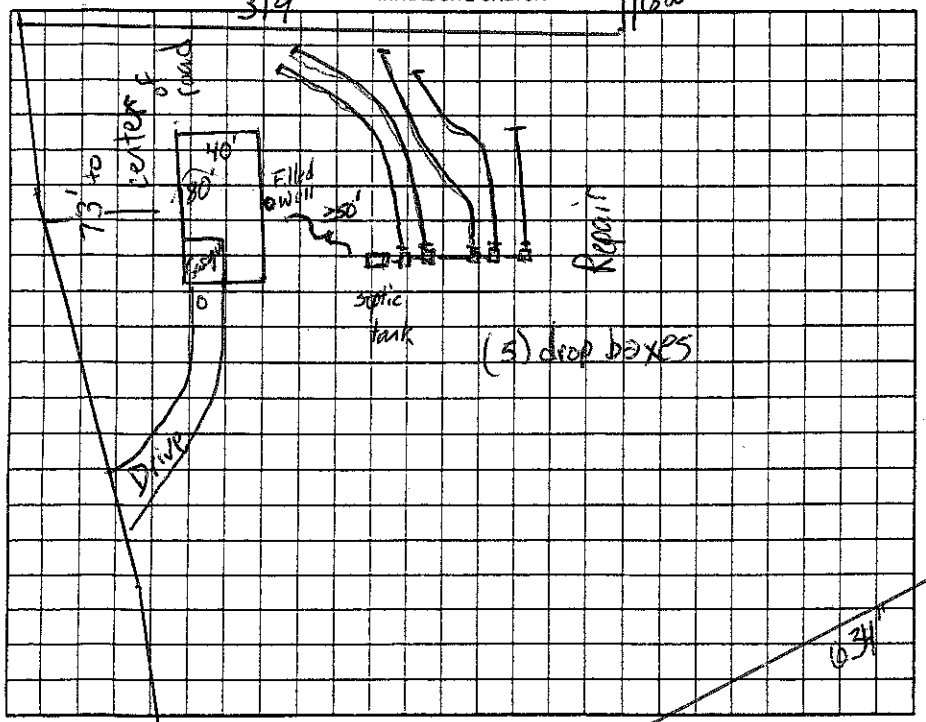

AS BUILT SKETCH

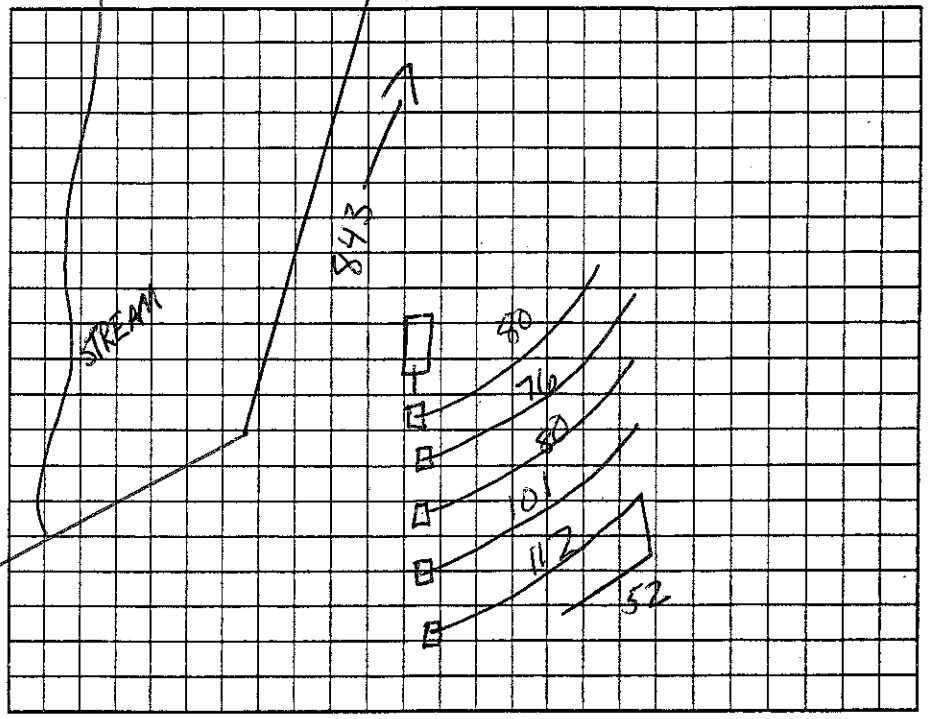

Permit can be suspended or revoked if any false information is supplied toward securing the permit/any unauthorized changes are made to the site/any unauthorized changes are made in the installation of the system. Improvement Permit with plat valid without expiration ☐ Improvement Permit with site plan valid for sixty months ☐ Authorization to Construct is valid for a period equal to that of Improvement Permit – not to exceed sixty months.

Signed: date 11-28-06 Installed by: Dennis Galliher

Improvement Permit by: date 11-28-06 Operation Permit by: date 1-24-07

Authorization to Construct by: date 11-28-06 Existing System Inspection by: date

HEALTH DEPT. COPY: WHITE OWNER COPY (FINAL): YELLOW OWNER COPY (INITIAL): PINK