IREDELL COUNTY HEALTH DEPARTMENT

STATESVILLE 704-878-5305 (CALLED IN) MOORESVILLE 704-664-5281

IMPROVEMENT PERMIT / AUTHORIZATION TO CONSTRUCT / OPERATION PERMIT / EXISTING SYSTEM INSPECTION

PERMIT# 127101 PIN# 4749-88-1763 DATE 6-22-05

OWNER OR CONTRACTOR MARK ELLIS PHONE: Business 704-902-7576 Home

ADDRESS 110 DOE TRAIL STATESVILLE NC 28625

LOCATION US 21 N. TO JENNINGS ROAD, ON LEFT AT LOT #7 JUST PAST RAIDER ROAD.

SUBDIVISION RAIDER HEIGHTS BLOCK / SECTION LOT 7 LOT AREA 1.011 ACRES SITE CLASS PS DESIGN FLOW 360 L.T.A.R. 0.30 GPD/FT²

Septic Tank: 1000 Gallons; STB 312 Date 11-6-05

Pump Tank: Gallons; PT Date

Pump Make: Model Serial No.

Nitrification Field: No. Fields 1 Square Feet 1200 Linear Feet 400

No. Lines Four Trench Width 36" Max Trench Bottom Depth 36" Gravel Depth 12"

☑ New System ☐ Repair System Type: I (II) III, IV, V, VI

System Description: CONVENTIONAL, GRAVITY

Repair System Description: CONVENTIONAL, GRAVITY

Maintenance Agreement Required: ☐ Yes ☑ No

☑ House/Mod. Home No. Bedrooms

☐ Mobile Home No. Bathrooms

☐ Business No. Employees

☐ Other


☐ Slab ☑ Crawl Space ☐ Basement w/plumbing ☐ Basement wo/plumbing

Water Supply: ☐ Individual ☑ Public ☐ Community


Comments:/Conditions: INSTALL LINES ON CONTOUR AS FLAGGED ON SITE

Comments:/Conditions: Red Filter Tank w/ risers w/ST Riser

INITIAL SITE SKETCH

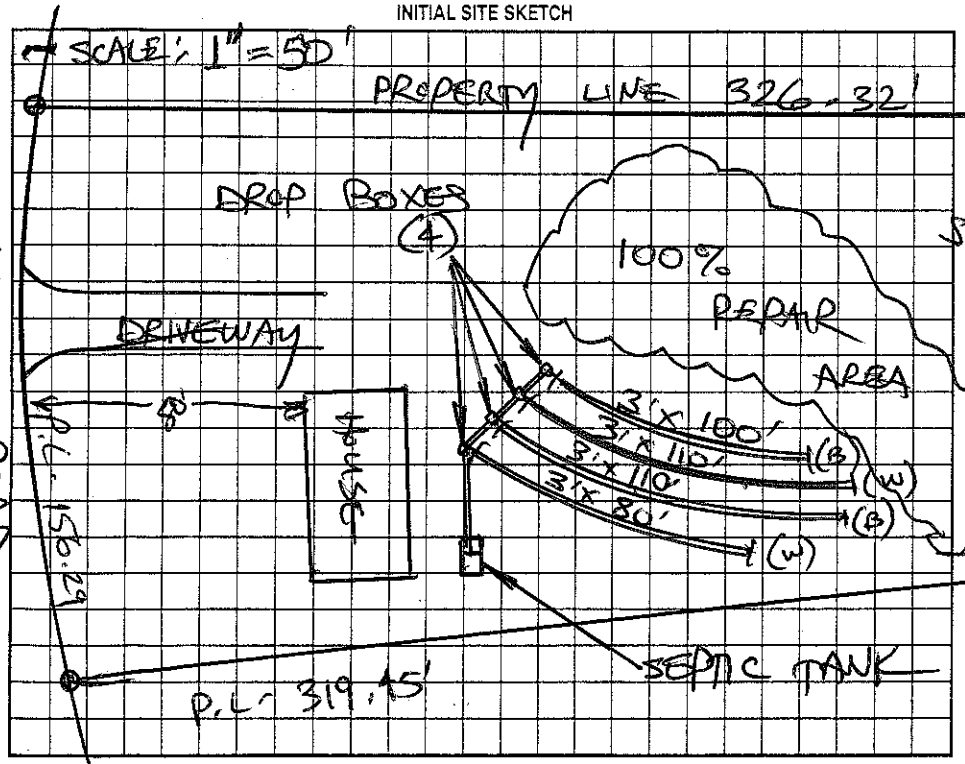

AS BUILT SKETCH

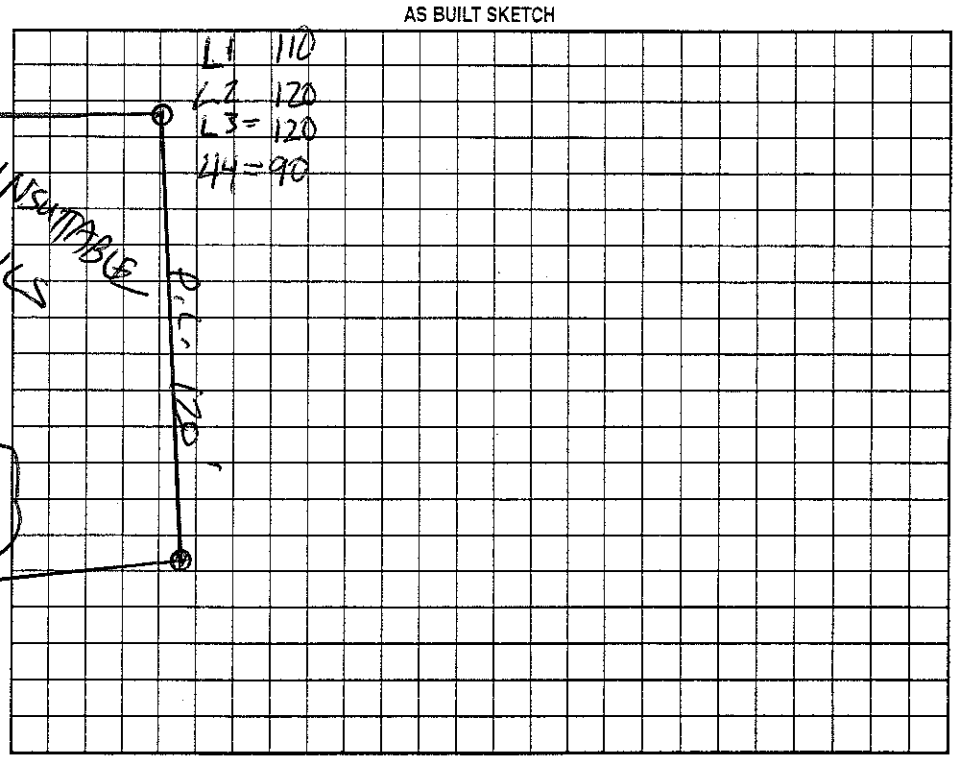

Permit can be suspended or revoked if any false information is supplied toward securing the permit/any unauthorized changes are made to the site/any unauthorized changes are made in the installation of the system. Improvement Permit with plat valid without expiration. Improvement Permit with site plan valid for sixty months. Authorization to Construct is valid for a period equal to that of Improvement Permit – not to exceed sixty months.

Signed: X Mark Ellis date 6-22-05 Installed by: Wes Lytton

Improvement Permit by: STEVE HEDRICK date 6-22-05 Operation Permit by: James Owen date 1-6-05

Authorization to Construct by: STEVE HEDRICK date 6-22-05 Existing System Inspection by: date

HEALTH DEPT. COPY: WHITE OWNER COPY (FINAL): YELLOW OWNER COPY (INITIAL): PINK