IREDELL COUNTY HEALTH DEPARTMENT

STATESVILLE 704-878-5305 MOORESVILLE 704-664-5281

IMPROVEMENT PERMIT / AUTHORIZATION TO CONSTRUCT / OPERATION PERMIT / EXISTING SYSTEM INSPECTION

PERMIT# 0860732 PIN# 4749 78 9596 (PT) DATE 1-4-00

OWNER OR CONTRACTOR ALLEN NORRIS PHONE: Business Home

ADDRESS 136 OAKDALE LANE, LEXINGTON, NC 27295

LOCATION US 21 N, TL JENNINGS RD, LT ON LEFT AT RAIDER ROAD NW CORNER

SUBDIVISION BLOCK / SECTION LOT LOT AREA 3.00 ACRES SITE CLASS PS DESIGN FLOW 360 L.T.A.R. 0.20 GPD/FT2

Septic Tank: 1000 Gallons: STB 1012 Date 10-14-99
Pump Tank: Gallons; PT Date
Pump Make: Model Serial No.
Nitrification Field: No. Fields 1 Square Feet 1800 Linear Feet 600
No. Lines SIX Trench Width 36" Max Trench Bottom Depth 30" Gravel Depth 12"

☑ New System ☐ Repair System Type: (I) II, III, IV, V, VI
System Description: CONVENTIONAL GRAVITY
Repair System Description: CONV. GRAVITY
Maintenance Agreement Required: ☐ Yes ☑ No
☐ Slab ☑ Crawl Space ☐ Basement w/plumbing ☐ Basement wo/plumbing


☐ House/Mod. Home No. Bedrooms 3
☑ Mobile Home No. Bathrooms 2
☐ Business No. Employees
☐ Other

Water Supply: ☐ Individual ☑ Public ☐ Community

Comments/Conditions: ① INSTALL SUBSURFACE INTERCEPT DRAINAGE DITCH AS SHOWN BEGINNING 42" DEEP OUT TO DAYLIGHT ② USE ONE FLOW DIVIDER TEE TO ACHIEVE EQUAL DISTRIBUTION INTO TWO DIST. BOXES FEEDING THREE LINES EACH

Comments/Conditions: SEPTIC TANK W/ RISERS INSTALLED USING "POLY LOK" FILTER

INITIAL SITE SKETCH

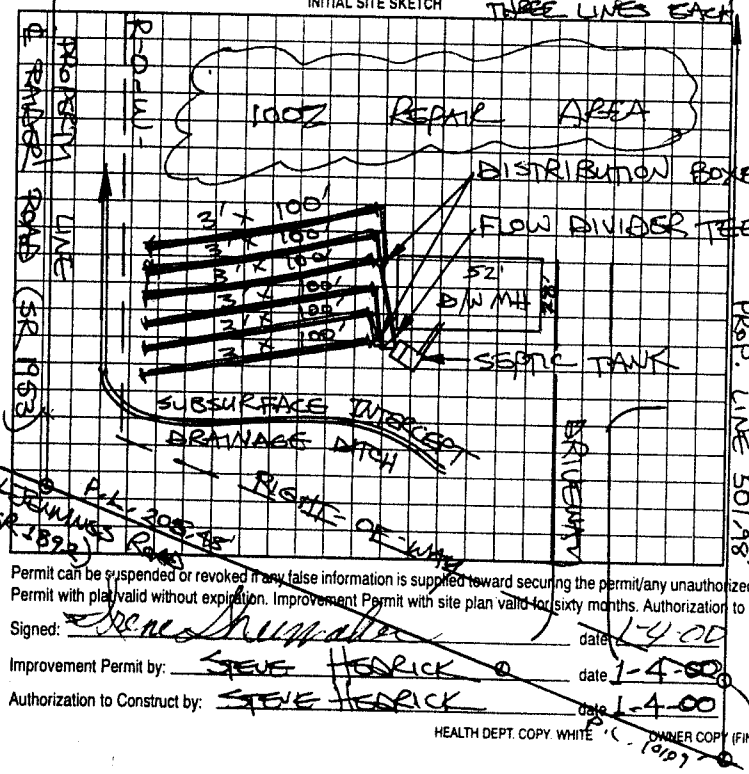

AS BUILT SKETCH

SYSTEM INSTALLED ACCORDING TO INITIAL SITE SKETCH

Permit can be suspended or revoked if any false information is supplied toward securing the permit/any unauthorized changes are made to the site/any unauthorized changes are made in the installation of the system. Improvement Permit with plat valid without expiration. Improvement Permit with site plan valid for sixty months. Authorization to Construct is valid for a period equal to that of Improvement Permit - not to exceed sixty months.

Signed: Irene Shumpert date 1-4-00

Improvement Permit by: STEVE HEDRICK date 1-4-00

Authorization to Construct by: STEVE HEDRICK date 1-4-00

Installed by: STEVE JORDAN

Operation Permit by: STEVE HEDRICK date 2-8-00

Existing System Inspection by: date

HEALTH DEPT. COPY: WHITE OWNER COPY (FINAL): YELLOW OWNER COPY (INITIAL): PINK