IREDELL COUNTY HEALTH DEPARTMENT

STATESVILLE 704-878-5305 MOORESVILLE 704-664-5281

IMPROVEMENT PERMIT / AUTHORIZATION TO CONSTRUCT / OPERATION PERMIT / EXISTING SYSTEM INSPECTION

PERMIT# REPAIR PIN# 4749-93-0601 DATE 6-2-05

OWNER OR CONTRACTOR RAY TOMLIN PHONE: Business Home (704) 876-4298

ADDRESS 1051 TOMLIN MILL RD STATESVILLE NC 28625

LOCATION I-77N TL TOMLIN MILL RD. FIRST HOUSE ON LEFT BESIDE TOMLIN MILL ONE STOP

SUBDIVISION BLOCK / SECTION LOT LOT AREA AMPLE SITE CLASS. PS DESIGN FLOW 240 L.T.A.R. UPGRADED TO 0.30 GPD/FT²

Septic Tank: EXISTING Gallons: STB Date

Pump Tank: Gallons: PT Date

Pump Make: Model Serial No.

Nitrification Field: No Fields 1 Square Feet APPROX 800FT² Linear Feet 125'

No Lines (3) THREE Trench Width 36" Max Trench Bottom Depth 36" Gravel Depth 12"

☐ New System ☑ Repair System Type: I, (II), III, IV, V, VI

System Description:

Repair System Description: CONVENTIONAL GRAVITY

Maintenance Agreement Required: ☐ Yes ☑ No

☑ House/Mod. Home No. Bedrooms 2

☐ Mobile Home No. Bathrooms

☐ Business No. Employees

☐ Other


☐ Slab ☑ Crawl Space ☐ Basement w/plumbing ☐ Basement wo/plumbing

Water Supply: ☐ Individual ☑ Public ☐ Community

Comments:/Conditions: (1) MUST REMOVE EXISTING SEPTIC LINES CROSSING NEIGHBORING PROPERTY TO TEN FEET FROM EXISTING PROPERTY LINE (2) INSTALL REPAIR LINES ON CONTOUR (3) MAINTAIN 50' SETBACK FROM EXISTING WELL (4) PUMP OUT ~~SEPTIC~~ EXISTING TANK

Comments:/Conditions:

INITIAL SITE SKETCH

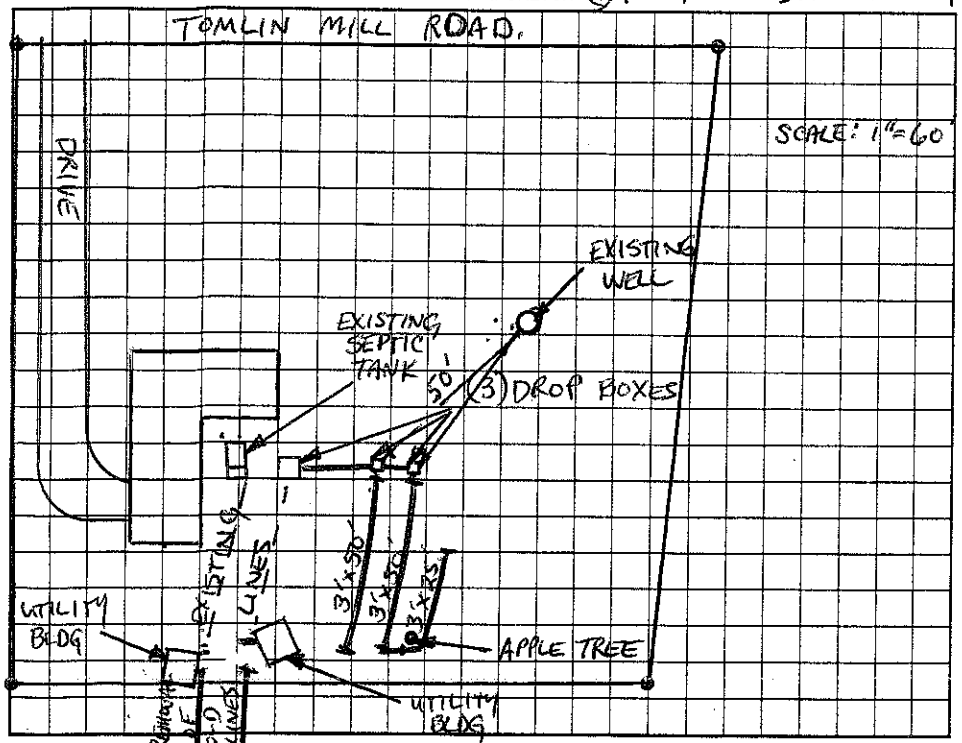

AS BUILT SKETCH

SYSTEM RELOCATED ACCORDING TO INITAL SITE SKETCH

Permit can be suspended or revoked if any false information is supplied toward securing the permit/any unauthorized changes are made to the site/any unauthorized changes are made in the installation of the system. Improvement Permit with plat valid without expiration/ Improvement Permit with site plan valid for sixty months. Authorization to Construct is valid for a period equal to that of Improvement Permit – not to exceed sixty months.

Signed: Mrs Ray Tomlin date

Improvement Permit by: Christopher M. Merrill, RS, LSS date 6-2-05

Authorization to Construct by: Christopher M. Merrill, RS, LSS date 6-2-05

Installed by: ANDY DANIELS

Operation Permit by: STEVE FEDRICK date 6-14-05

Existing System Inspection by: date

HEALTH DEPT. COPY: WHITE OWNER COPY (FINAL): YELLOW OWNER COPY (INITIAL): PINK