IREDELL COUNTY HEALTH DEPARTMENT

STATESVILLE 704-878-5305 MOORESVILLE 704-664-5281

IMPROVEMENT PERMIT / AUTHORIZATION TO CONSTRUCT / OPERATION PERMIT / EXISTING SYSTEM INSPECTION

PERMIT# 124952 PIN# ~~4749-93-3925~~ 4748-49-5345 DATE 11-5-04

OWNER OR CONTRACTOR GERALD GRANT & ASSOCIATES PHONE: Business 704-872-3136 Home

ADDRESS P.O. Box 268 STATESVILLE NC 28677

LOCATION STATESVILLE, NC TO I-77 NORTH, TL TOMLIN MILL ROAD, ON RIGHT JUST PAST LENTZ ROAD

SUBDIVISION BLOCK / SECTION LOT LOT AREA 5.898 ACRES SITE CLASS. PS DESIGN FLOW 300 L.T.A.R. 0.25 GPD/FT2

Septic Tank: 1000 Gallons; STB 1007 Date 5-21-03

Pump Tank: Gallons; PT Date

Pump Make: Model EQ TO Serial No. EQ TO 400

Nitrification Field: No Fields 1 Square Feet 1200 Linear Feet

No Lines SIX Trench Width 36" Max Trench Bottom Depth 36" Gravel Depth 12"

☐ New System ☐ Repair System Type: I (II) III, IV, V, VI

System Description: CONVENTIONAL, GRAVITY

Repair System Description: 50% REDUCTION, LOW PRESSURE

Maintenance Agreement Required: ☐ Yes ☑ No

☐ House/Mod. Home No. Bedrooms

☐ Mobile Home No. Bathrooms

☑ Business No. Employees 12

☐ Other


☑ Slab ☐ Crawl Space ☐ Basement w/plumbing ☐ Basement wo/plumbing

Water Supply: ☐ Individual ☑ Public ☐ Community


Comments:/Conditions:

Comments:/Conditions:
BULK BINS

INITIAL SITE SKETCH

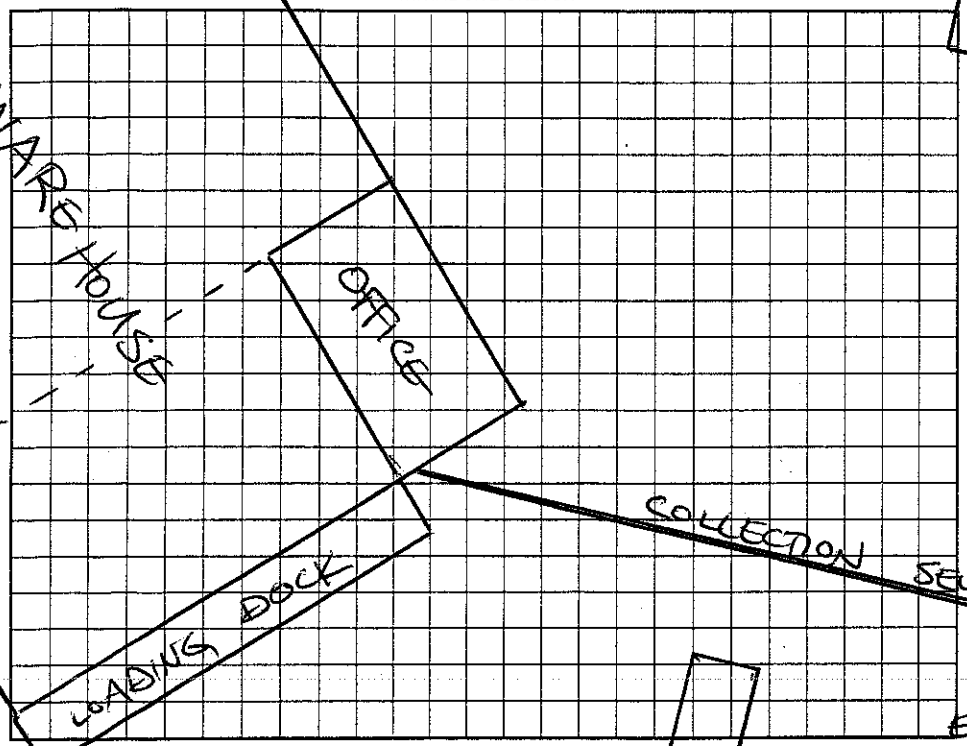

AS BUILT SKETCH

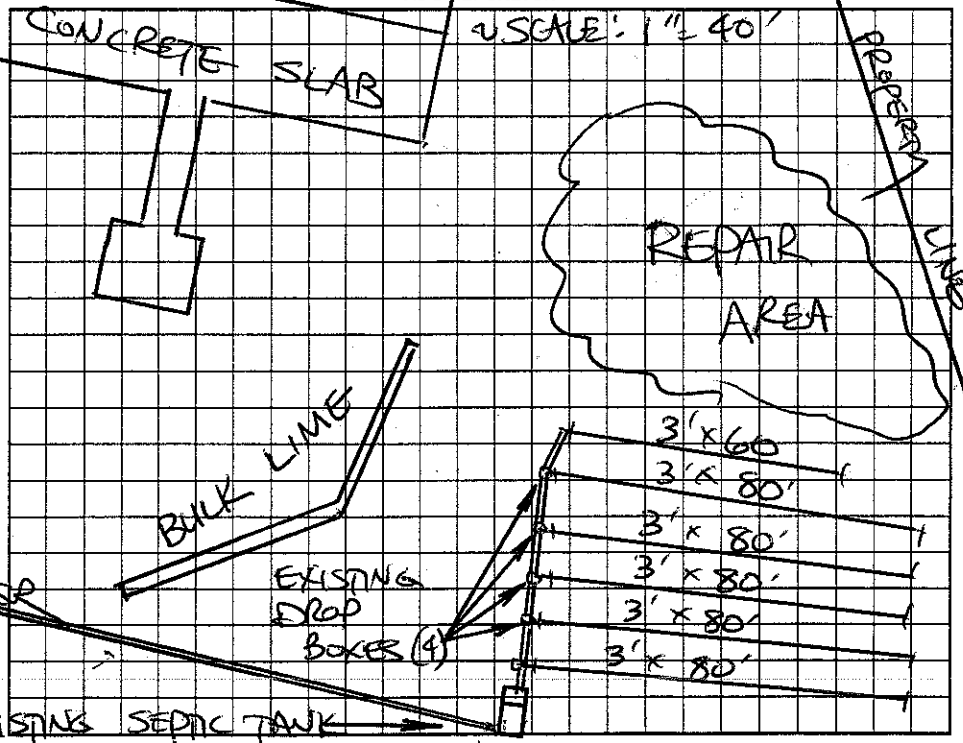

Permit can be suspended or revoked if any false information is supplied toward securing the permit/any unauthorized changes are made to the site/any unauthorized changes are made in the installation of the system. Improvement Permit with plat valid without expiration. Improvement Permit with site plan valid for sixty months. Authorization to Construct is valid for a period equal to that of Improvement Permit – not to exceed sixty months.

Signed: date Installed by:

Improvement Permit by: date Operation Permit by: date

Authorization to Construct by: date Existing System Inspection by: STEVE HENDRICK date 11-5-04

HEALTH DEPT COPY: WHITE OWNER COPY (FINAL): YELLOW OWNER COPY (INITIAL): PINK