IREDELL COUNTY HEALTH DEPARTMENT

THIS PERMIT REPLACES PERMIT # 111323

STATESVILLE 704-878-5305 MOORESVILLE 704-664-5281

IMPROVEMENT PERMIT / AUTHORIZATION TO CONSTRUCT / OPERATION PERMIT / EXISTING SYSTEM INSPECTION

PERMIT# RELOCATION 12495 RIN# 4749-93-3925 45022 DATE 11-5-04

OWNER OR CONTRACTOR PIEDMONT FARM SYSTEMS PHONE: Business ~~704-873-0659~~ Home 704-876-4423

ADDRESS 1020 TOMLIN MILL ROAD, STATESVILLE

LOCATION I-77 N, TL TOMLIN MILL ROAD, TRACT ON RIGHT JUST PAST LENTZ ROAD

SUBDIVISION _____ BLOCK / SECTION _____ LOT _____ LOT AREA 5.898 ACRES SITE CLASS. PS DESIGN FLOW 300 L.T.A.R. 0.30 GPD/FT2

Septic Tank: 1000 Gallons; STB 1012 Date 9-28-04
Pump Tank: _____ Gallons; PT _____ Date _____
Pump Make: _____ Model _____ Serial No. _____
Nitrification Field: No Fields 1 Square Feet 1000 Linear Feet 333'
No Lines FOUR Trench Width 36" Max Trench Bottom Depth 36" Gravel Depth 12"

☑ New System ☐ Repair System Type: I, II, III, IV, V, VI
System Description: CONVENTIONAL GRAVITY
Repair System Description: 50% REDUCTION, LOW-PRESSURE
Maintenance Agreement Required: ☐ Yes ☑ No


☐ House/Mod. Home No. Bedrooms ____
☐ Mobile Home No. Bathrooms ____
☑ Business No. Employees 12
☐ Other
☐ Slab ☐ Crawl Space ☐ Basement w/plumbing ☐ Basement wo/plumbing

Water Supply: ☐ Individual ☑ Public ☐ Community


Comments:/Conditions: RELOCATE SYSTEM AS SHOWN

Comments:/Conditions: ① SEPTIC TANK LOCATED AS SHOWN WITH PRIOR HEALTH DEPT. APPROVAL.
② SEPTIC TANK WITH MARKER INSTALLED
USING "INFILTE" FILTER

INITIAL SITE SKETCH

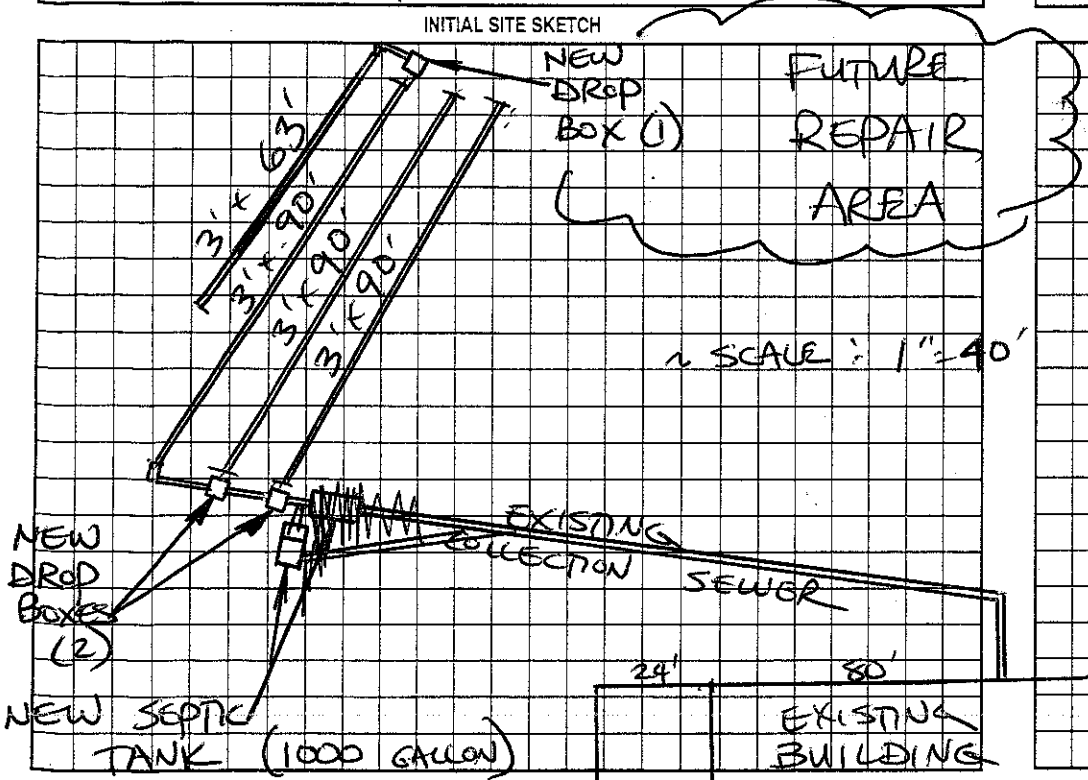

AS BUILT SKETCH

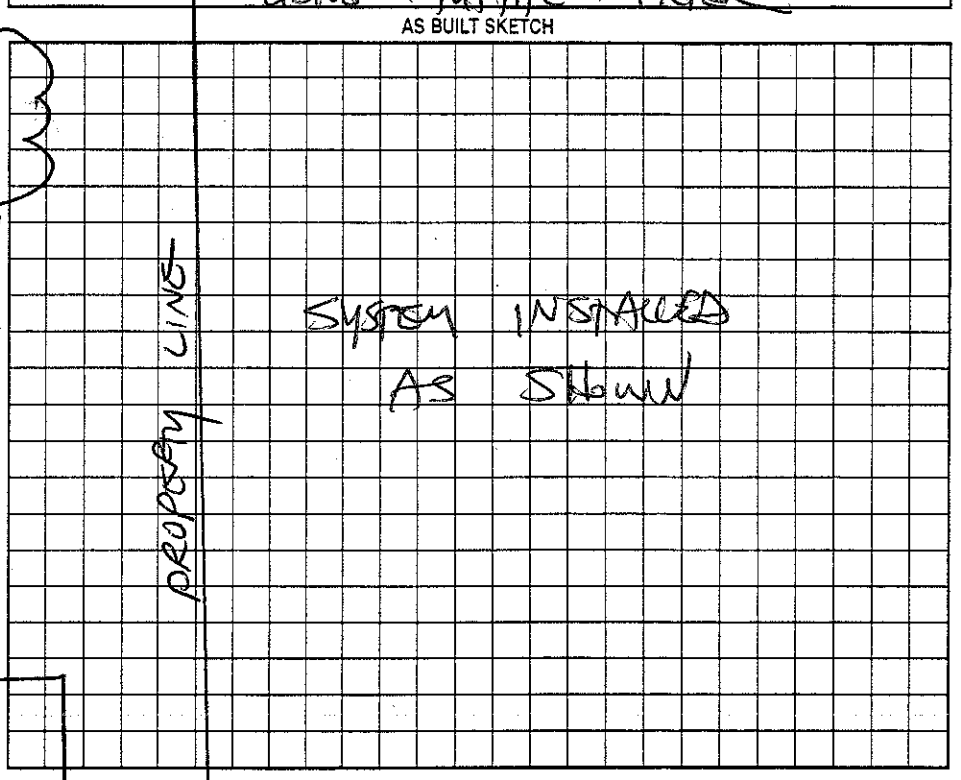

Permit can be suspended or revoked if any false information is supplied toward securing the permit/any unauthorized changes are made to the site/any unauthorized changes are made in the installation of the system. Improvement Permit with plat valid without expiration. Improvement Permit with site plan valid for sixty months. Authorization to Construct is valid for a period equal to that of Improvement Permit – not to exceed sixty months.

Signed: Donald Scott date 11-18-04 Installed by: PIEDMONT BACKHOE

Improvement Permit by: STEVE HENDRICK date 11-5-04 Operation Permit by: STEVE HENDRICK date 5-13-05

Authorization to Construct by: STEVE HENDRICK date 11-5-04 Existing System Inspection by: _____ date _____

HEALTH DEPT. COPY: WHITE OWNER COPY (FINAL): YELLOW OWNER COPY (INITIAL): PINK